


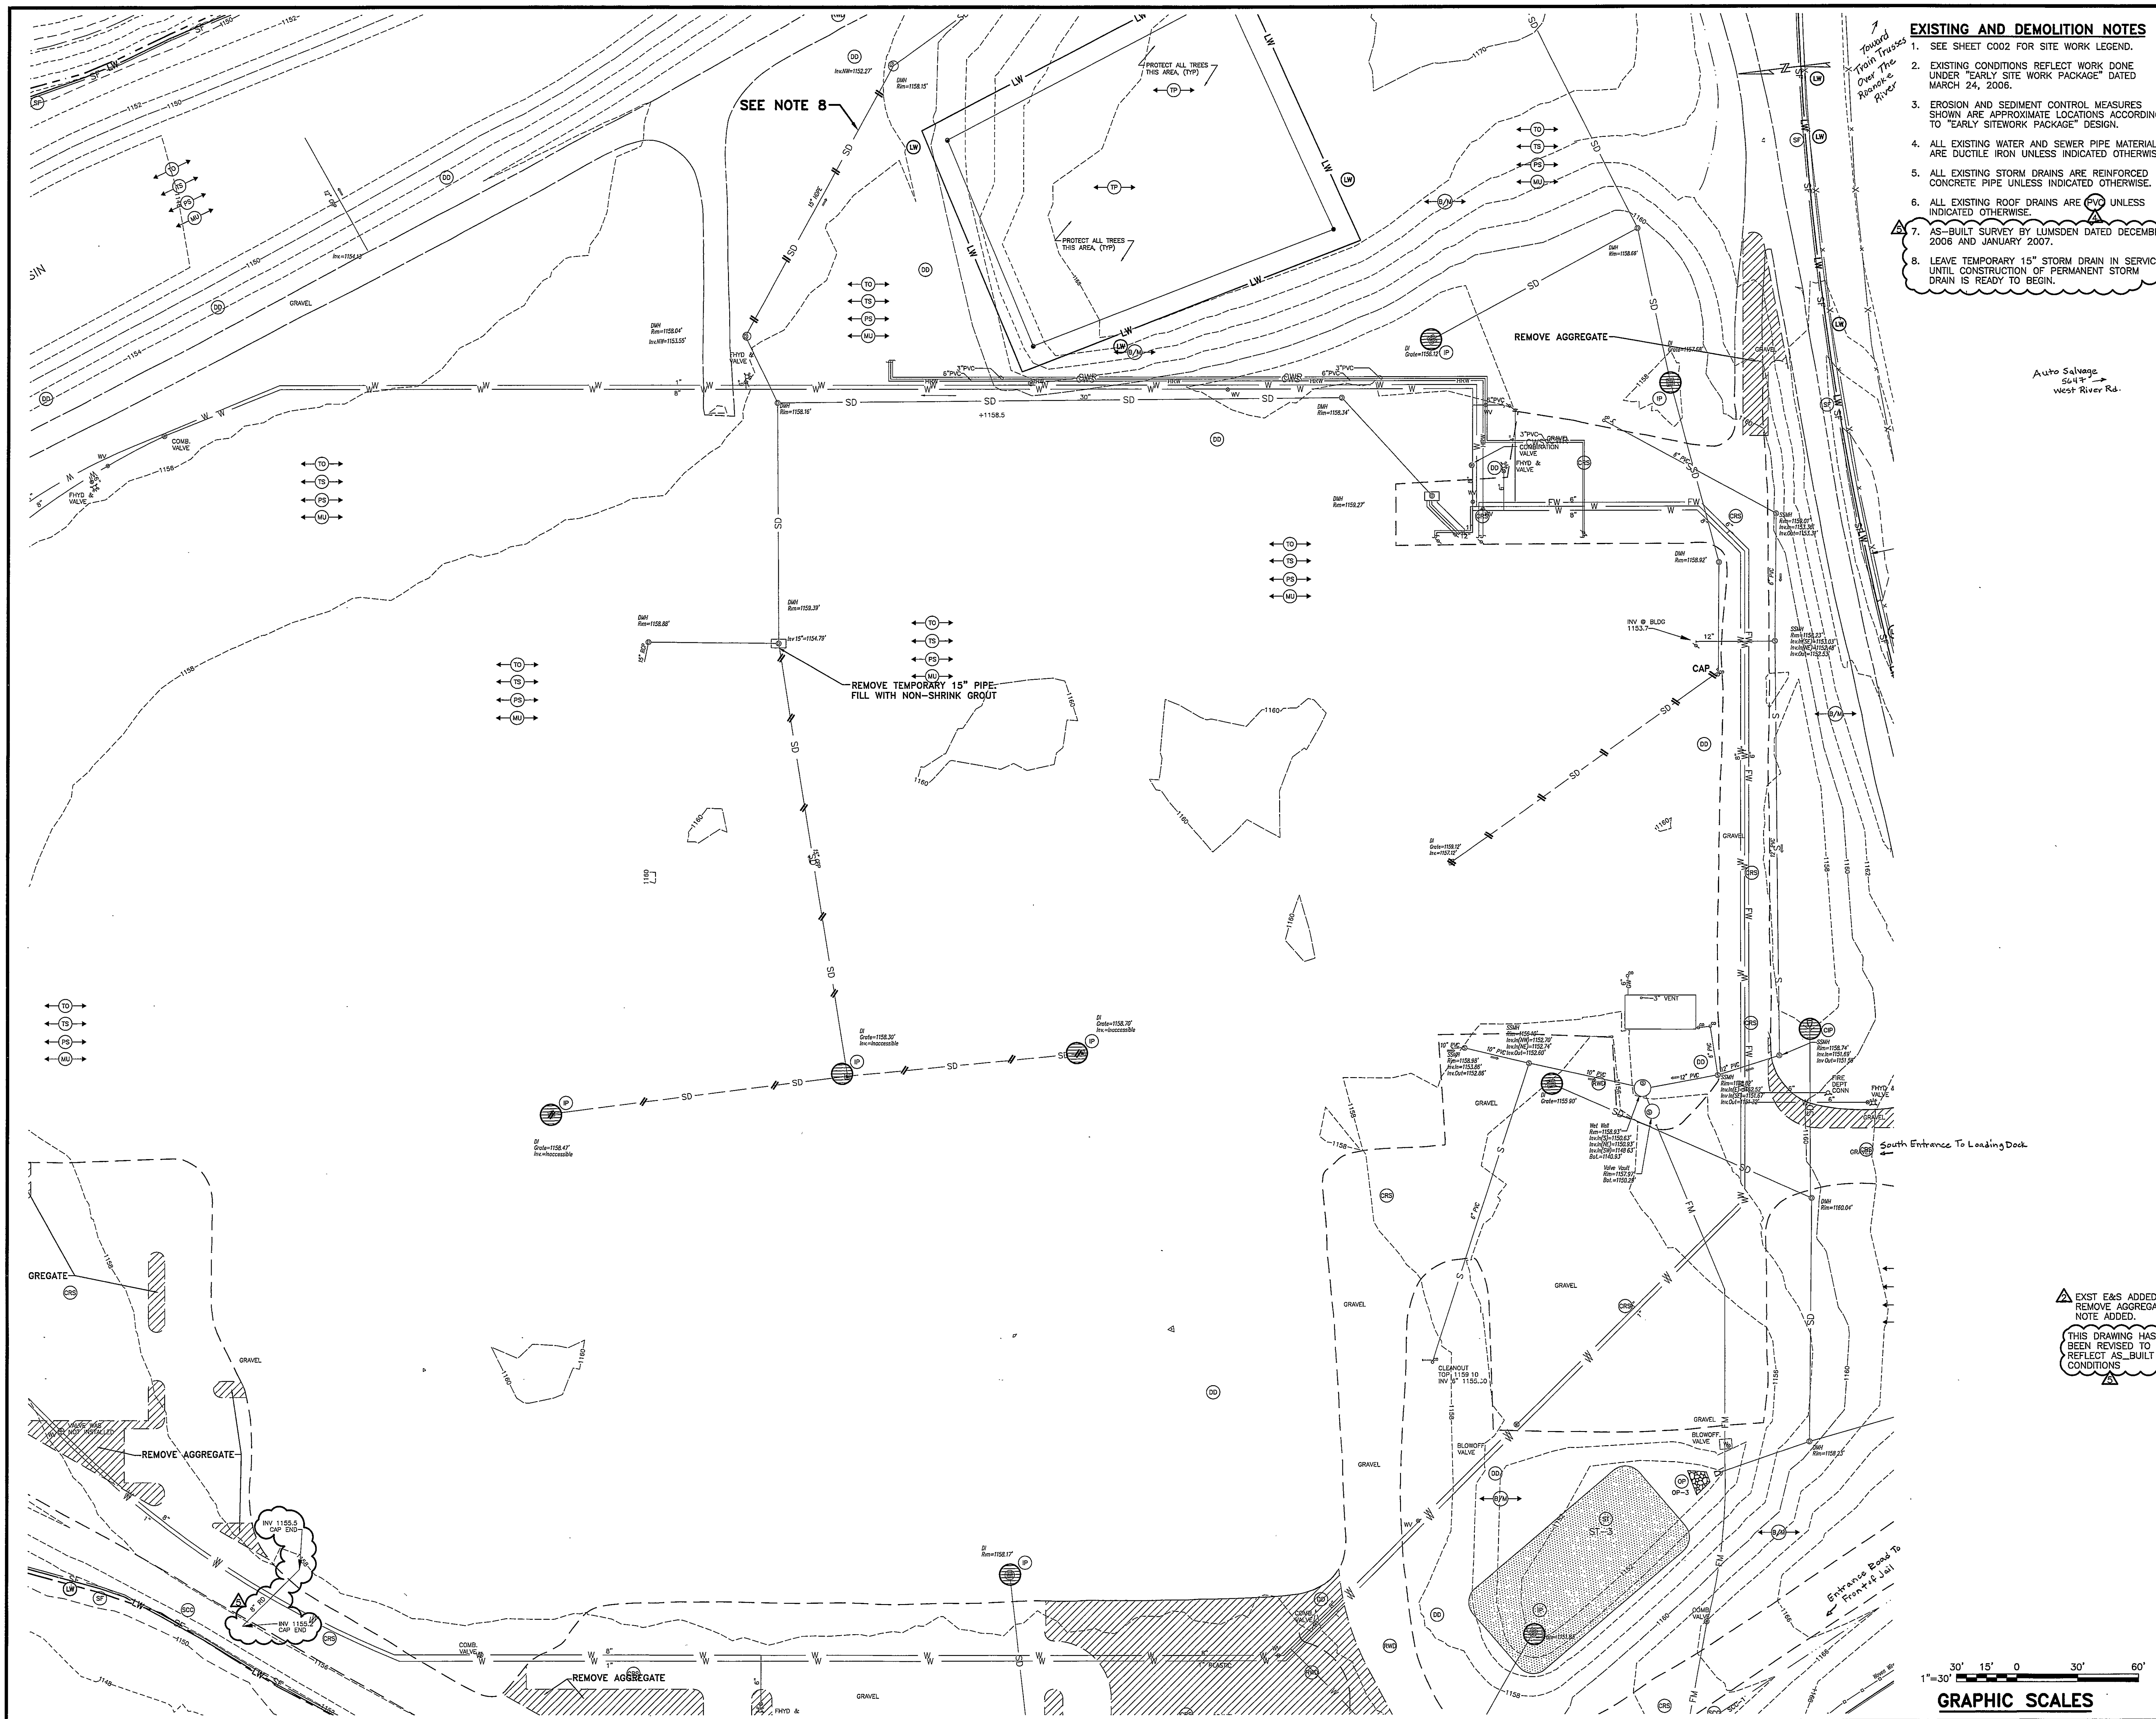


- ### EXISTING AND DEMOLITION NOTES
1. SEE SHEET C002 FOR SITE WORK LEGEND.
 2. EXISTING CONDITIONS REFLECT WORK DONE UNDER "EARLY SITE WORK PACKAGE" DATED MARCH 24, 2006.
 3. EROSION AND SEDIMENT CONTROL MEASURES SHOWN ARE APPROXIMATE LOCATIONS ACCORDING TO "EARLY SITEWORK PACKAGE" DESIGN.
 4. ALL EXISTING WATER AND SEWER PIPE MATERIALS ARE DUCTILE IRON UNLESS INDICATED OTHERWISE.
 5. ALL EXISTING STORM DRAINS ARE REINFORCED CONCRETE PIPE UNLESS INDICATED OTHERWISE.
 6. ALL EXISTING ROOF DRAINS ARE PVC UNLESS INDICATED OTHERWISE.
 7. AS-BUILT SURVEY BY LUMSDEN DATED DECEMBER 2006 AND JANUARY 2007.
 8. LEAVE TEMPORARY 15" STORM DRAIN IN SERVICE UNTIL CONSTRUCTION OF PERMANENT STORM DRAIN IS READY TO BEGIN.

Auto Salvage
5447
West River Rd.


HSMM

ARCHITECTS ENGINEERS PLANNERS

HAYES, SEAY, MATTERN & MATTERN, INC.
1315 FRANKLIN ROAD
ROANOKE, VA 24016
(540) 857-3100 WWW.HSMM.COM

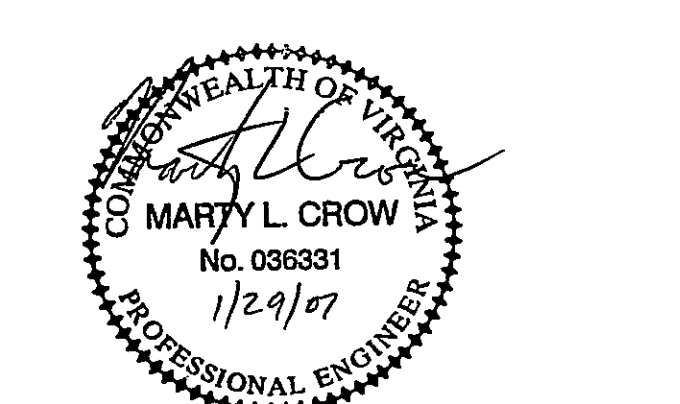

CONSULTANT

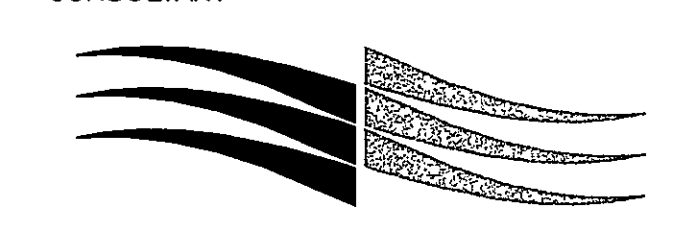

THOMPSON & LITTON
P.O. Box 1307
103 East Main Street
Wise, Virginia 24293

Rolf Jensen & Associates, Inc.
Life Safety Consultants
3040 Williams Drive, Suite 400
Fairfax, Virginia 22031

Faassen & Associates, Inc.
Food Service & Laundry Consultant
8526 Sunflower Court
Charlotte, NC 28227

David E. Musacchio & Associates
Security/Detention Consultant
Cookeville, Tennessee

WESTERN VIRGINIA REGIONAL JAIL

WESTERN VIRGINIA REGIONAL JAIL AUTHORITY
ROANOKE COUNTY, VIRGINIA


REV	DATE	DESCRIPTION	APP
2	10/16/06	ADDENDUM 2	JMC
4	11/14/06	REVIEW COMMENTS	JMC
5	01/29/07	GENERAL REVISIONS	JMC

COMM NO: 10075
ISSUE DATE: FEBRUARY 1, 2007
DESIGNED BY: SMS DRAWN BY: SMS
CHECKED BY: MLC SUBMITTED BY: JMC
© HAYES, SEAY, MATTERN & MATTERN, INC., 2005. ALL RIGHTS RESERVED.

CIVIL/SITE

EXIST CONDITIONS AND DEMO PLAN, BUILDING PAD

CD100

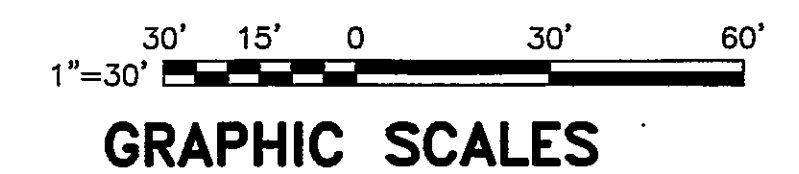

M:\1000SERIES\10075\CADD\DWG\F4C.D_0100.DWG 10075 01/28/2007 13:54:29 TERRY GUMP
HSMM-Full.ctb Rf: f4c_exsp00,f4c_dxsp00,f4cexsp00,f4cexsp00,f4cexsp00,f4cexsp00,f4cexsp00,f4cexsp00