NOTES THIS SHEET:

1. SEE SHEET C001 FOR SITE NOTES. SEE SHEET C002 FOR SITE LEGEND AND COORDINATE TABLE.
2. NEENAH R-4986-D WHEEL GUARD WITH EXTENSION. (4)

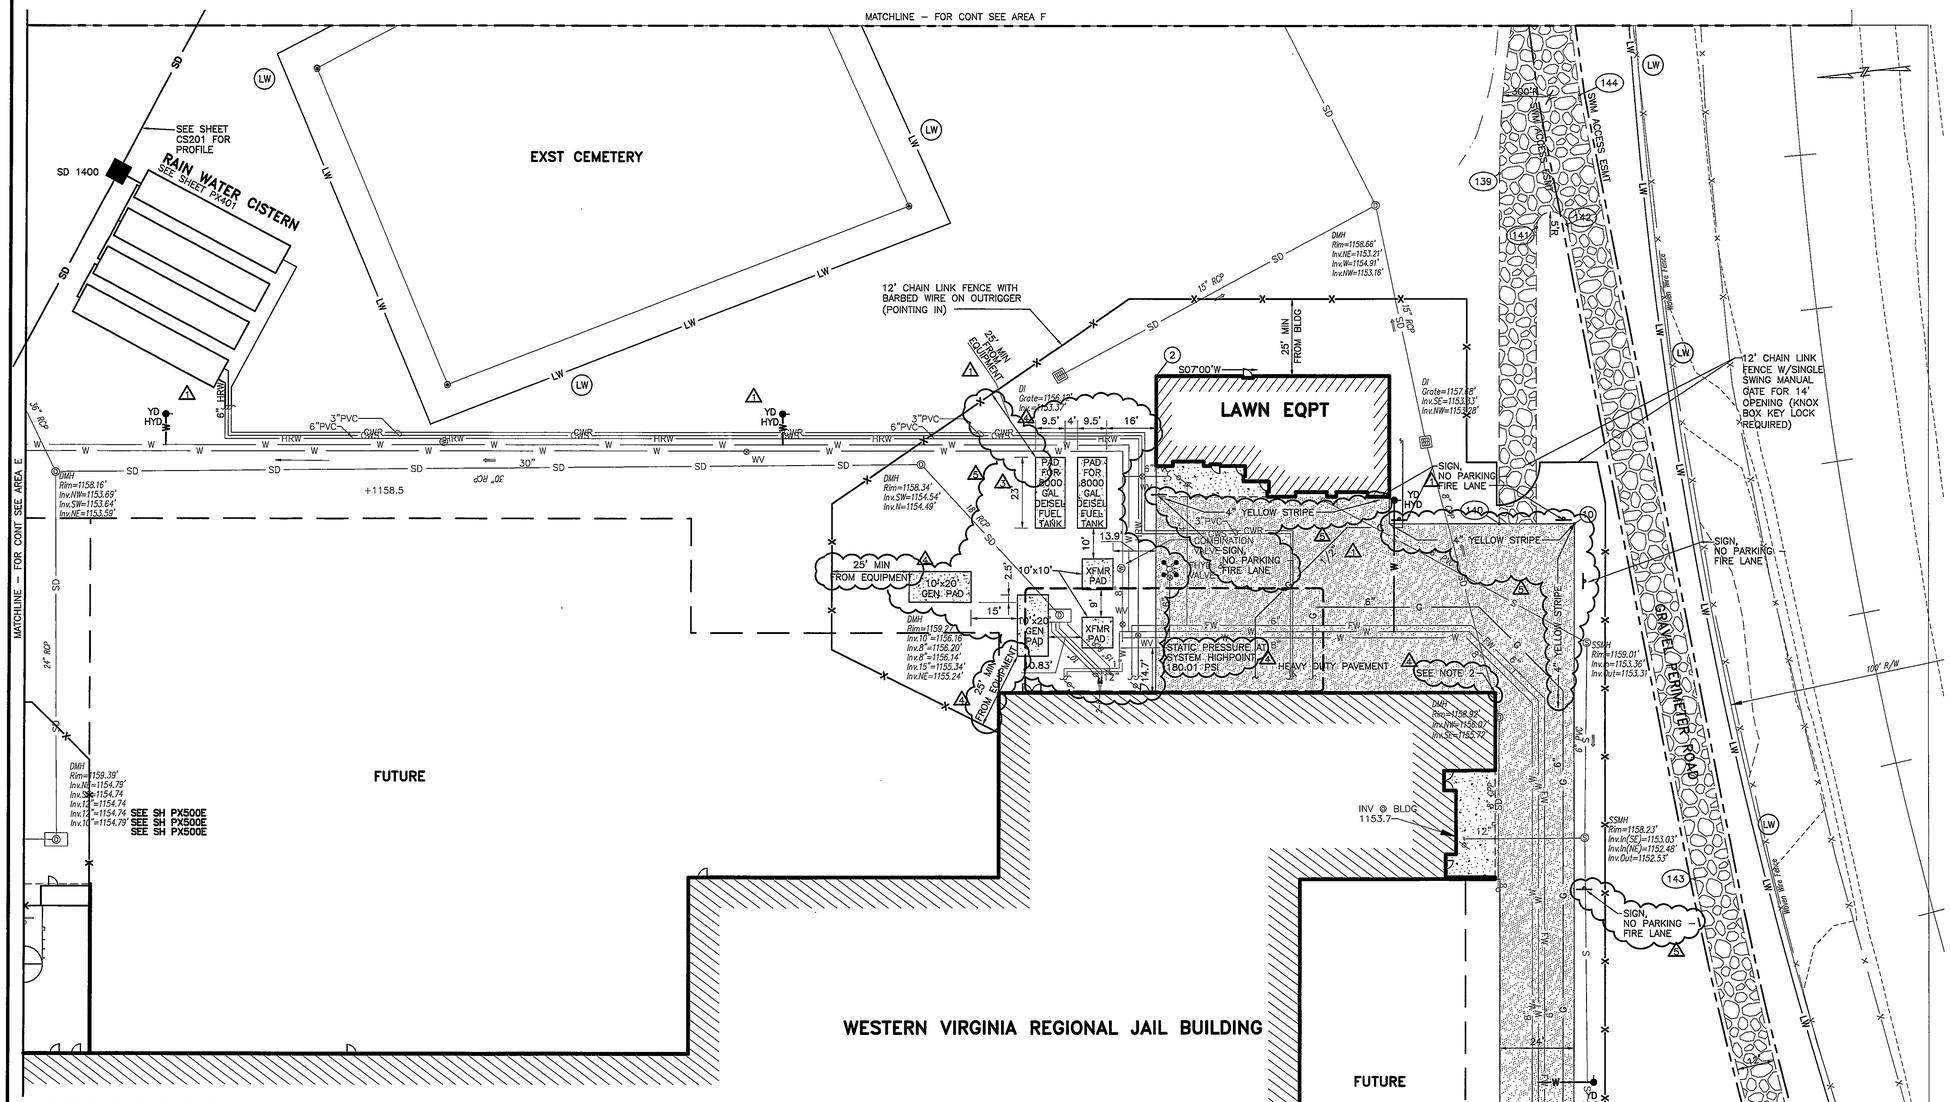

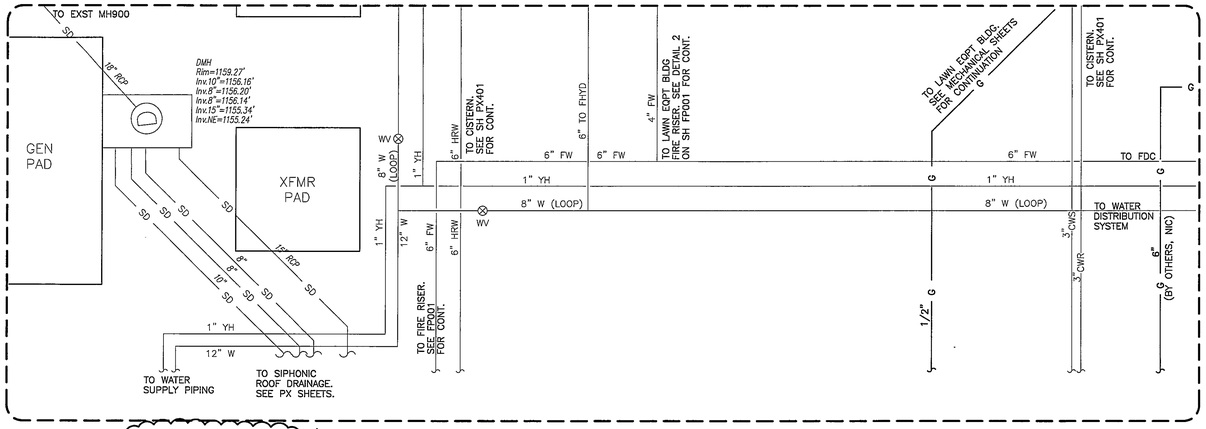

ENLARGED PLAN (5)
SCALE: 1"=5'

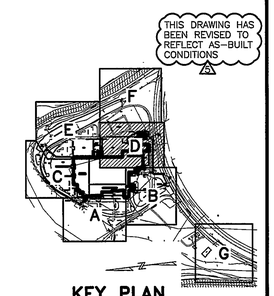

KEY PLAN

THIS DRAWING HAS BEEN REVISED TO REFLECT AS-BUILT CONDITIONS (5)

1"=5' 5' 0 5' 10'
1"=20' 20' 10' 0 20' 40'

GRAPHIC SCALES

HSMM

ARCHITECTS ENGINEERS PLANNERS

HAYES, SEAY, MATTERN & MATTERN, INC.
1315 FRANKLIN ROAD
ROANOKE, VA 24016
(540) 857-3100 WWW.HSMM.COM

SEALS

COMMONWEALTH OF VIRGINIA
MARTY L. CROW
No. 036331
1/29/07
PROFESSIONAL ENGINEER

CONSULTANT

THOMPSON & LITTON
P.O. Box 1307
103 East Main Street
Wise, Virginia 24293

Rolf Jensen & Associates, Inc.
Life Safety Consultants
3040 Williams Drive, Suite 400
Fairfax, Virginia 22031

Faassen & Associates, Inc.
Food Service & Laundry Consultant
8526 Sunflower Road
Charlotte, NC 28227

David E. Musacchio & Associates
Security/Detention Consultant
Cookeville, Tennessee

WESTERN VIRGINIA REGIONAL JAIL

WESTERN VIRGINIA REGIONAL JAIL AUTHORITY
ROANOKE COUNTY, VIRGINIA

REV	DATE	DESCRIPTION	APP

COMM NO: 10075
ISSUE DATE: FEBRUARY 1, 2007
DESIGNED BY: SMS DRAWN BY: SMS
CHECKED BY: MLC SUBMITTED BY: JMC

© HAYES, SEAY, MATTERN & MATTERN, INC., 2005. ALL RIGHTS RESERVED.

CIVIL

DIMENSIONAL LAYOUT AND UTILITY PLAN, AREA D

CS102D

M:\10000SERIES\10075\CADD\DWG\FJ4CSN_0102D.DWG 10075 01/29/2007 04:10:14 ANDY FREELAND
HSMM-Full.ctb RF: fj4gsnxmlD0,fj4c_exsp00,fj4csnxsp00,fj4clnxsp00,fj4cunxsp00,fj4c_exep00,fj4g_nxbrdr,fj4gsnxkeyp,fj4g_nxorws,NONE