## NOTES THIS SHEET:

1. SEE SHEET C001 FOR SITE NOTES. SEE SHEET C002 FOR SITE LEGEND AND COORDINATE TABLE.
2. CONTRACTOR SHALL ADJUST FINISHED GRADING UNDER PAVED SECTIONS IN ACCORDANCE WITH THE PAVEMENT CROSS SECTION DETAIL ON SHEET C501.
3. SEE SHEET CG103B FOR ENLARGEMENT AT LOADING DOCK.

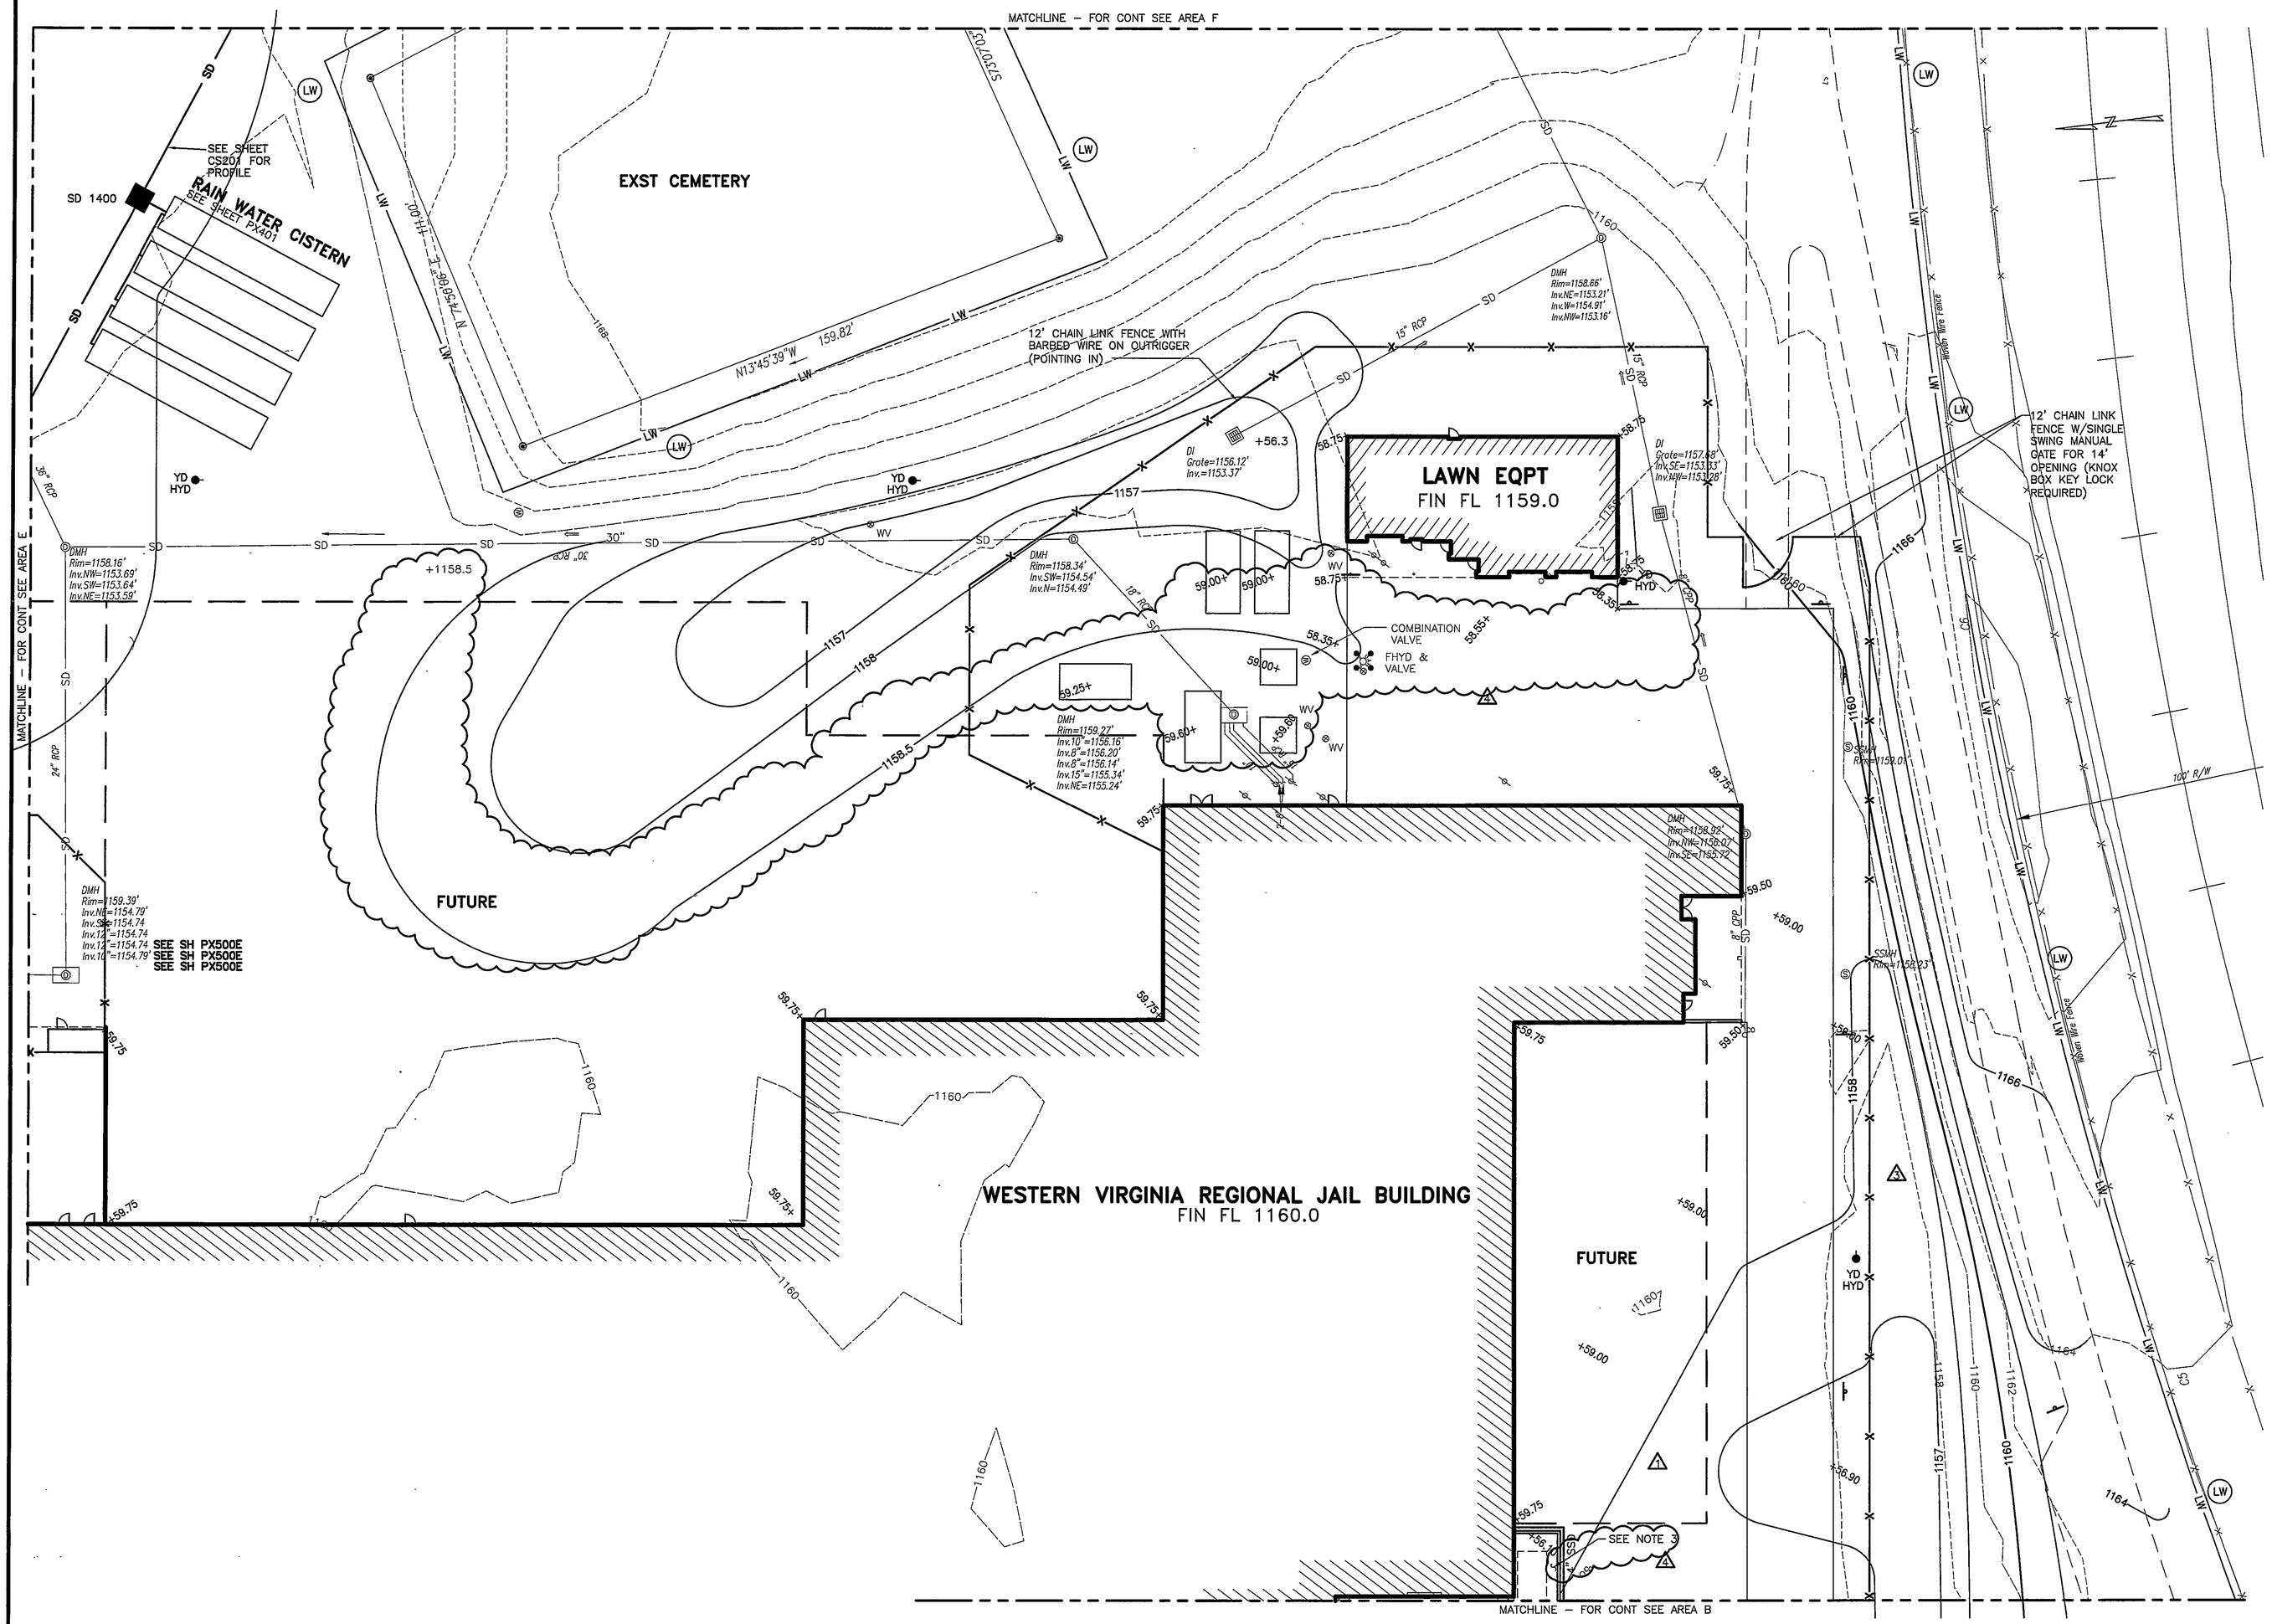


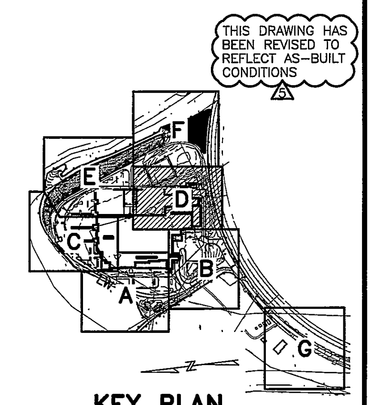


**KEY PLAN**

1"=20' 20' 10' 0 20' 40'

**GRAPHIC SCALES**

# HSMM

ARCHITECTS ENGINEERS PLANNERS


HAYES, SEAY, MATTERN & MATTERN, INC.
1315 FRANKLIN ROAD
ROANOKE, VA 24016
(540) 857-3100 WWW.HSMM.COM


SEALS

COMMONWEALTH OF VIRGINIA
MARTY L. CROW
No. 036331
1/29/07
PROFESSIONAL ENGINEER

CONSULTANT

THOMPSON & LITTON
P.O. Box 1307
103 East Main Street
Wise, Virginia 24293

**Rolf Jensen & Associates, Inc.**
Life Safety Consultants
3040 Williams Drive, Suite 400
Fairfax, Virginia 22031

**Faassen & Associates, Inc.**
Food Service & Laundry Consultant
8526 Sunflower Road
Charlotte, NC 28227

**David E. Musacchio & Associates**
Security/Detention Consultant
Cookeville, Tennessee

## WESTERN VIRGINIA REGIONAL JAIL

WESTERN VIRGINIA REGIONAL JAIL AUTHORITY
ROANOKE COUNTY, VIRGINIA

| REV | DATE | DESCRIPTION | APP |
|---|---|---|---|
| 1 | 10/02/06 | ADDENDUM 1 | JMC |
| | | | |
| 3 | 10/24/06 | ADDENDUM 3 | JMC |
| 4 | 11/14/06 | REVIEW COMMENTS | JMC |
| 5 | 01/29/07 | GENERAL REVISIONS | JMC |

COMM. NO: 10075
ISSUE DATE: FEBRUARY 1, 2007
DESIGNED BY: SMS DRAWN BY: SMS
CHECKED BY: MLC SUBMITTED BY: JMC


© HAYES, SEAY, MATTERN & MATTERN, INC., 2005. ALL RIGHTS RESERVED.


CIVIL

GRADING AND DRAINAGE PLAN, AREA D

# CG103D


M:\100000SERIES\10075\CADD\DWG\FJ4CGN_0103D.DWG 10075 01/29/2007 05:57:51 ANDY FREELAND
HSMM-Full.ctb RF: fj4gsnxml00,fj4c__exsp00,fj4csnxsp00,fj4cunxsp00,fj4cgnxsp00,fj4g__nxbrdr,fj4gsnxkeyp,fj4g__nxorws,NONE