



ARCHITECTS ENGINEERS PLANNERS

SEALS

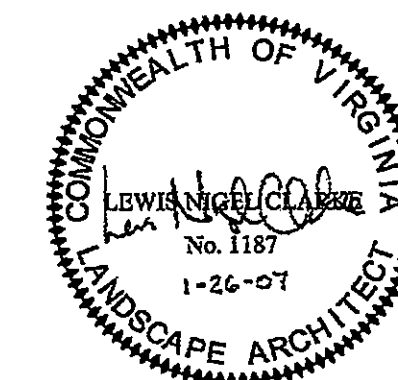

CONSULTANT

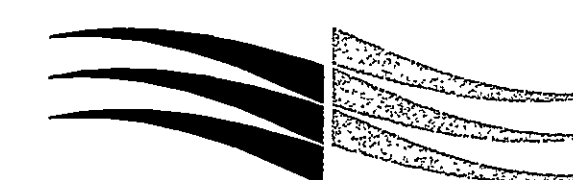

THOMPSON & LITTON

P.O. Box 1307
103 East Main Street
Wise, Virginia 24293

Jensen & Associate
Life Safety Consultants
3040 Williams Drive, Suite 400
Fairfax, Virginia 22031

Food Service & Laundry Consultant
8526 Sunflower Road
Charlotte, NC 28227

Security/Detention Consultant
Cookeville, Tennessee

WESTERN VIRGINIA
REGIONAL JAIL AUTHORITY
ROANOKE COUNTY, VIRGINIA


REV	DATE	DESCRIPTION	APP
1	10/02/06	ADDENDUM 1	JMC
4	11/14/06	REVIEW COMMENTS	JMC
5	01/29/07	GENERAL REVISIONS	JMC

COMM NO: 10075
ISSUE DATE: FEBRUARY 1, 2007
DESIGNED BY: RBC DRAWN BY: RBC
CHECKED BY: RJH SUBMITTED BY:
© HAYES, SEAY, MATTERN & MATTERN, INC.,
2005. ALL RIGHTS RESERVED.

LAND PLANNING

LANDSCAPE PLAN

LP101

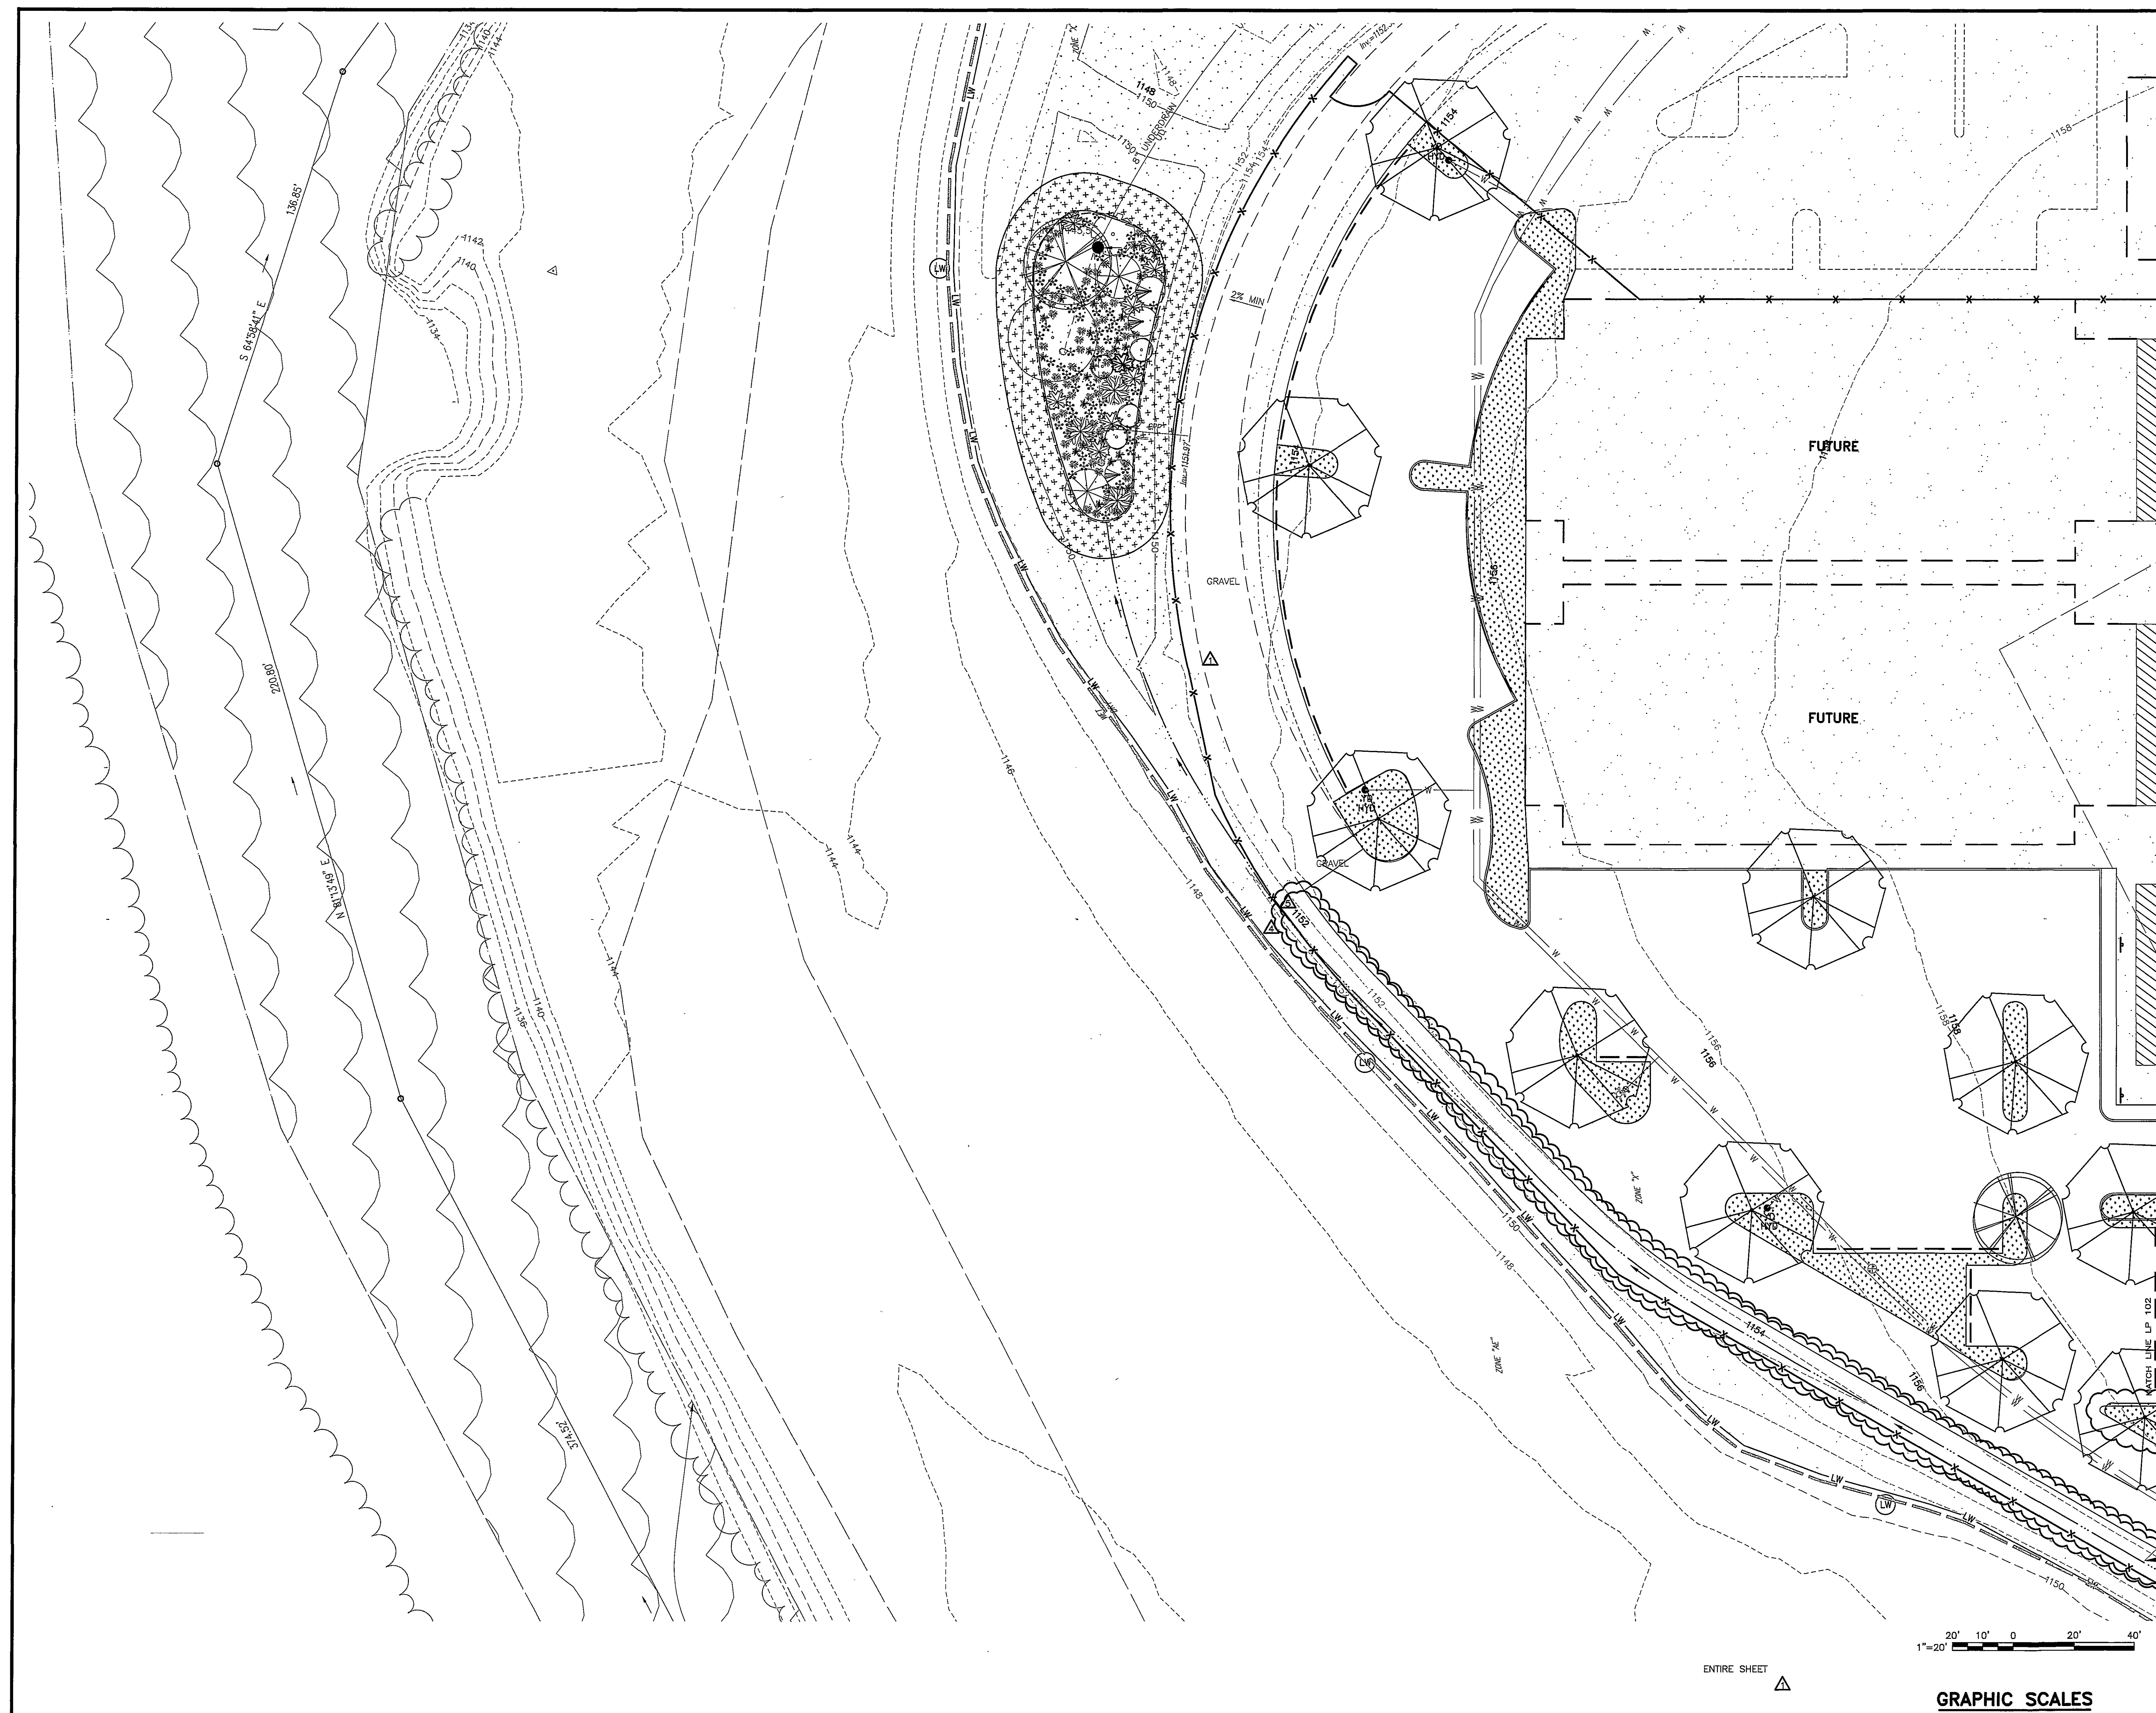

ENTIRE SHEET

20' 10' 0 20' 4
1"=20'

GRAPHIC SCALES

M:\1000SERIES\10075\CADD\DWG\MIR_RAL\FJ4LPN_0101.DWG 10075 01/29/2007 14:31:45 HEATHER RUTLEDGE