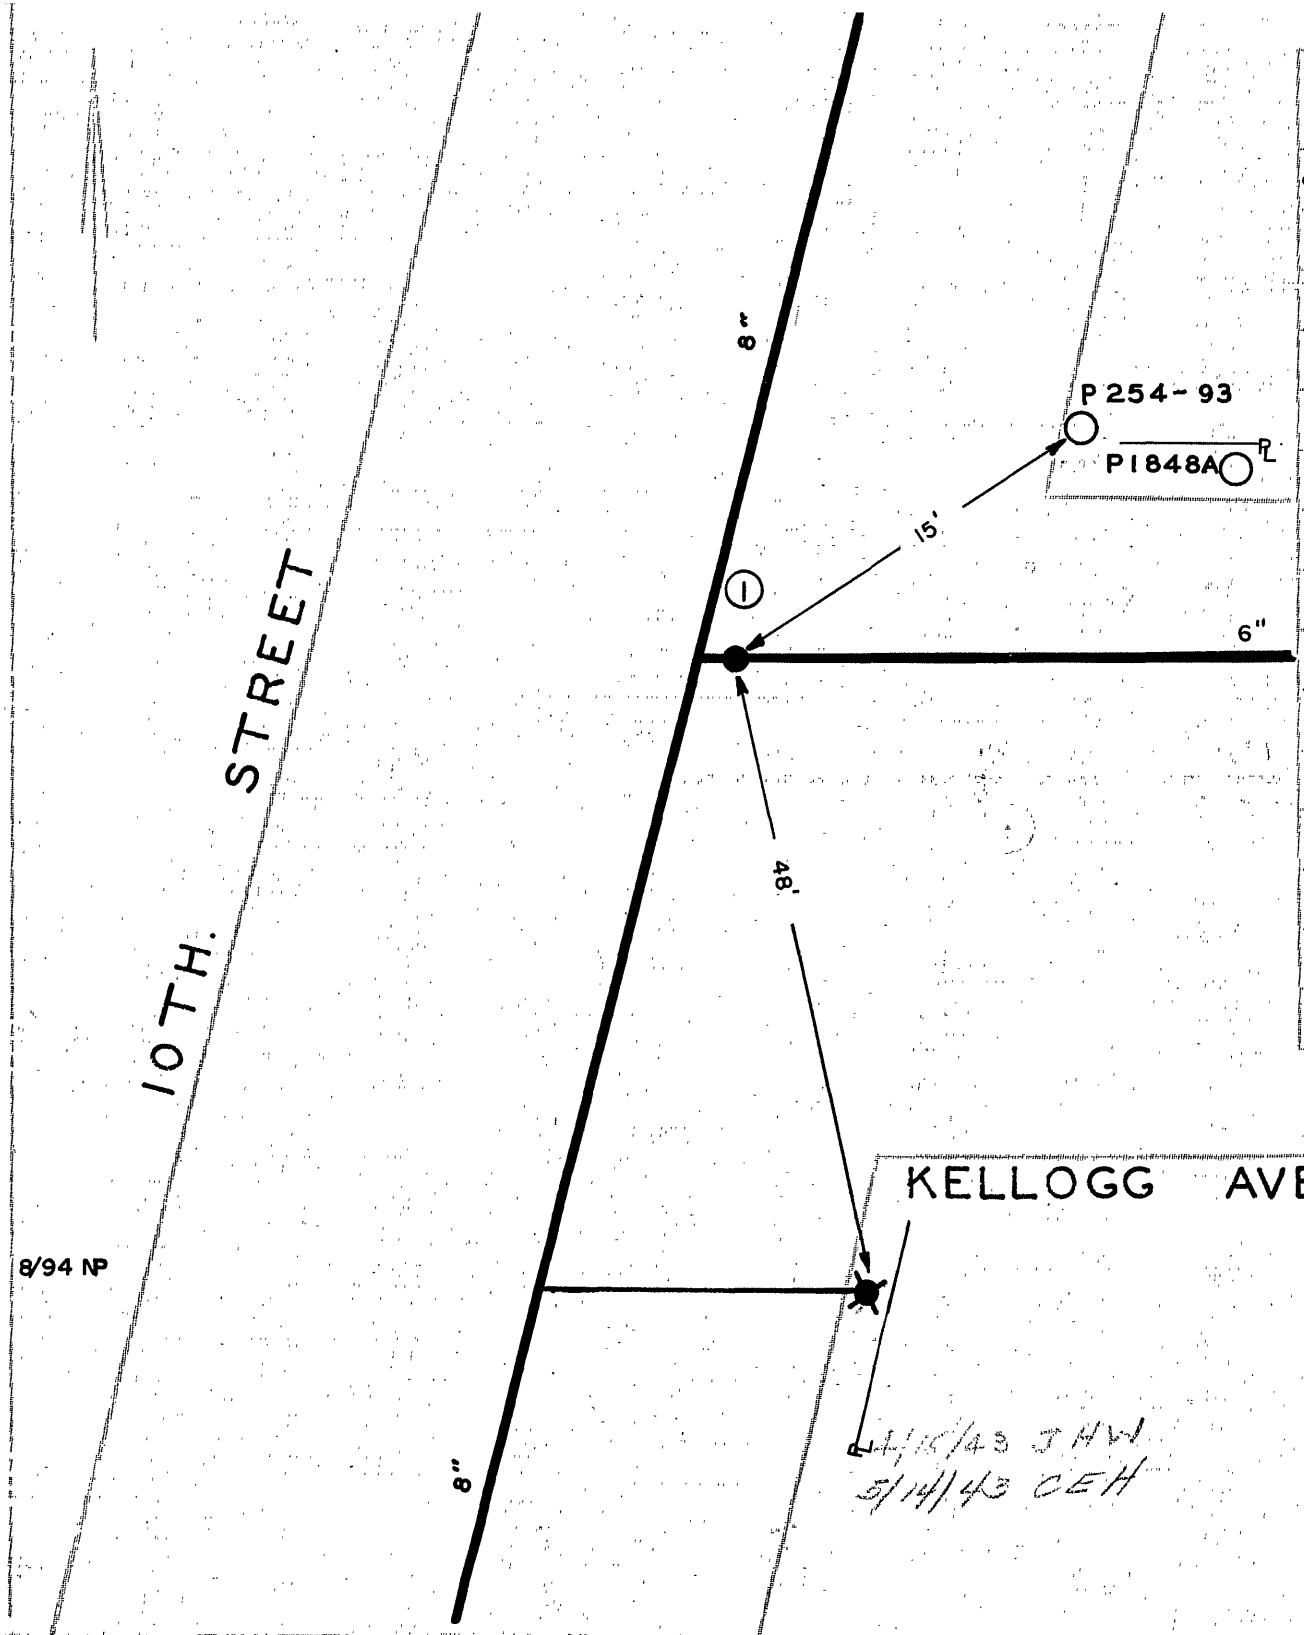

DATE	NO.	SIZE	MAKE	OPEN	TURNS
9/93	1	6"	MUELLER	R	

CITY OF ROANOKE — WATER DEP'T

VALVE DIAGRAM

KELLOGG AVE. &

10TH. ST. EXTENSION

N. W.

SEC. MAP 204,205

DATE PAGE NO. N.W. 62