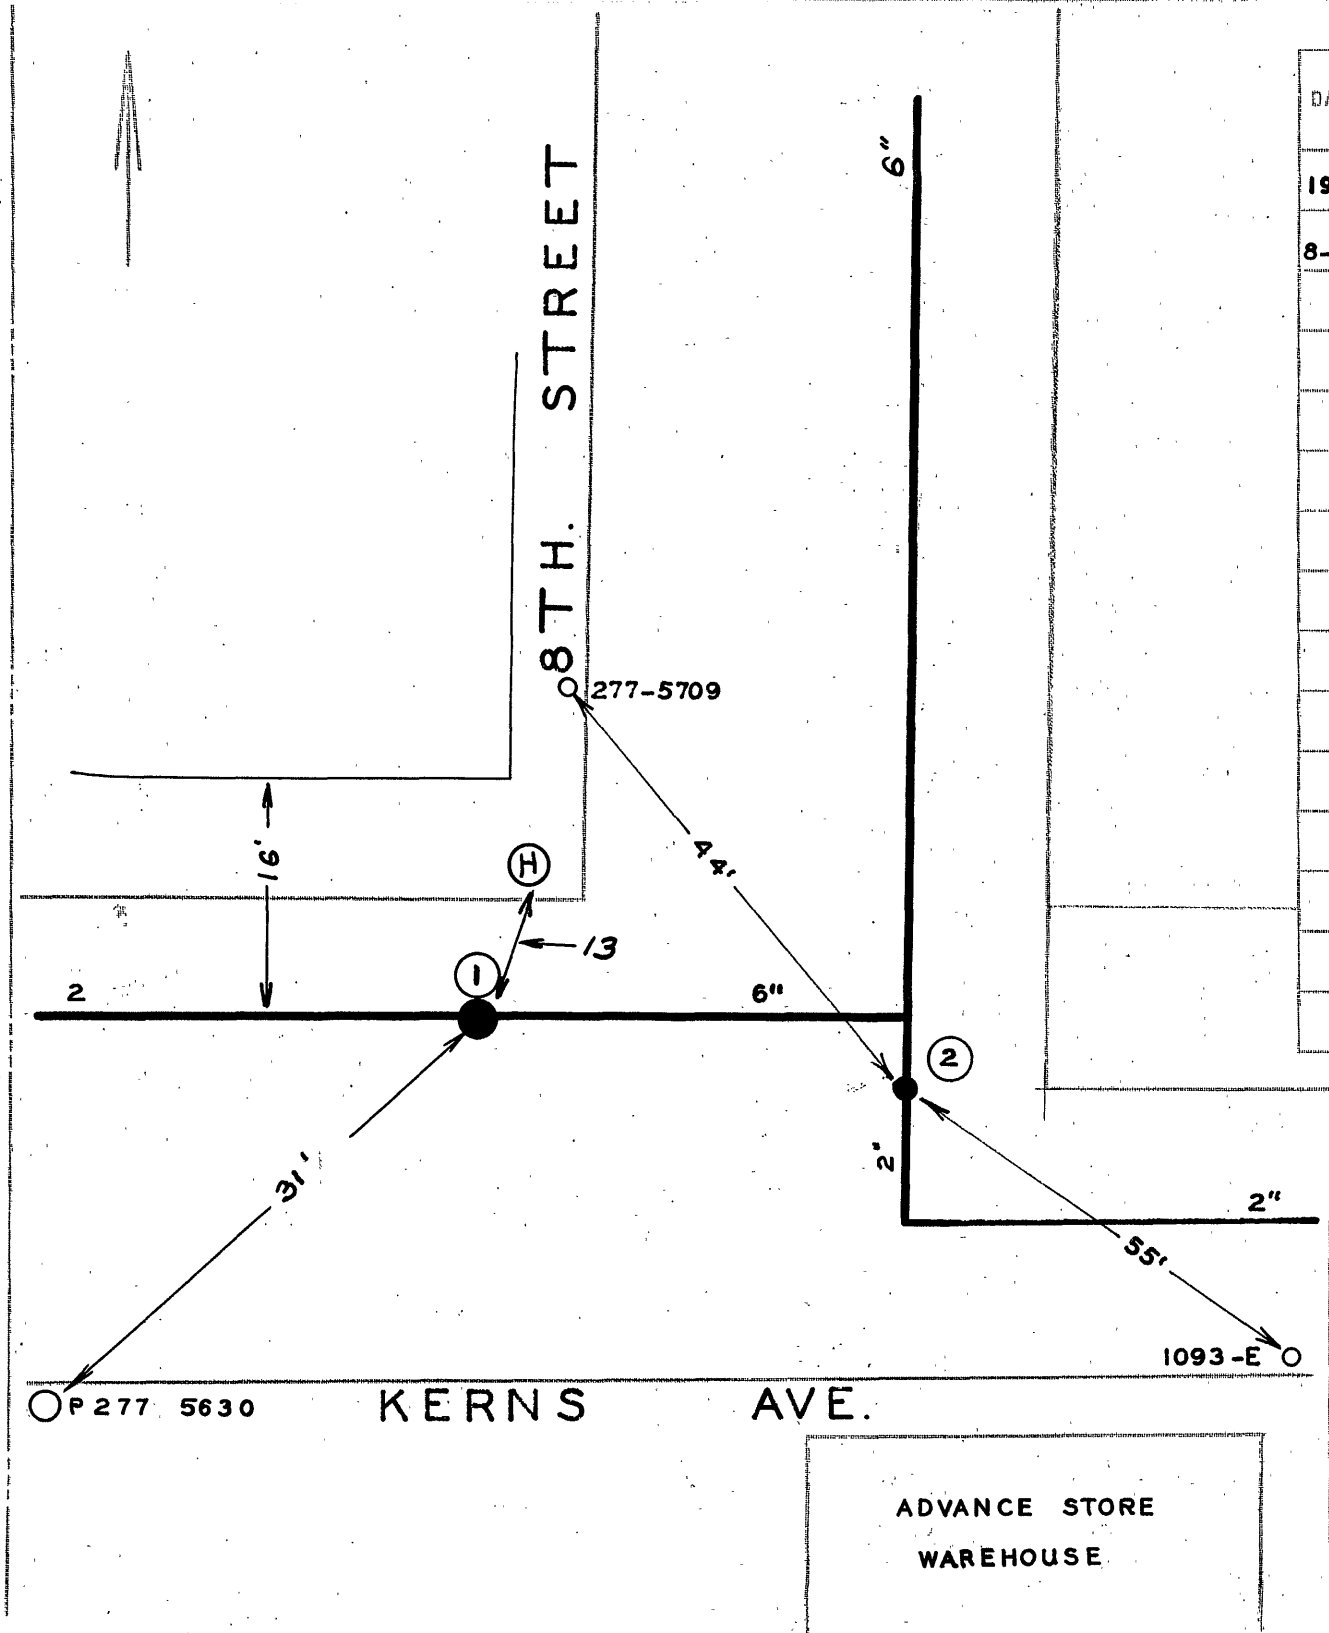

DATE	NO.	SIZE	MAKE	OPEN	TURNS
1942	1	2"		R	7 1/2
8-64	2	2"	DARLING	R	
	1	17'-W	WPL		
	2	0	N.P.L.		

CITY OF ROANOKE—WATER DEPT

VALVE DIAGRAM

KERNS AVE. & 8TH ST.

S.W.

SEC. MAP 113

DATE

PAGE NO. S.W. 311