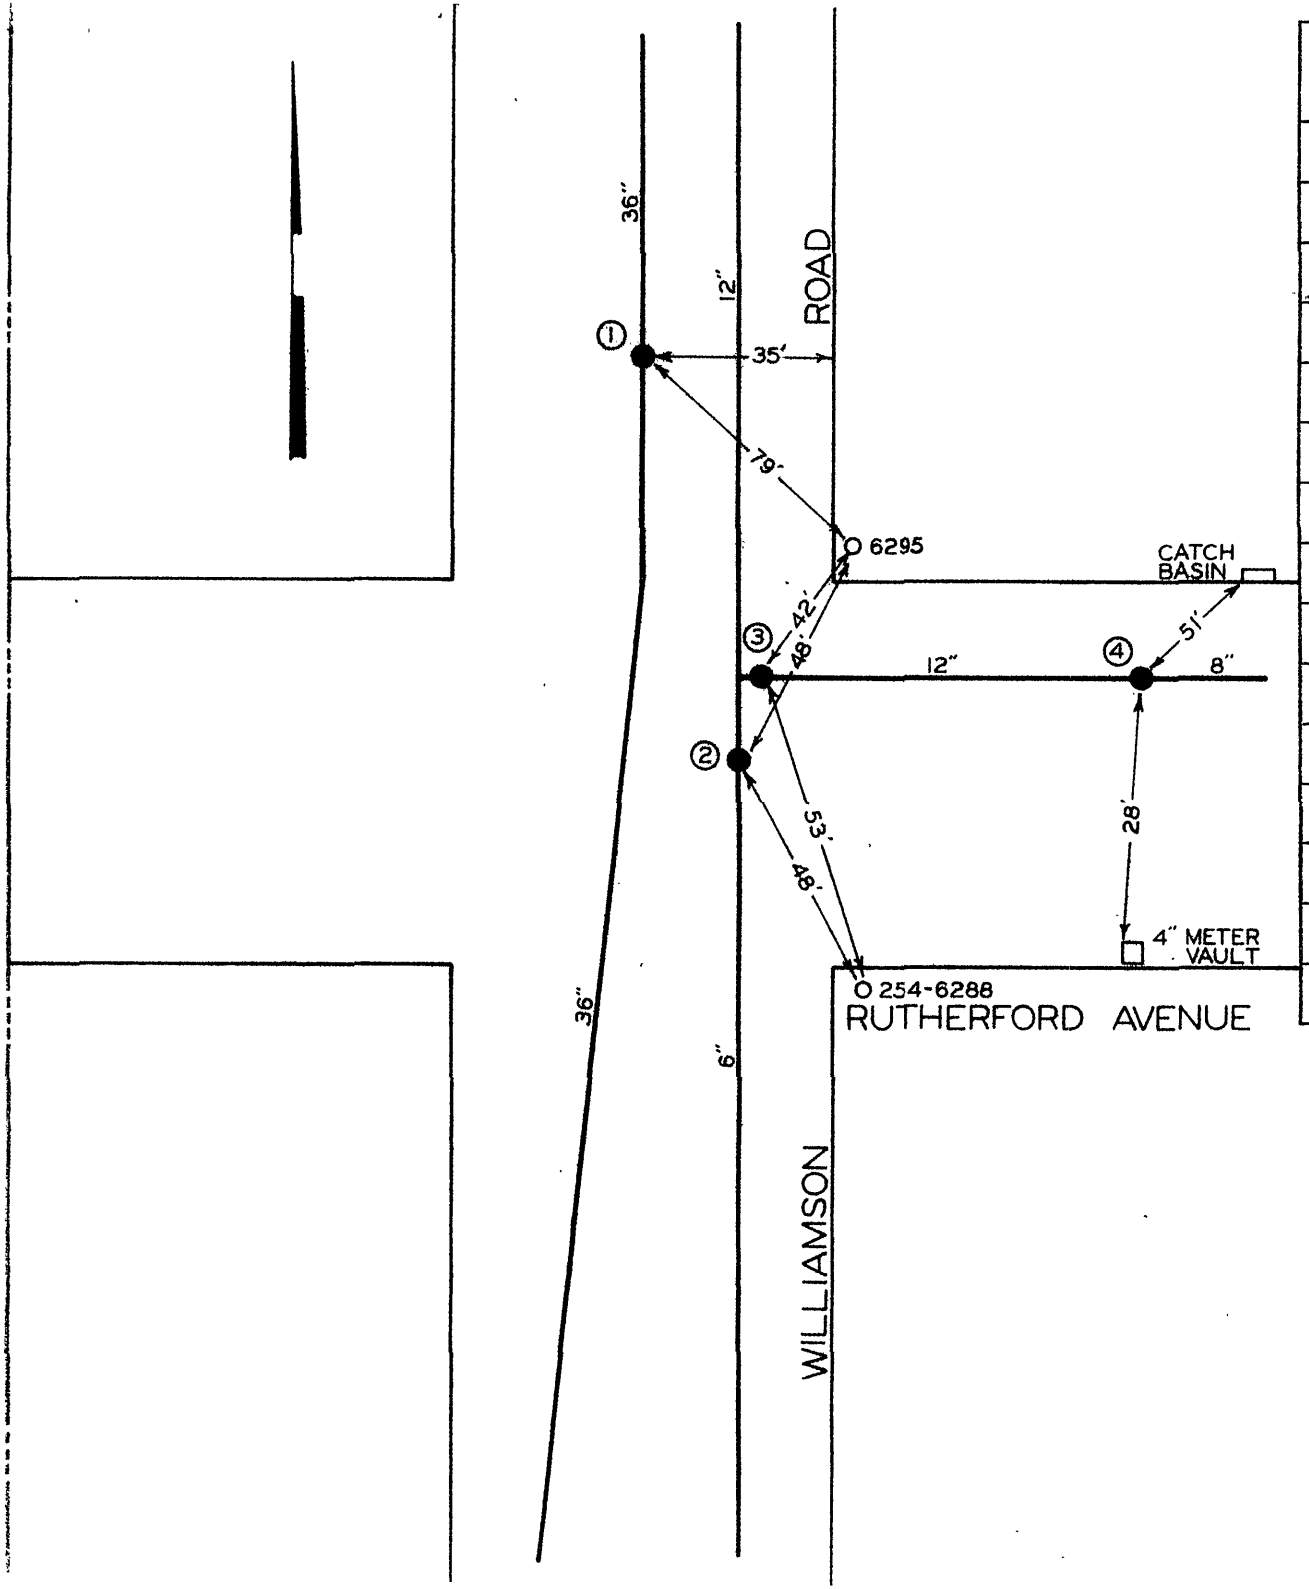

DATE	NO.	SIZE	MAKE	OPEN	TURNS
46	1	1"	SIMPLEX AIR VALVE		
57	2	12"	DARLING	R	
73	3	12"	MUELLER	R	39
73	4	8"	MUELLER	R	27

CITY OF ROANOKE—WATER DEP'T

VALVE DIAGRAM

RUTHERFORD AVENUE &

WILLIAMSON ROAD N.E.

SEC. MAP 302

DATE JAN 1974 PAGE NO.