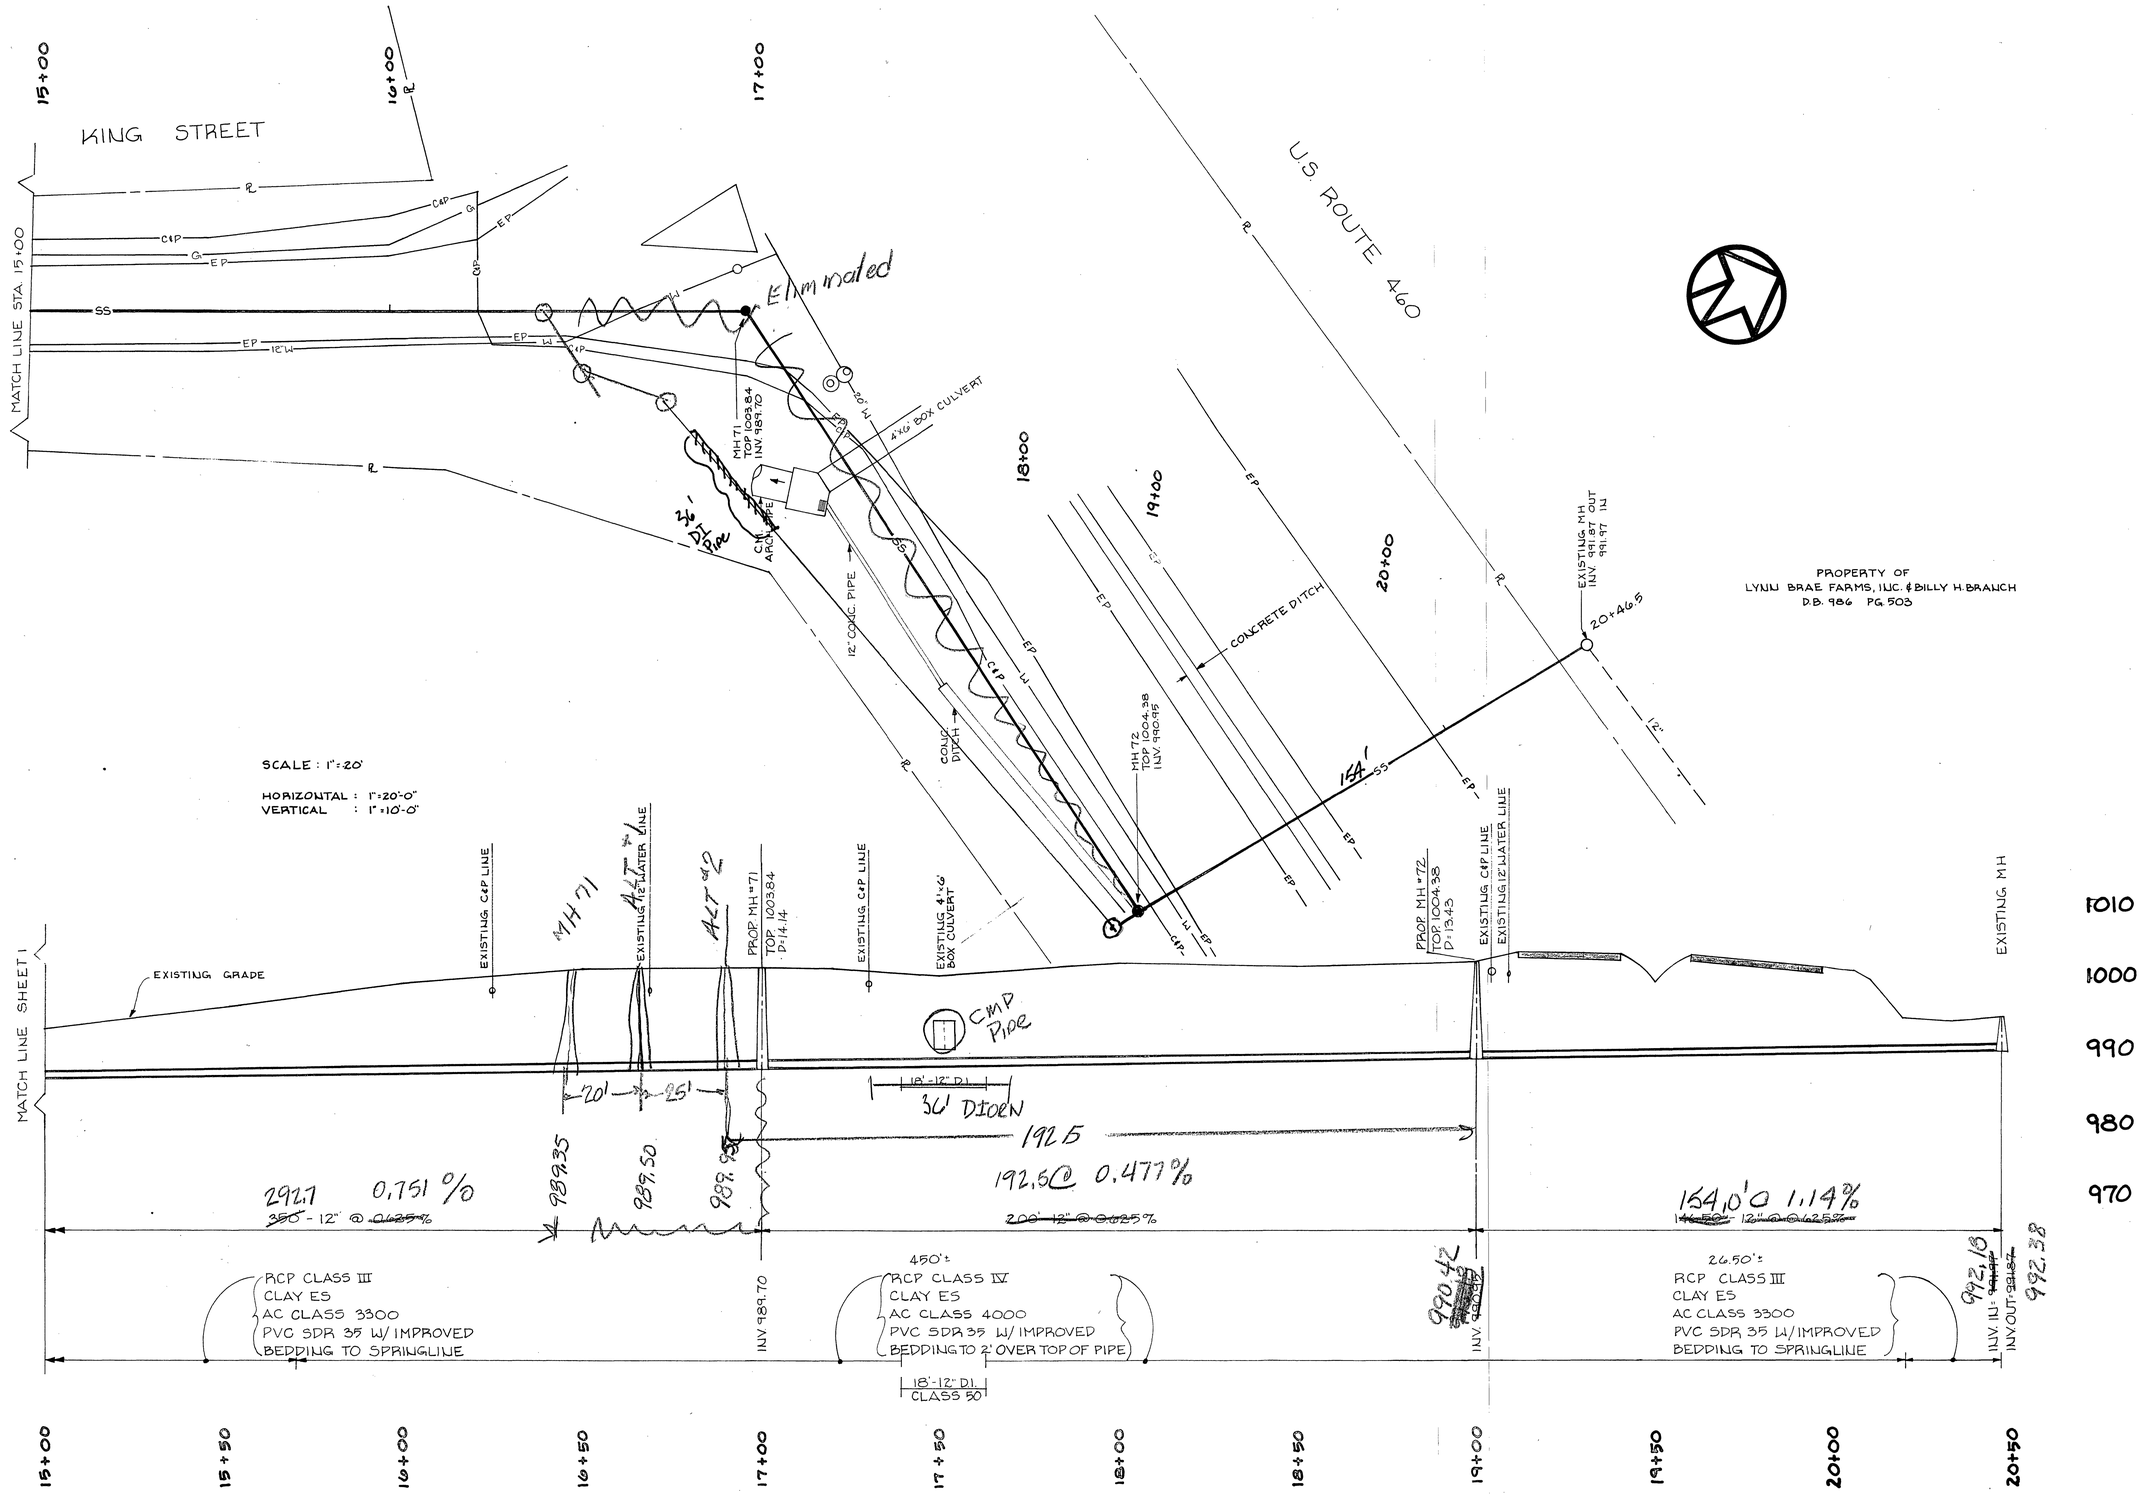

5896

11-8-82
King St.; Rte. 460
Roanoke, Va.

4 of 4