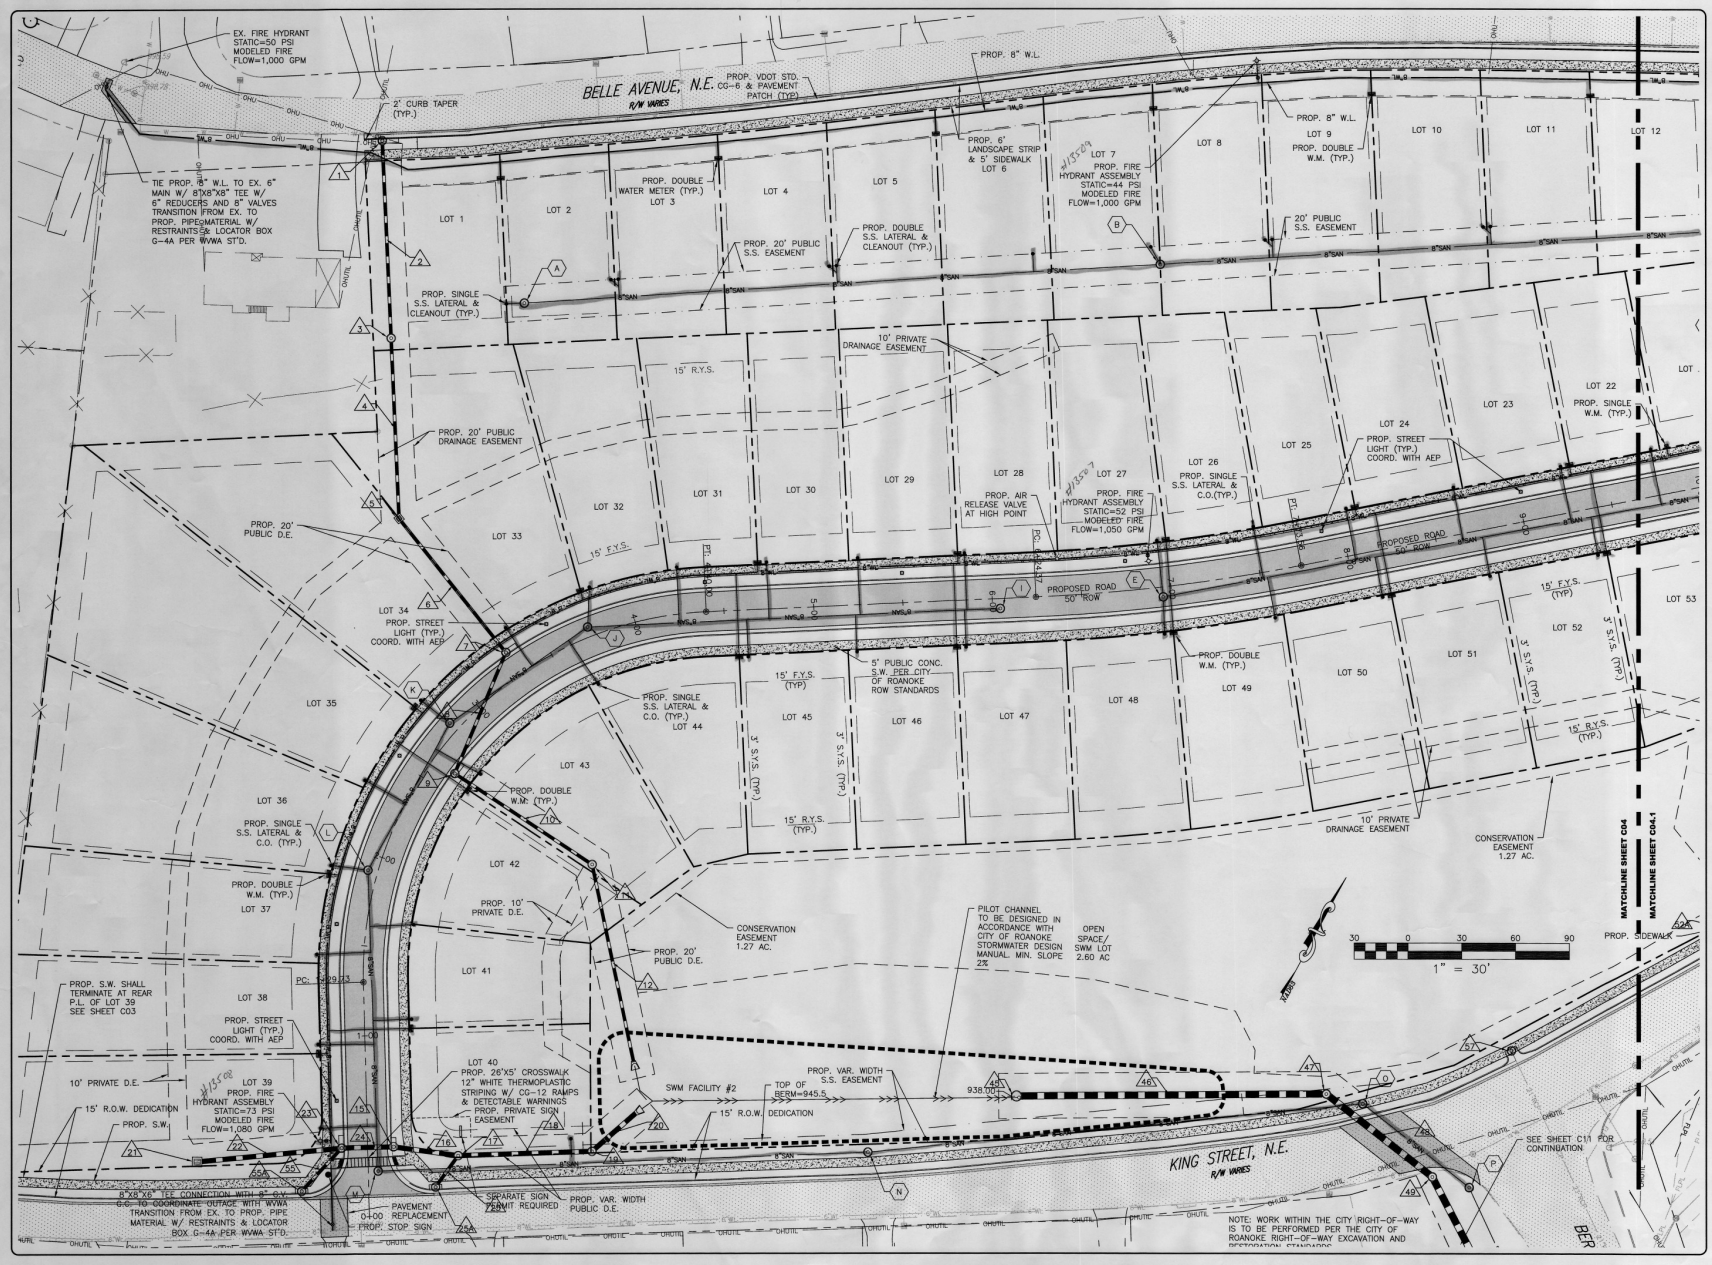

BALZER & ASSOCIATES
PLANNERS / ARCHITECTS
ENGINEERS / SURVEYORS

Roanoke / Richmond
New River Valley / Staunton
Harrisonburg / Lynchburg

www.balzer.cc

1208 Corporate Circle
Roanoke, VA 24018
540.772.9580

COMMONWEALTH OF VIRGINIA
CHRISTOPHER P. BURNS
Lic. No. 47336
11/13/2020
PROFESSIONAL ENGINEER

City of Roanoke
Planning, Building, & Development
COMPREHENSIVE DEVELOPMENT PLAN
APPROVED
by Aaron Cypher 03/02/2021

KING'S WALK

LAYOUT& UTILITY PLAN

CITY OF ROANOKE, VIRGINIA

DRAWN BY	SMD
DESIGNED BY	CPB
CHECKED BY	BTC
DATE	1/28/2020
SCALE	1" = 30'
REVISIONS	
7/10/2020	
9/8/2020	
11/13/2020	

C04

PROJECT NO. 04180106.00