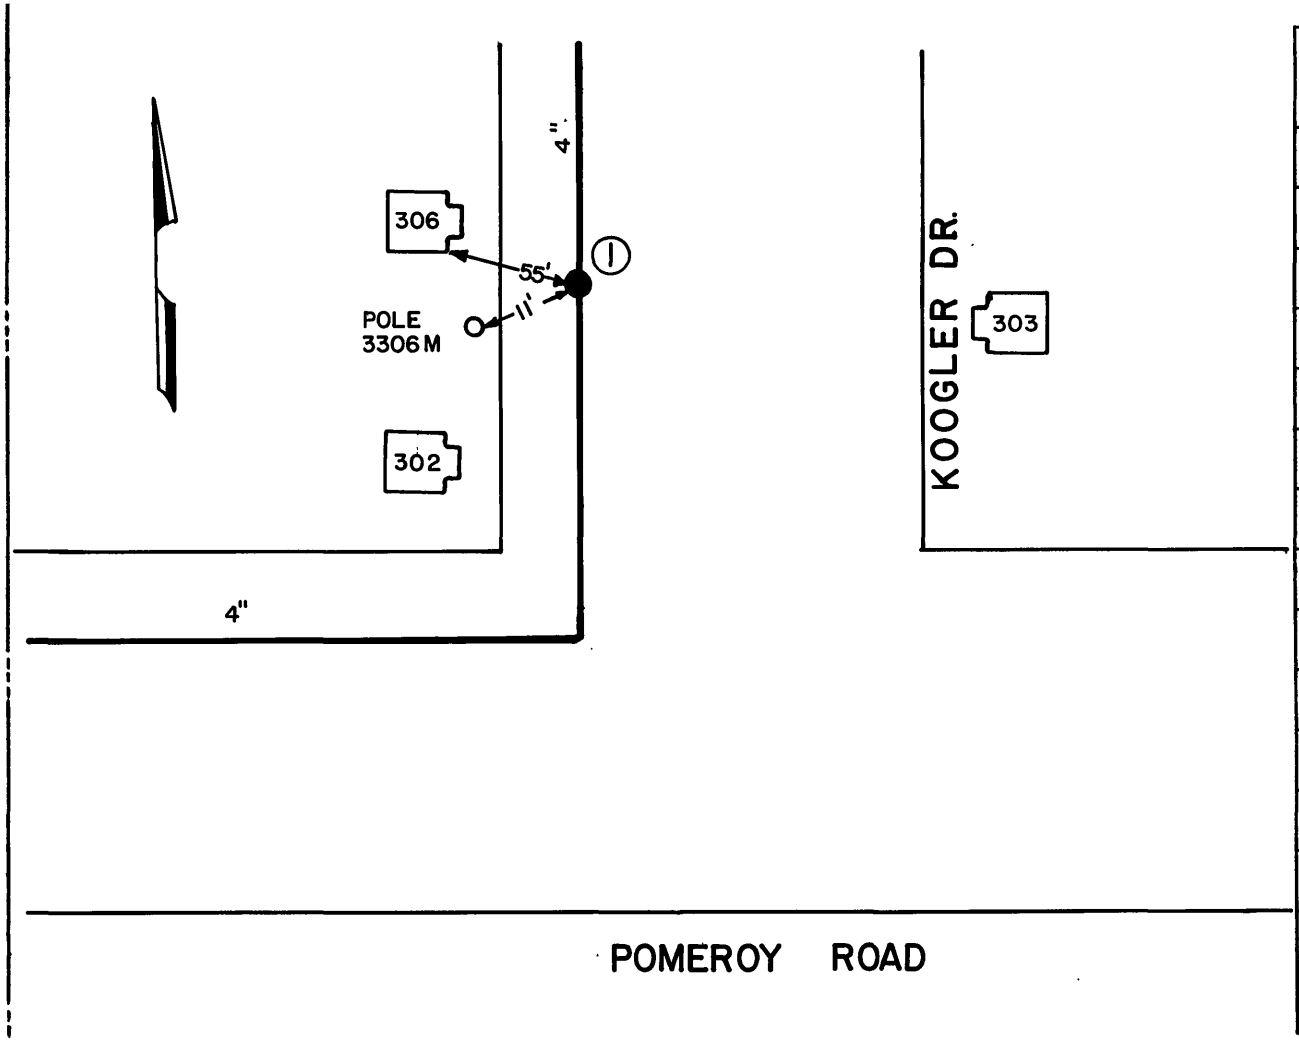

DATE	NO.	SIZE	MAKE	OPEN	TURNS
2-80	1	4"	MUELLER	R	

1/87 NP

CITY OF ROANOKE—WATER DEP'T VALVE DIAGRAM	
KOOGLER DRIVE &	
POMEROY ROAD	
	NW
SEC. MAP 606	
DATE	PAGE NO.