UTILITY NOTES:

1. CONTRACTOR SHALL STOP UTILITY LINES WITHIN 5' OF THE BUILDING AND CAP LINES. THE END OF THE LINES SHALL BE MARKED WITH A 4"x4" POST AT LEAST 3.0' IN HEIGHT. POSTS SHALL BE PAINTED AS FOLLOWED:
   SANITARY SEWER – GREEN
   WATER – BLUE
   STORM DRAIN – WHITE
   ELECTRICAL – RED
   PHONE/CABLE – ORANGE
   GAS – YELLOW
2. ALL UTILITY RELOCATION SHALL BE THE CONTRACTORS RESPONSIBILITY.

AS-Builts
3-28-2008
MARK SINK.
Contractors set

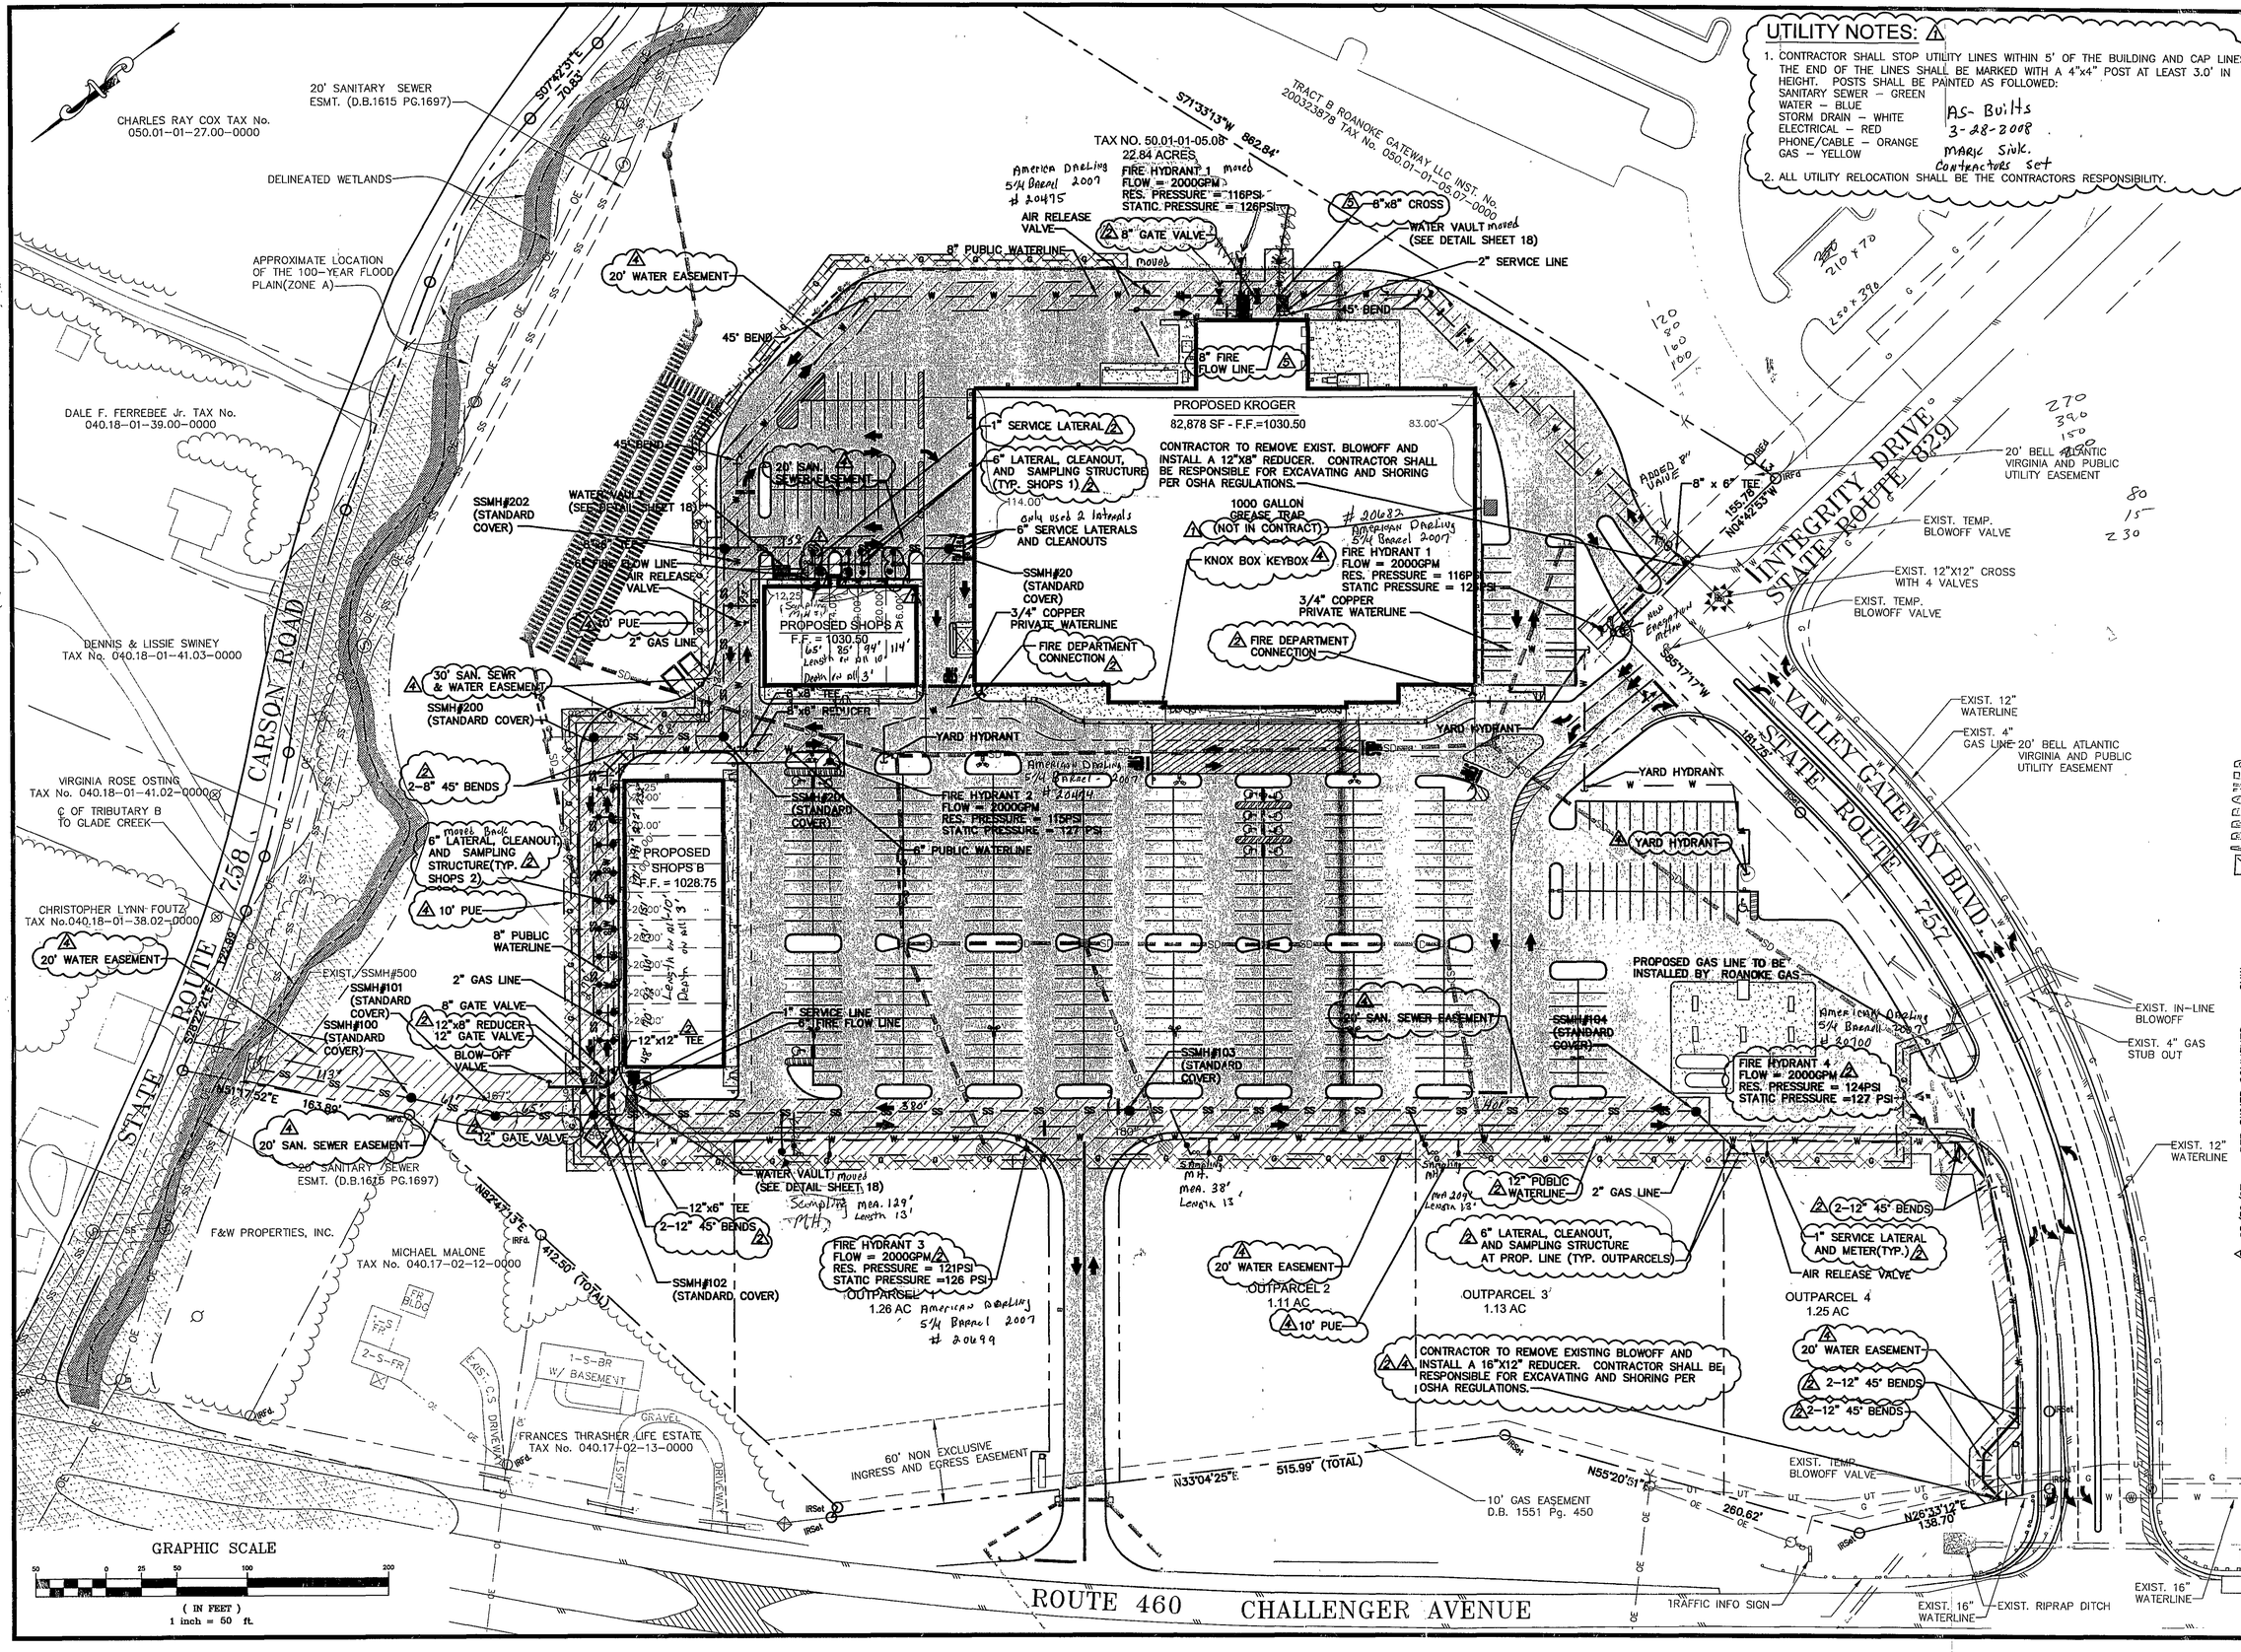

102 Albemarle Ave
Roanoke, Virginia
24013
www.lmwpc.com
ph: 540.345.0675
fax: 540.342.4456
lmweng@lmw.roacoxmail.com
LMW P.C.
Engineering
Architecture
Surveying
Landscape Design

NEW STORE SITE: R-391
VINTON MAGISTERIAL DISTRICT
ROANOKE COUNTY, VIRGINIA

NO.	DATE	DESCRIPTION	BY
4	08/30/07	PER OWNER COMMENTS	CHW
3	07/02/07	PER COUNTY COMMENTS	MCP
2	3/26/07	PER COUNTY & VDOT COMMENTS	CHW
1	2/27/07	PER KROGER COMMENTS	CHW

UTILITY PLAN

COMMONWEALTH OF VIRGINIA
RICHARD C. WHITE
NO. 020021
8-30-07
PROFESSIONAL ENGINEER

Designed By	CHW
Drawn By	CHW
Checked By	RCW
Approved By	RCW
Submitted By	RCW
Drawing	3155Abaseplan.dwg
Date	11/20/06
Scale	1"=50'
Commission No.	3155A
Sheet	8 of 22