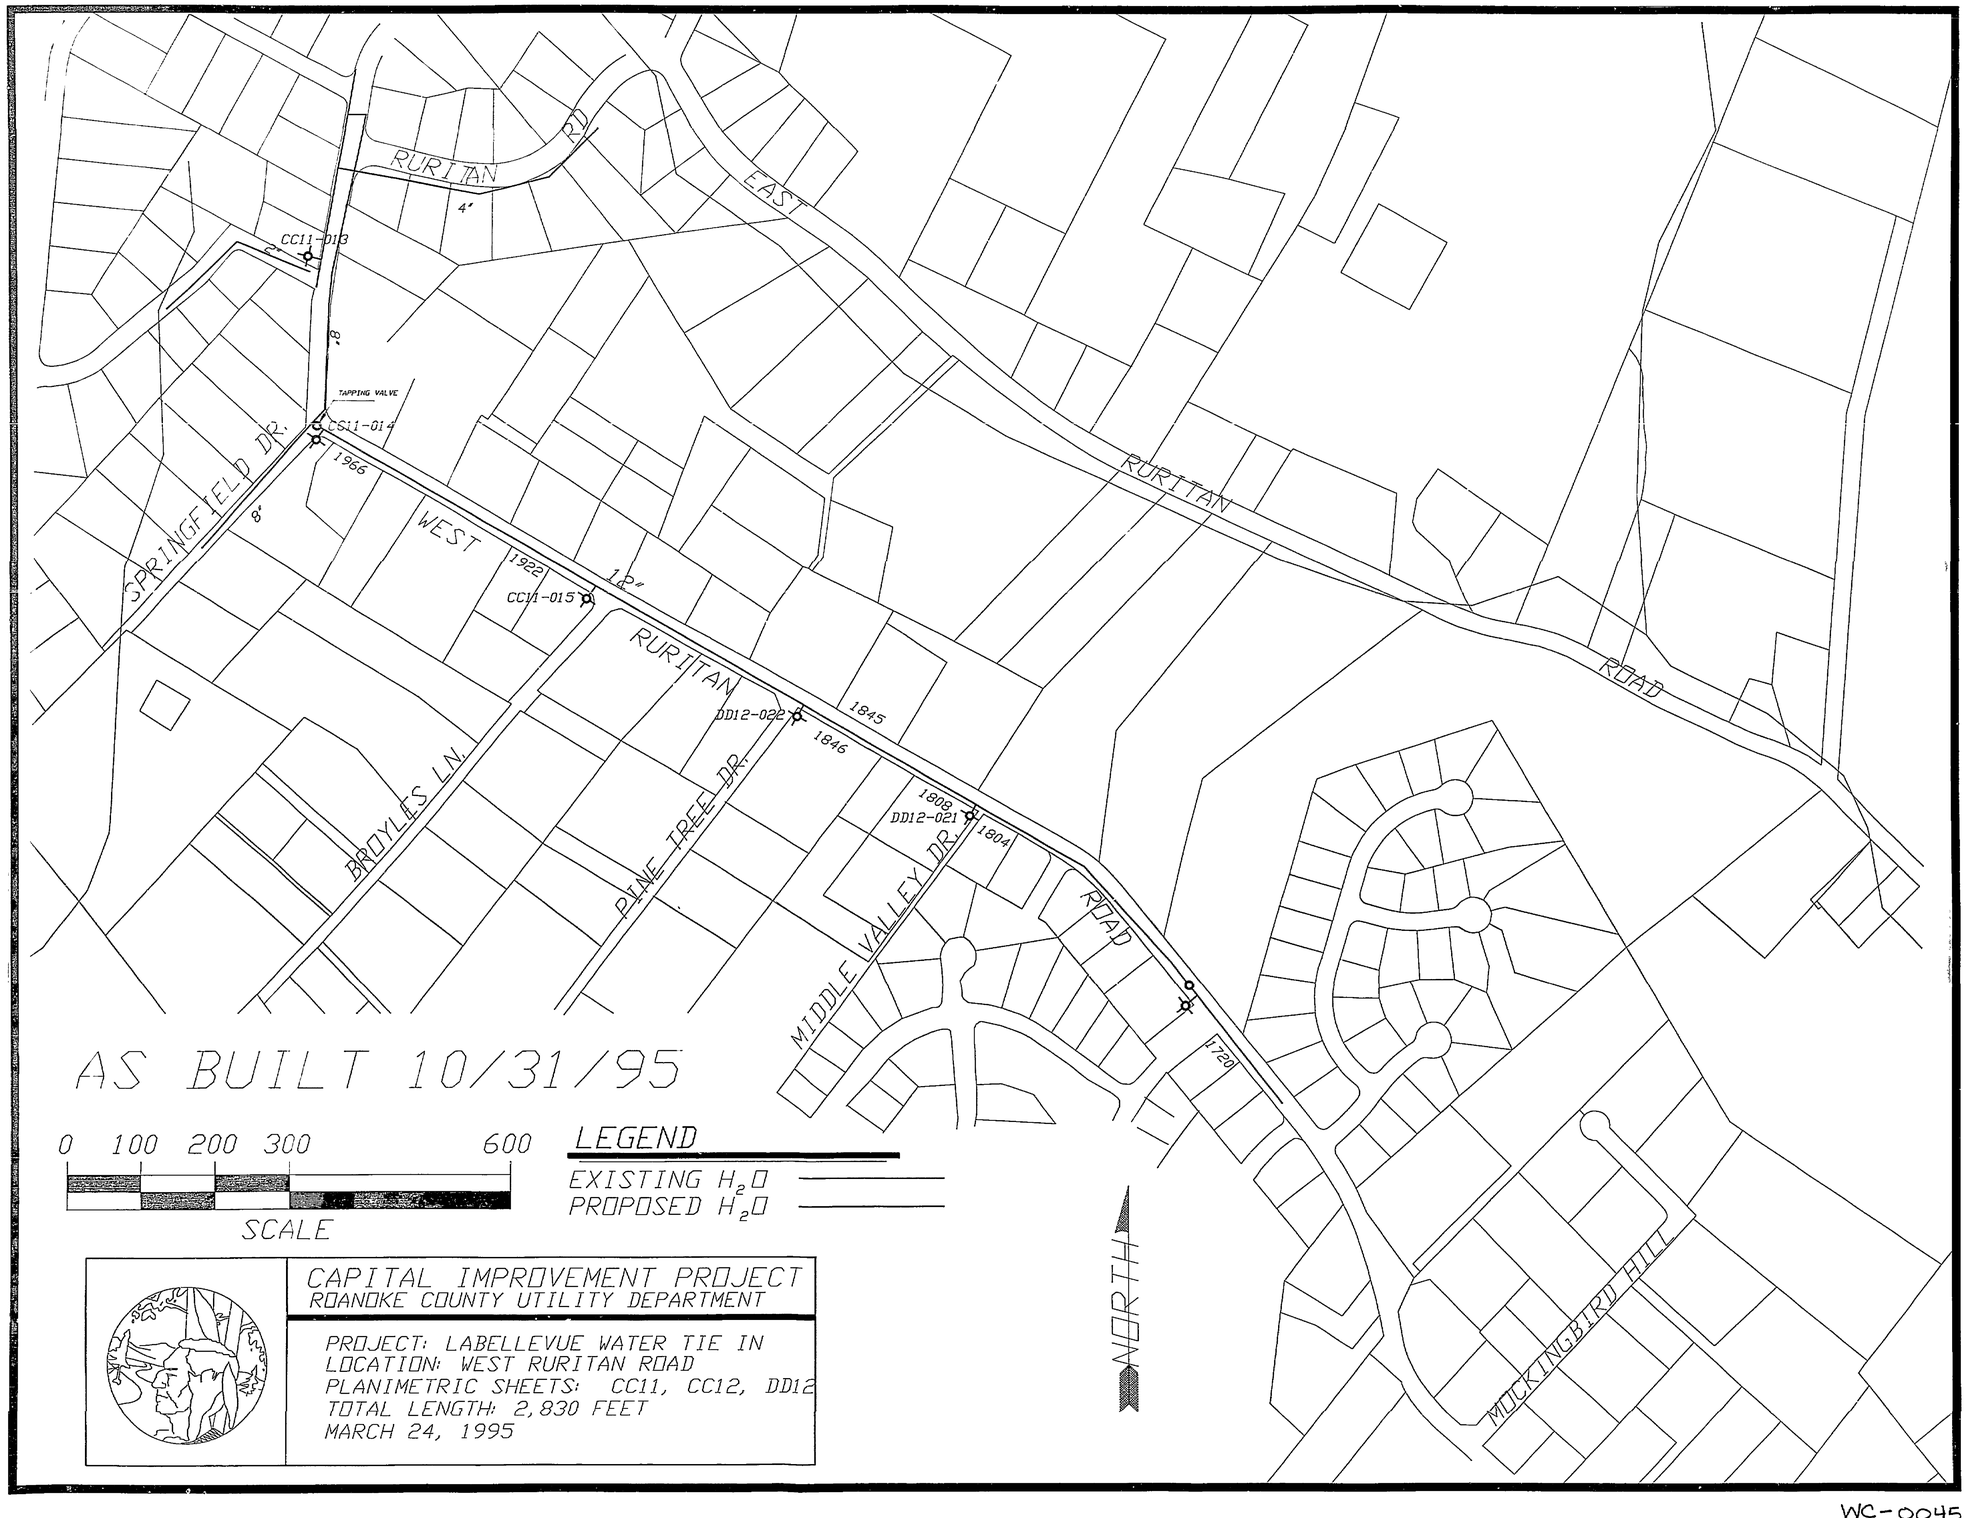

WC-0045

