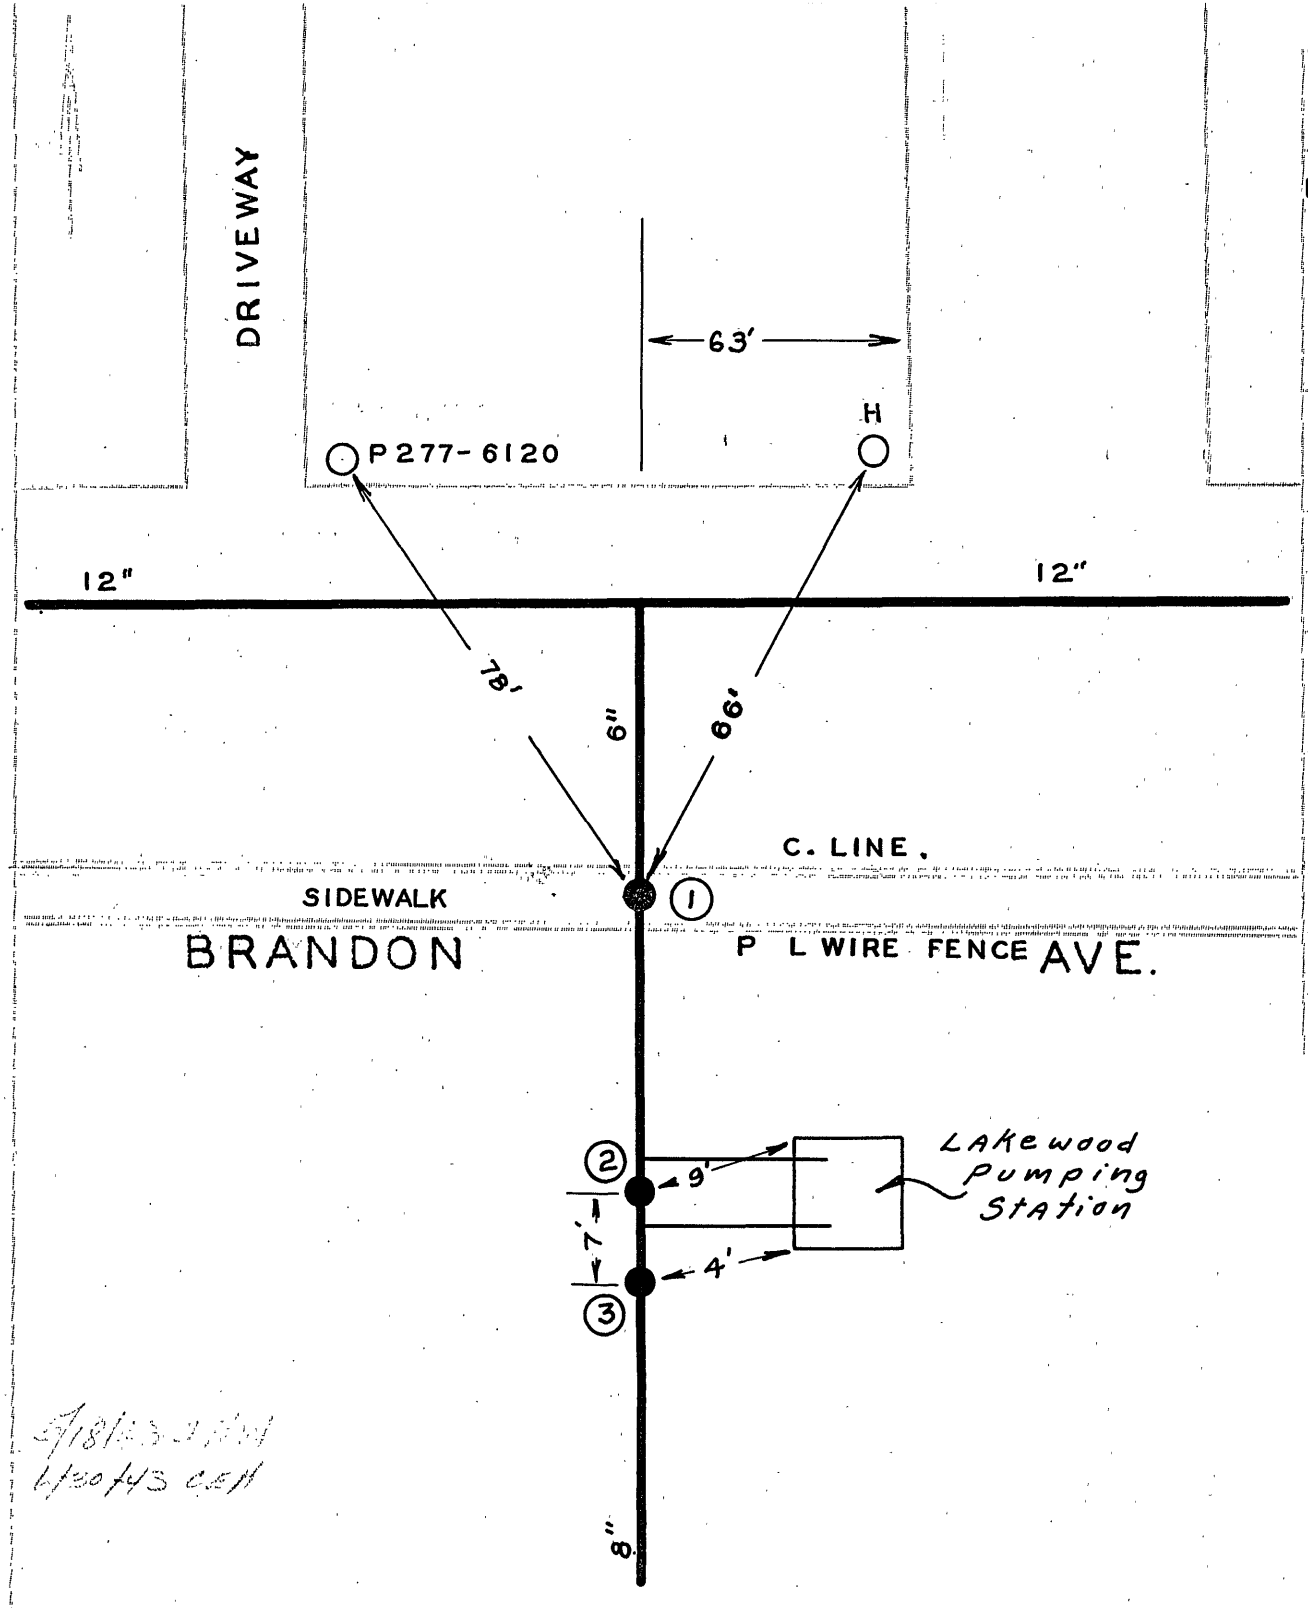

DATE	NO	SIZE	MAKE	OPEN	TURNS
1928	1	6"		L	13
1940	2	8"		R	
1940	3	8"		R	
	1	10'-N	SPL		

CITY OF ROANOKE—WATER DEPT
VALVE DIAGRAM
1931 LAKEWOOD PARK
S.W.
LAKEWOOD P. S.
SEC. MAP 124
DATE
PAGE NO. S.W.348