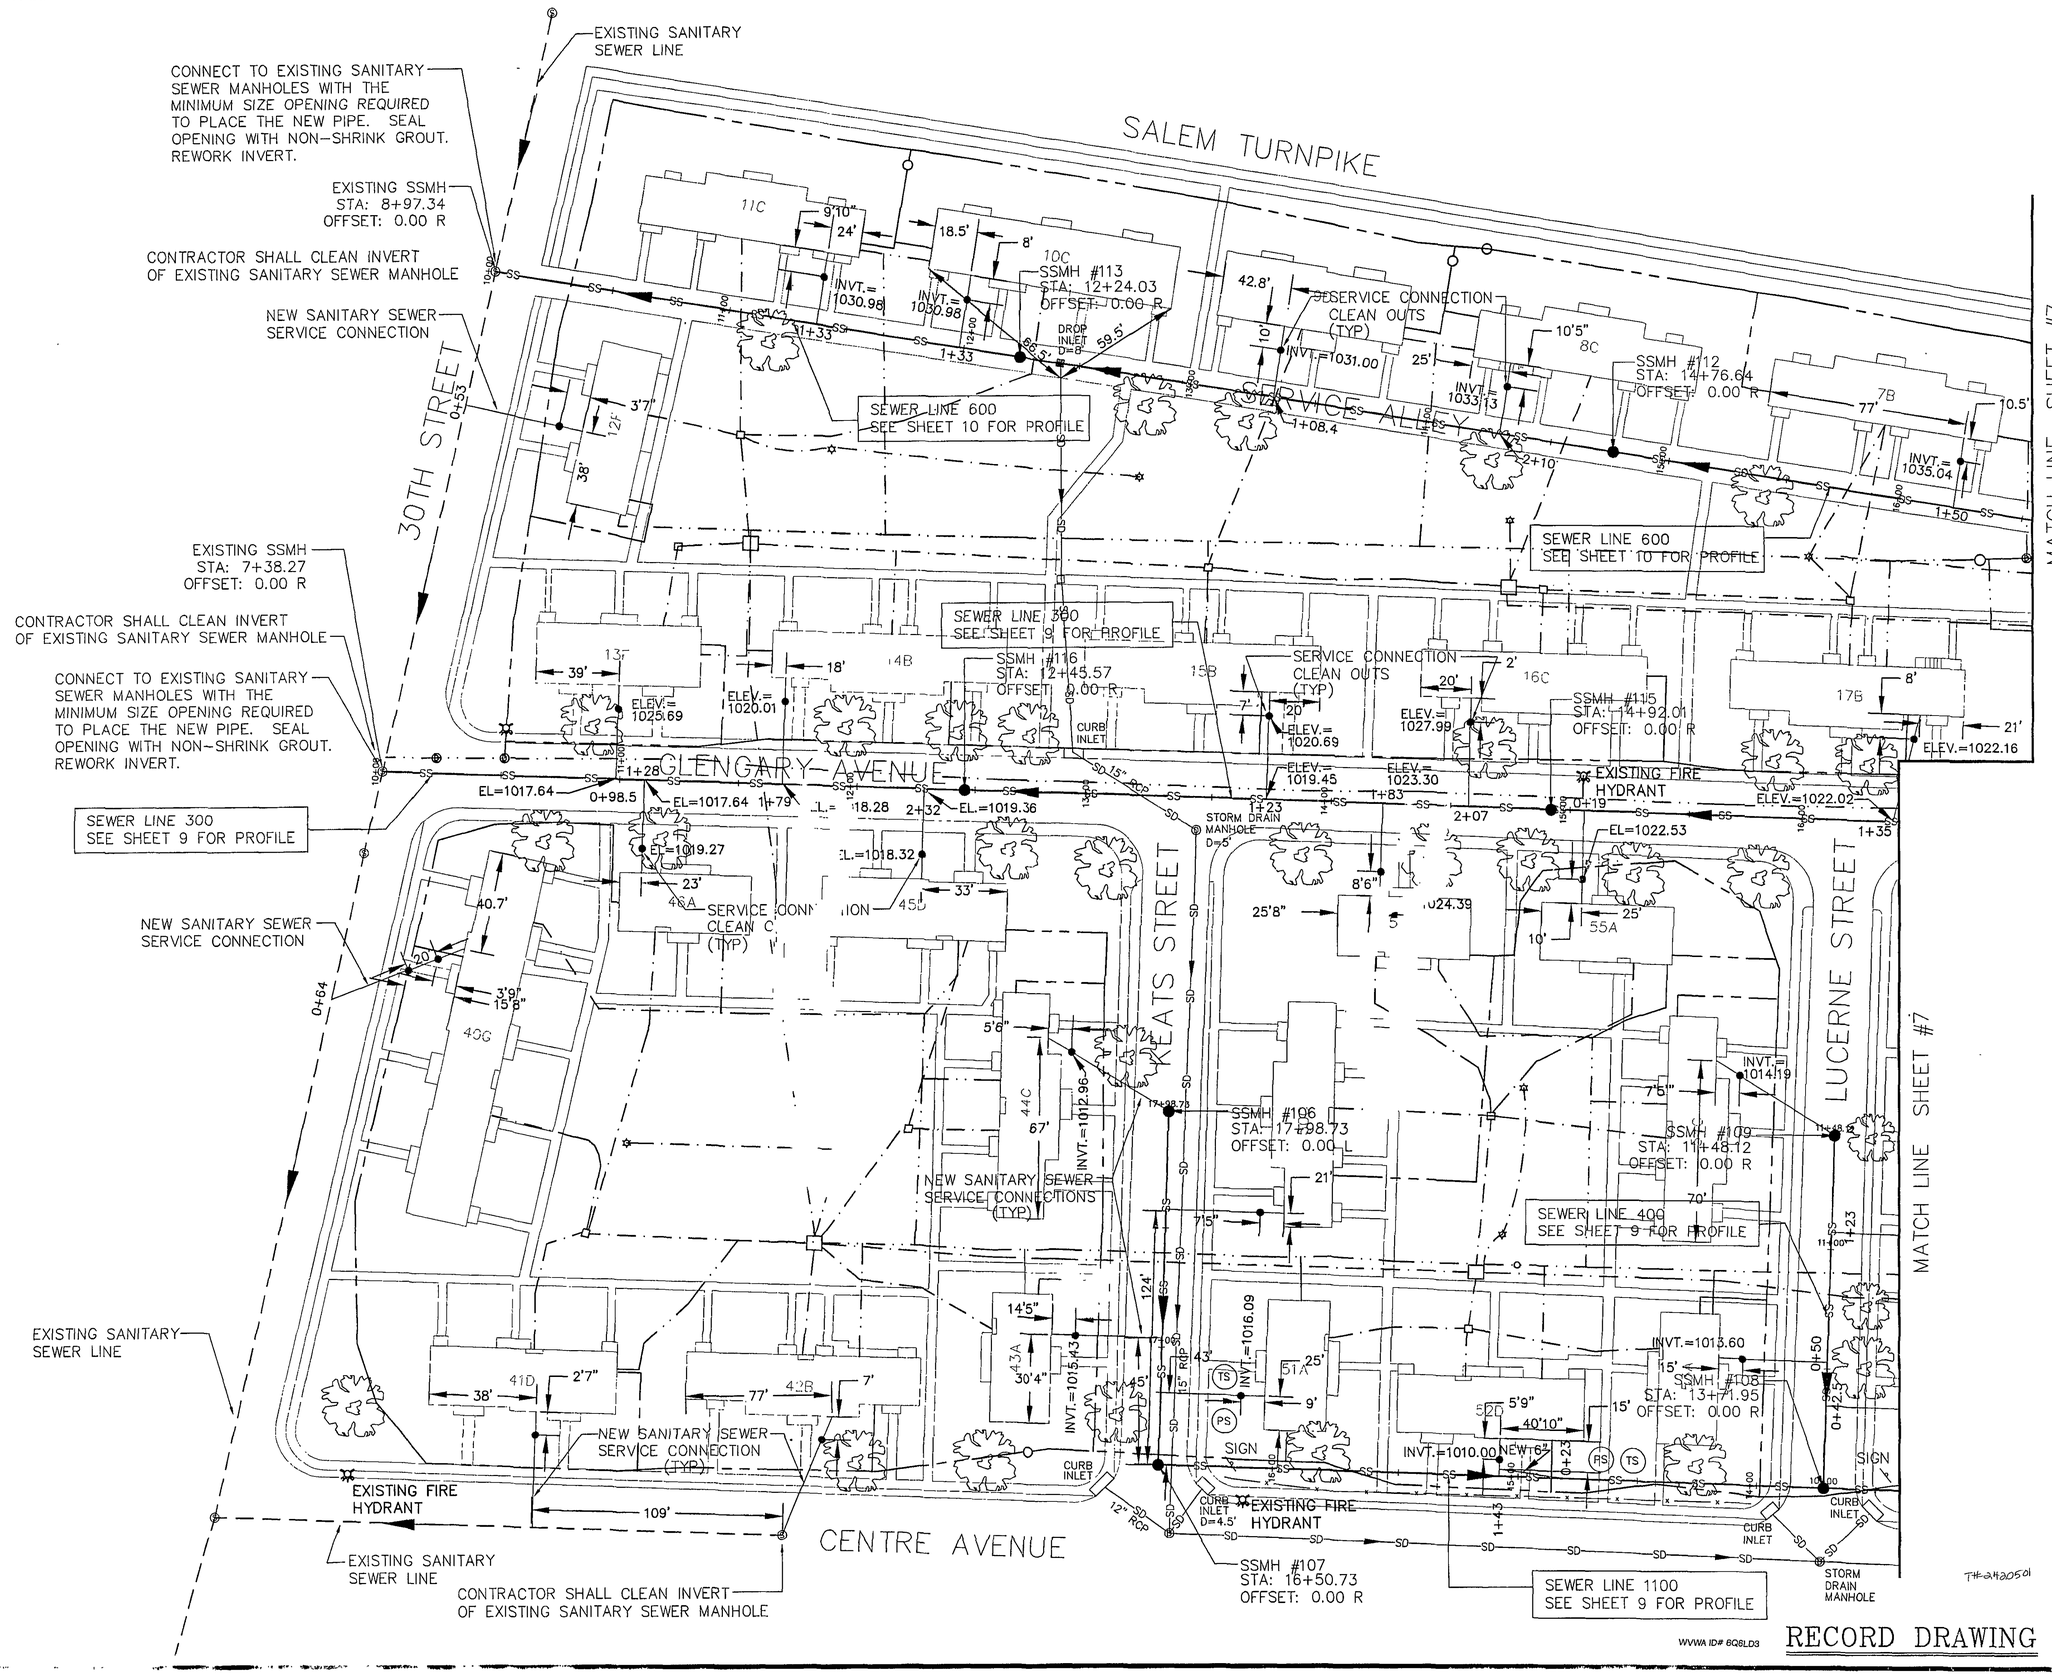

RECORD DRAWING

LMW P.C.
ENGINEERING · ARCHITECTURE · SURVEYING
102 ALBEMARLE AVENUE
ROANOKE, VIRGINIA 24013
(540) 345-0675
FAX (540) 342-4456

CITY OF ROANOKE
REDEVELOPMENT & HOUSING AUTHORITY
LANSDOWNE PARK
SANITARY SEWER REPLACEMENT
CITY OF ROANOKE, VIRGINIA

NO.	DATE	DESCRIPTION	DRW
1	11/25/98	RECORD DRAWING	BJ

SANITARY SEWER PLAN

COMMONWEALTH OF VIRGINIA
DOUGLAS R. MEREDITH, JR.
No. 22942
PROFESSIONAL ENGINEER

Designed By	DME/MJG
Drawn By	DME
Checked By	RCW
Approved By	DRM
Submitted By	DRM
Drawing	1136PL-1.DWG
Date:	5/2/97
Scale	H: 1" = 30'
Commission No.	1136
Sheet	6 of 13

C:\DWGS\1136\1136PL-1.DWG DATE: 5/1/97