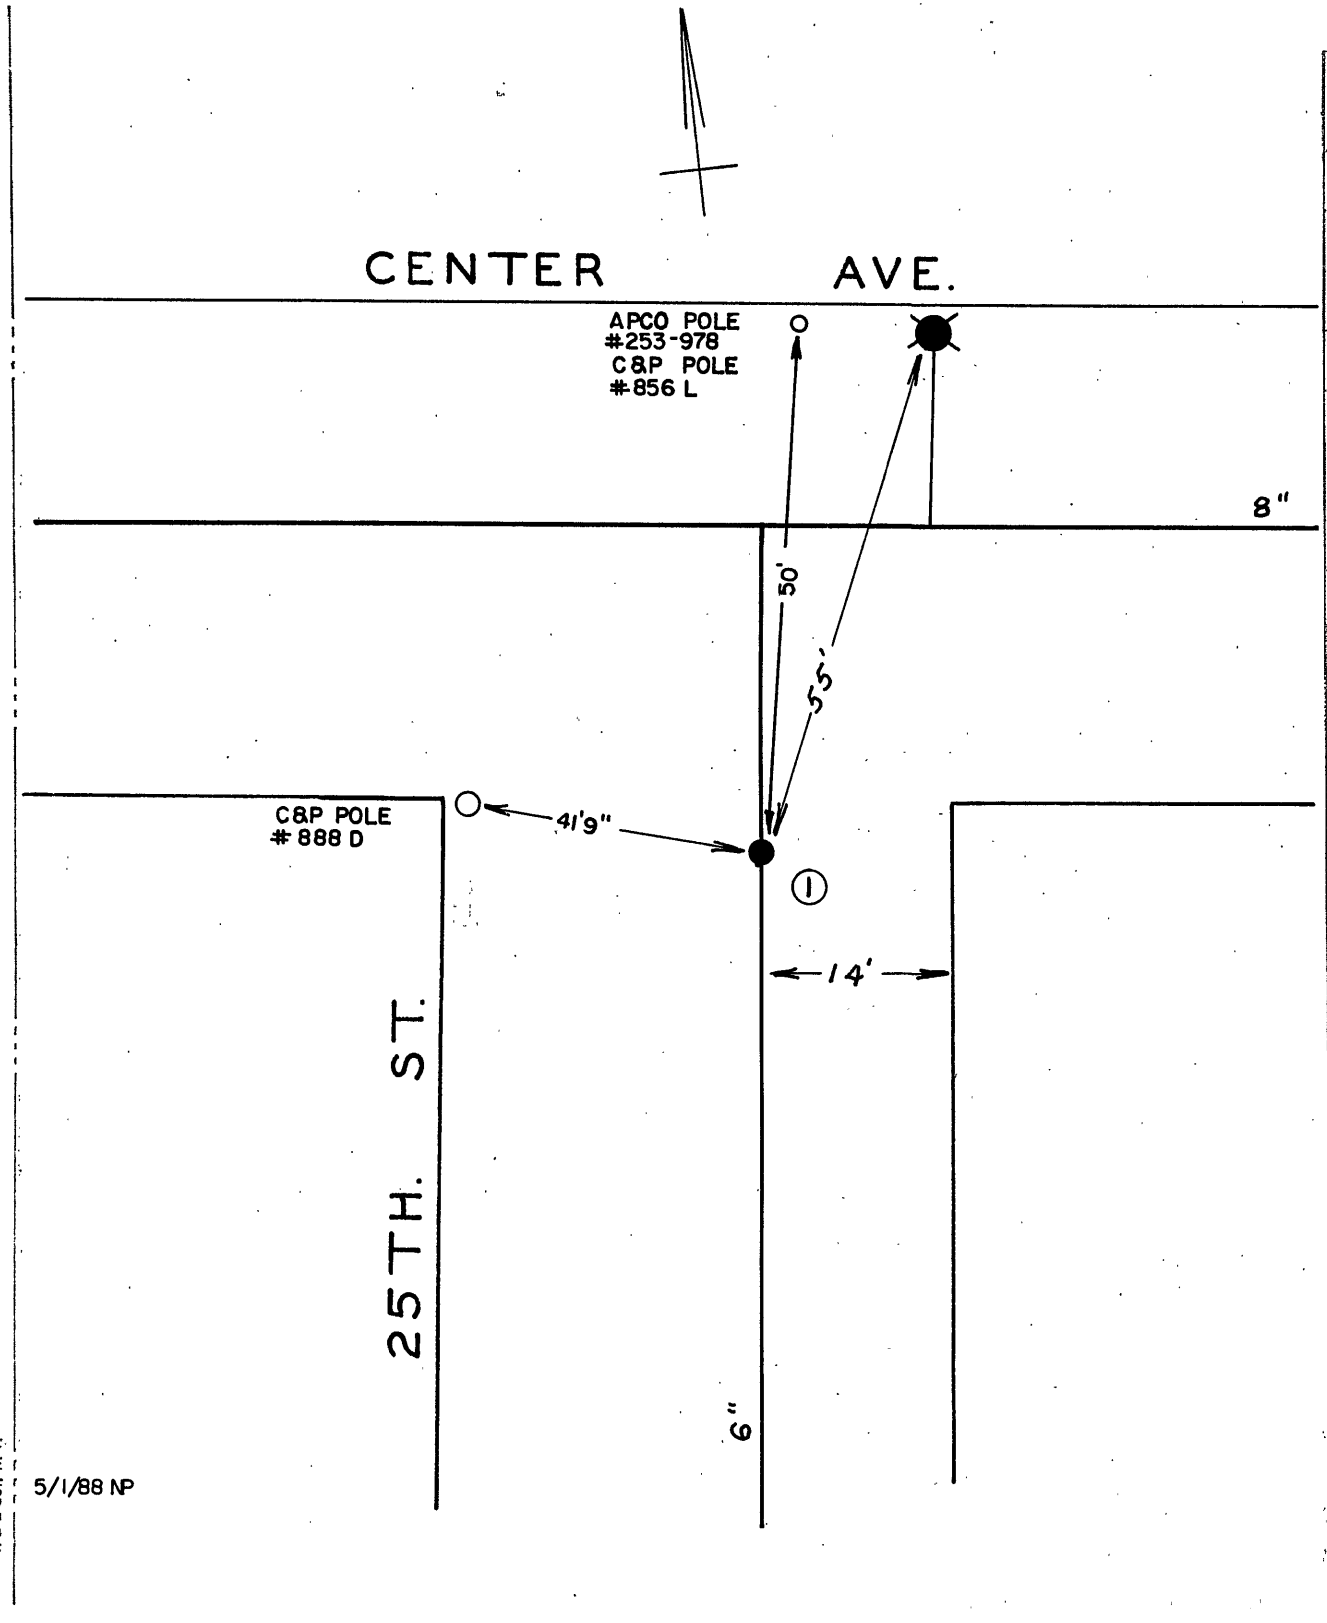

DATE	NO.	SIZE	MAKE	OPEN	TURNS
1950	1	6"	MUELLER	R	20
	1	8'-S	SPL		

CITY OF ROANOKE—WATER DEPT.

VALVE DIAGRAM

CENTER AVE. & 25TH.

STREET N.W.

SEC. MAP 242, 231

DATE PAGE NO.

"IMPERIAL" TRACING CLOTH
K & E CO., N.Y.