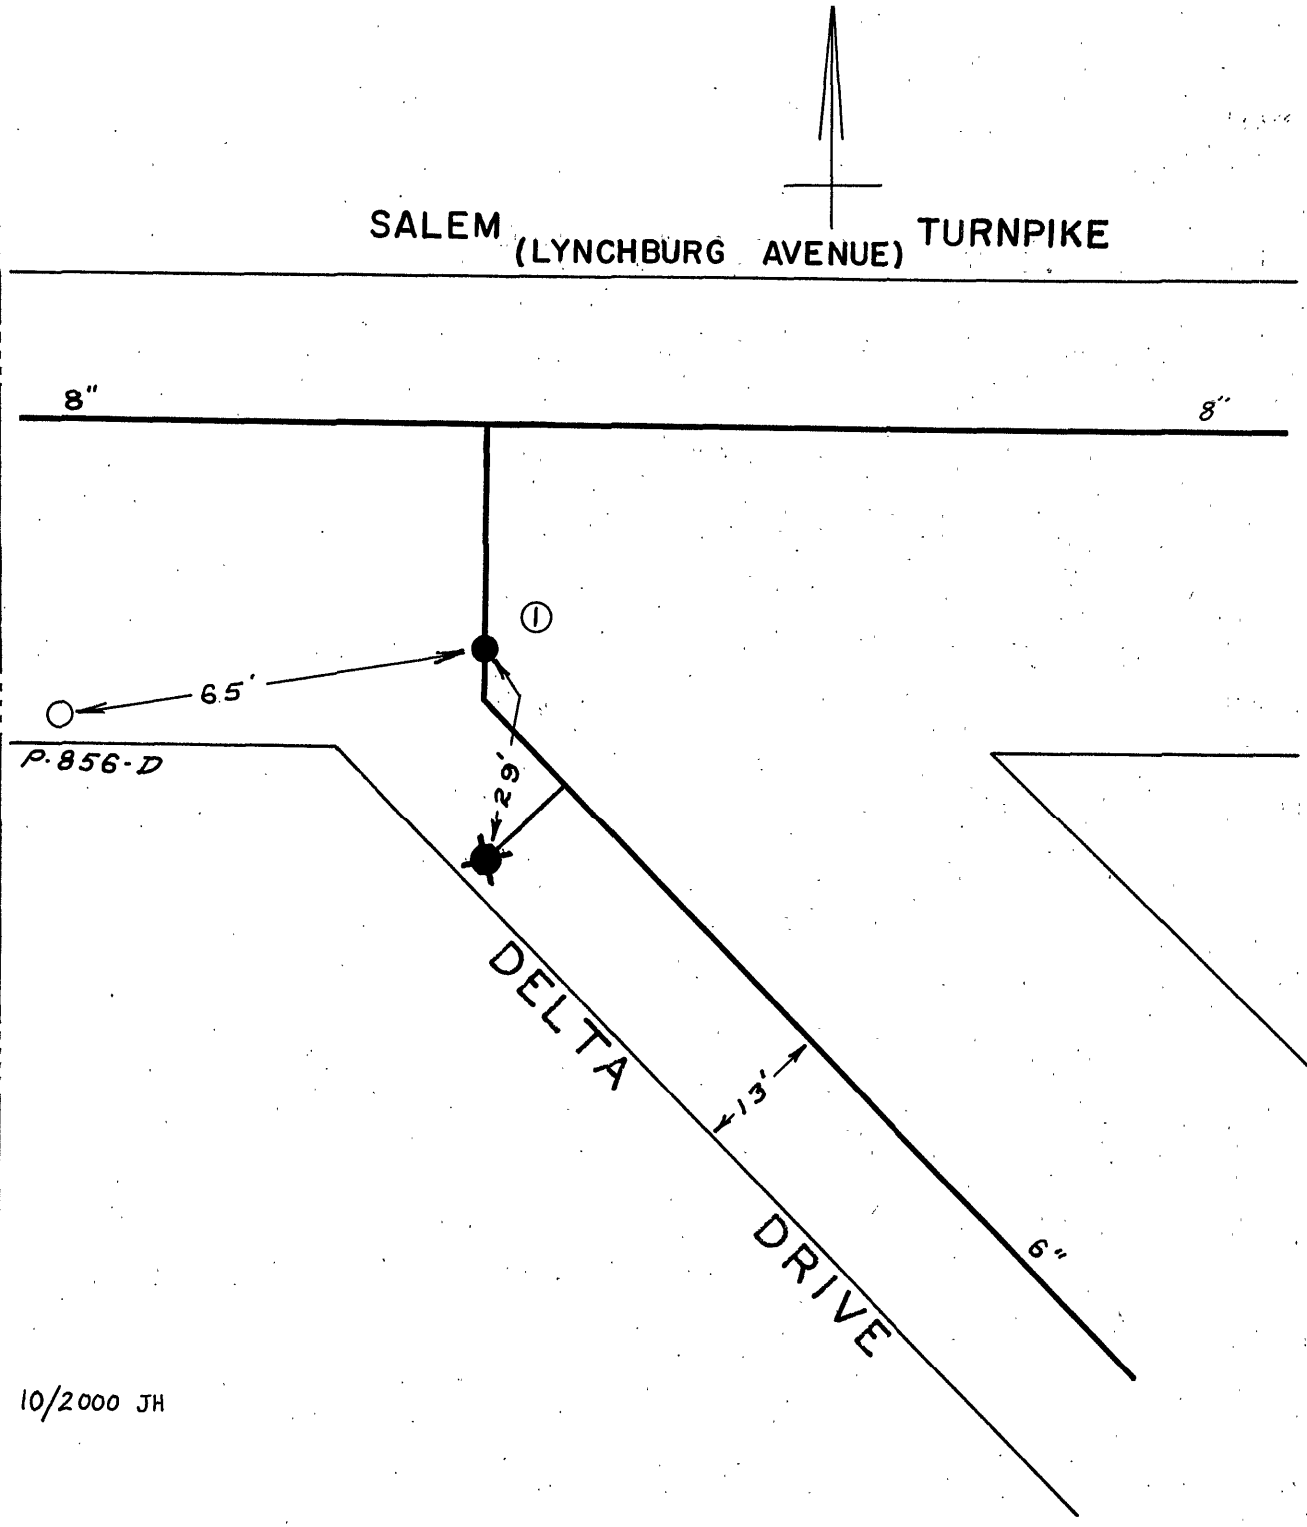

DATE	NO.	SIZE	MAKE	OPEN	TURNS
1951	1	6"	DARLING	R	20
	1	18'-N	SPL		

CITY OF ROANOKE—WATER DEPT.

VALVE DIAGRAM

DELTA DRIVE EAST END & SALEM TURNPIKE.

SEC. MAP 242 N.W.

DATE PAGE NO.

10/2000 JH

"IMPERIAL" TRACING CLOTH K & E CO., N. Y.