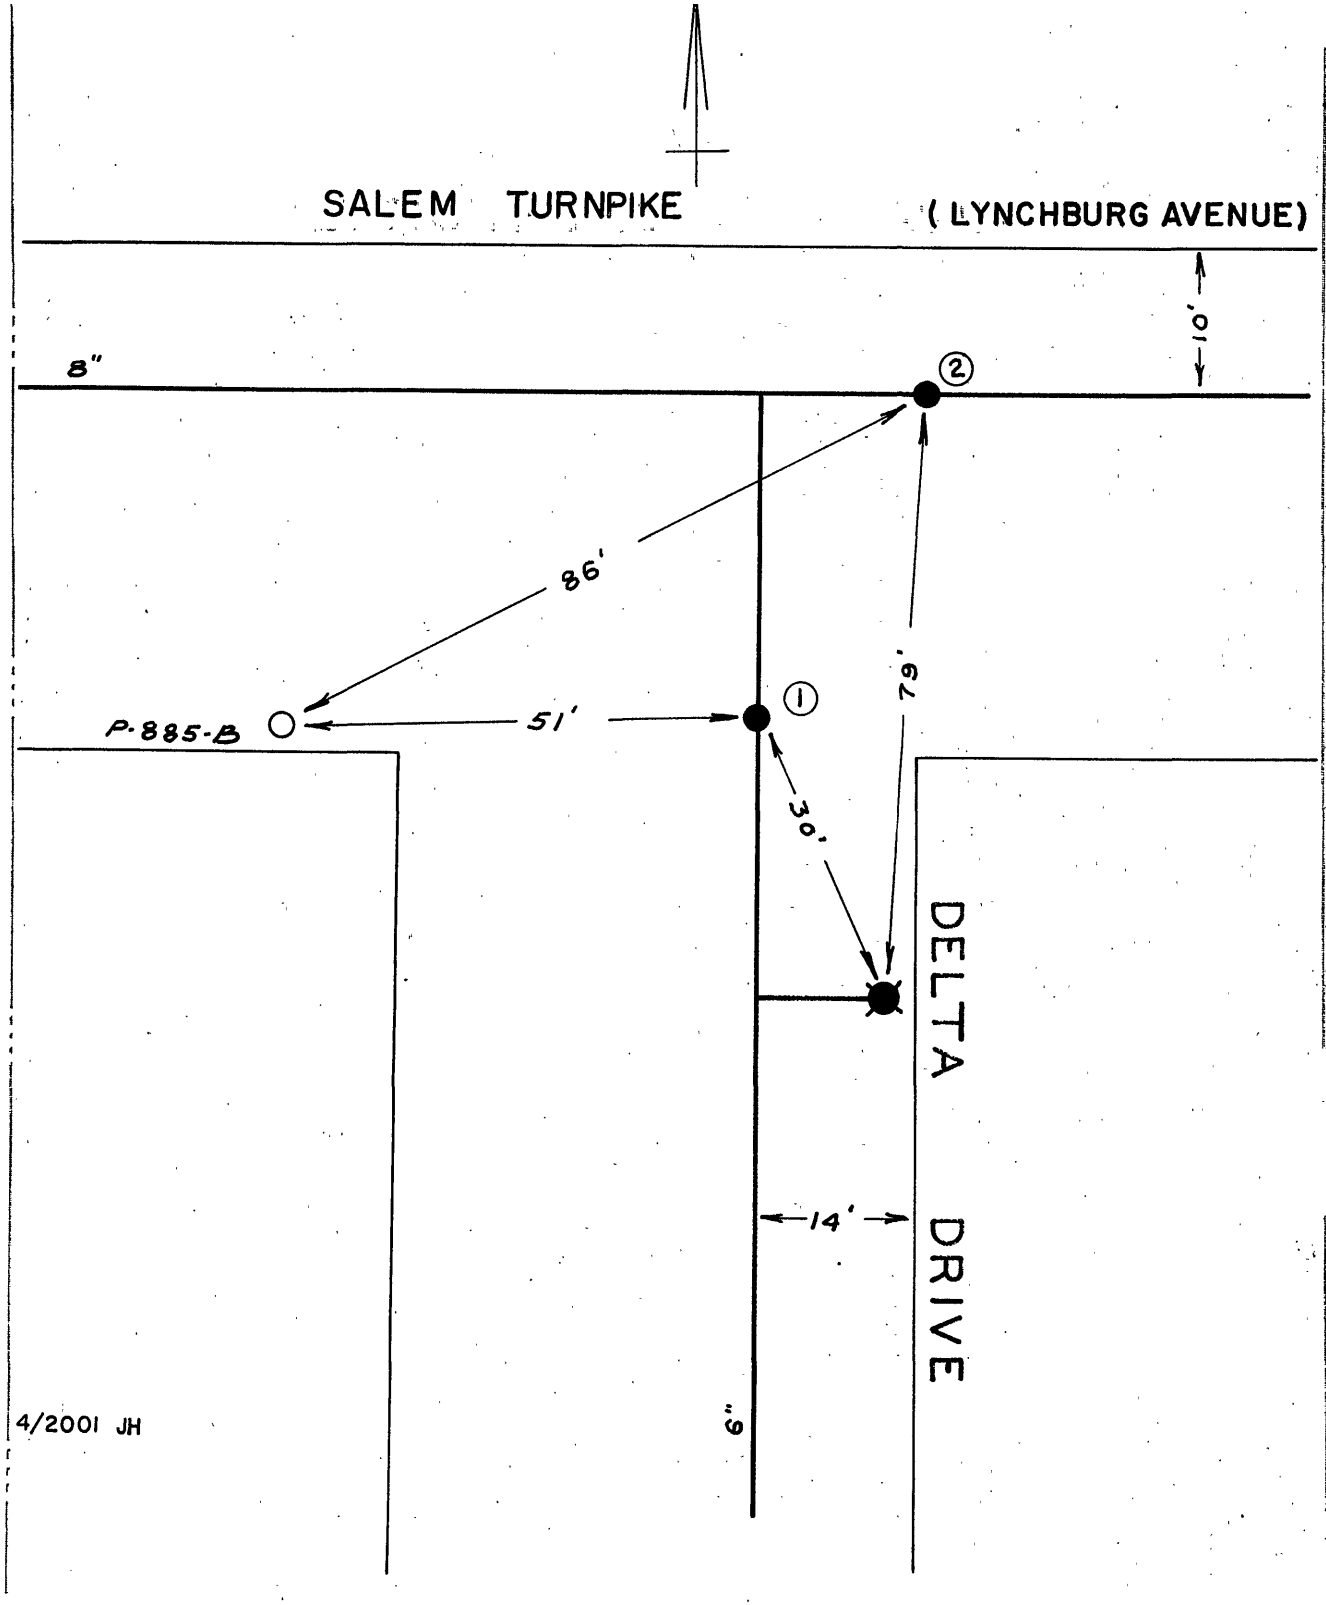

DATE	NO.	SIZE	MAKE	OPEN	TURNS
1951	1	6"	DARLING	R	20
1952	2	8"	DARLING	R	27
	1	4-N	SPL		
	2	0	EPL		

CITY OF ROANOKE — WATER DEPT.

VALVE DIAGRAM

DELTA DRIVE WEST END

& SALEM TURNPIKE

SEC. MAP 242 N.W.

DATE PAGE NO.

4/2001 JH

"IMPERIAL" TRACING CLOTH K & E CO., N. Y.