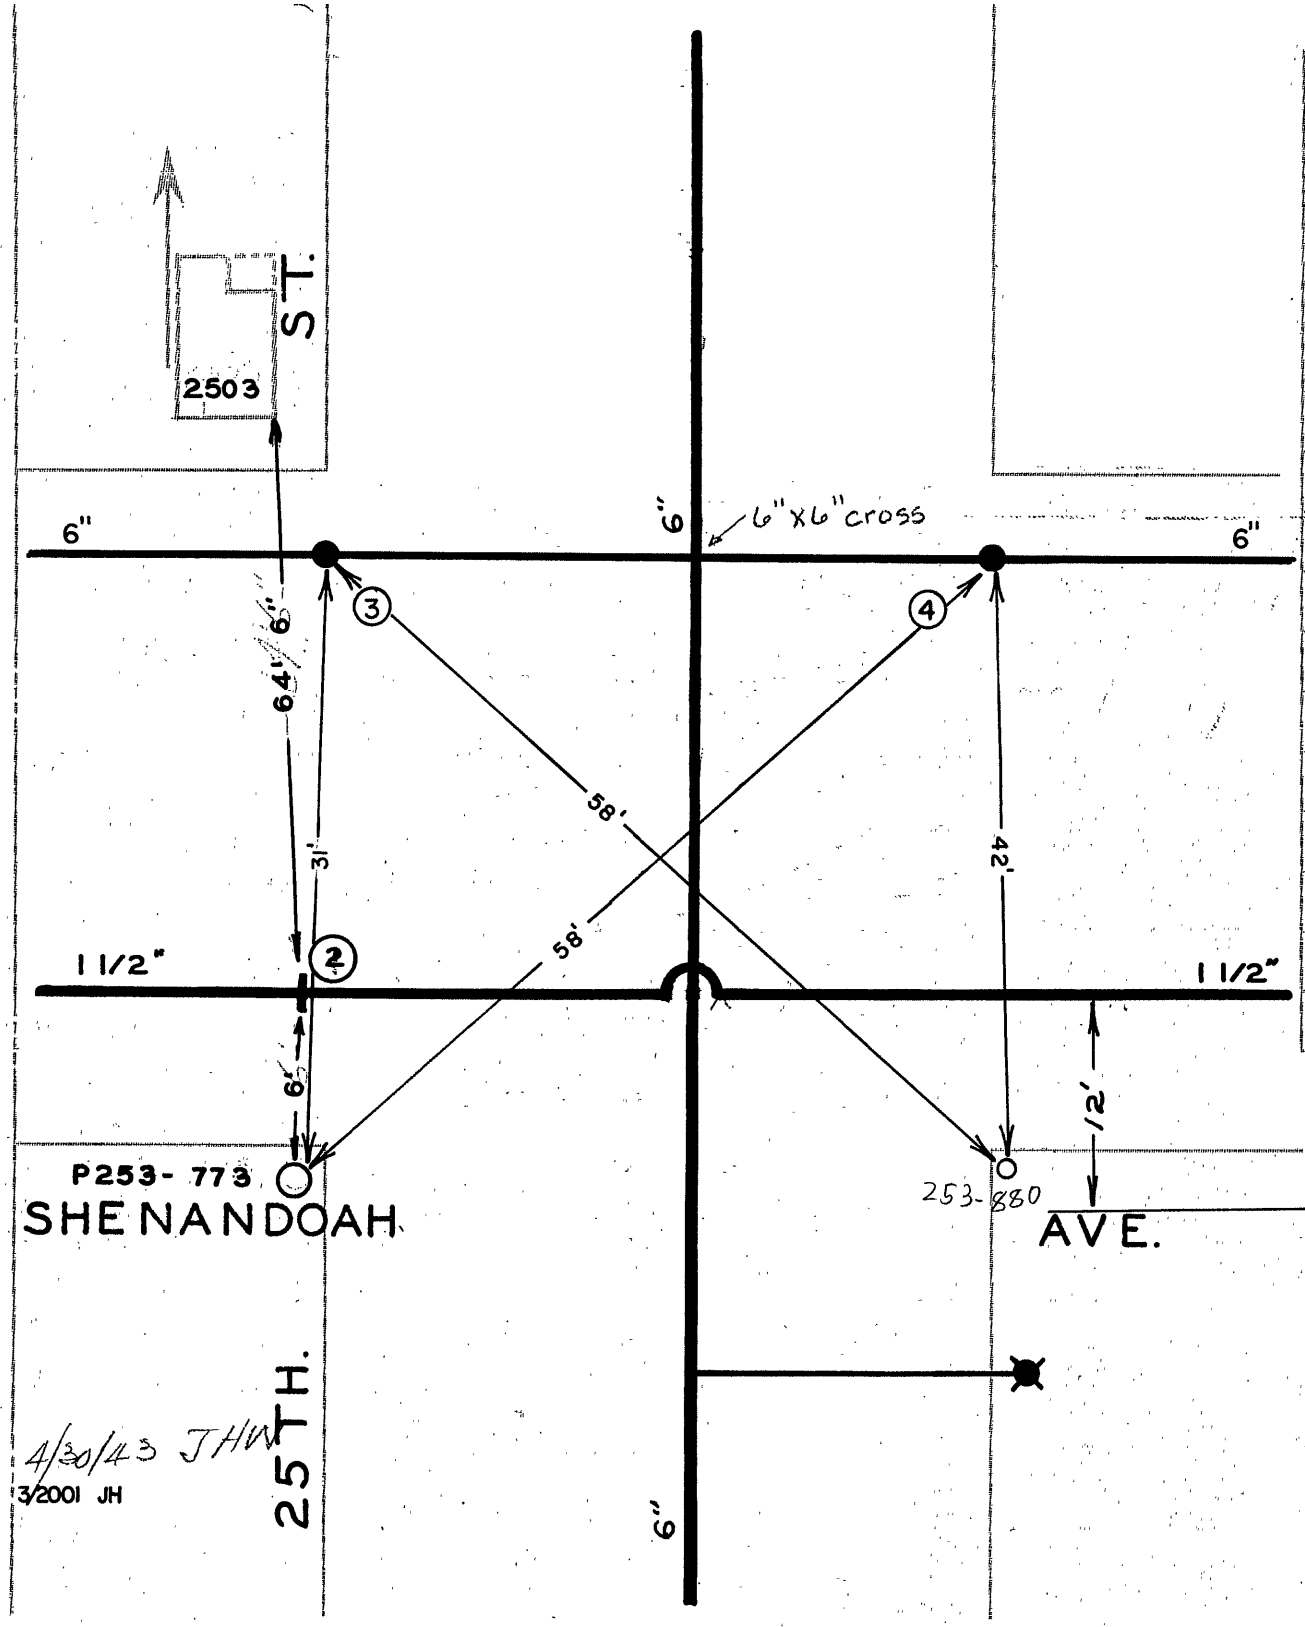

DATE	NO.	SIZE	MAKE	OPEN	TURNS
1923	2	11/2"		L	8
1974	3	6"	MUELLER	R	
1974	4	6"	MUELLER	R	
	2	0	WPL		

CITY OF ROANOKE—WATER DEPT

VALVE DIAGRAM

SHENANDOAH AVE. &

25 TH STREET

SEC. MAP 242, 241, N.W.

DATE PAGE NO. NW 239