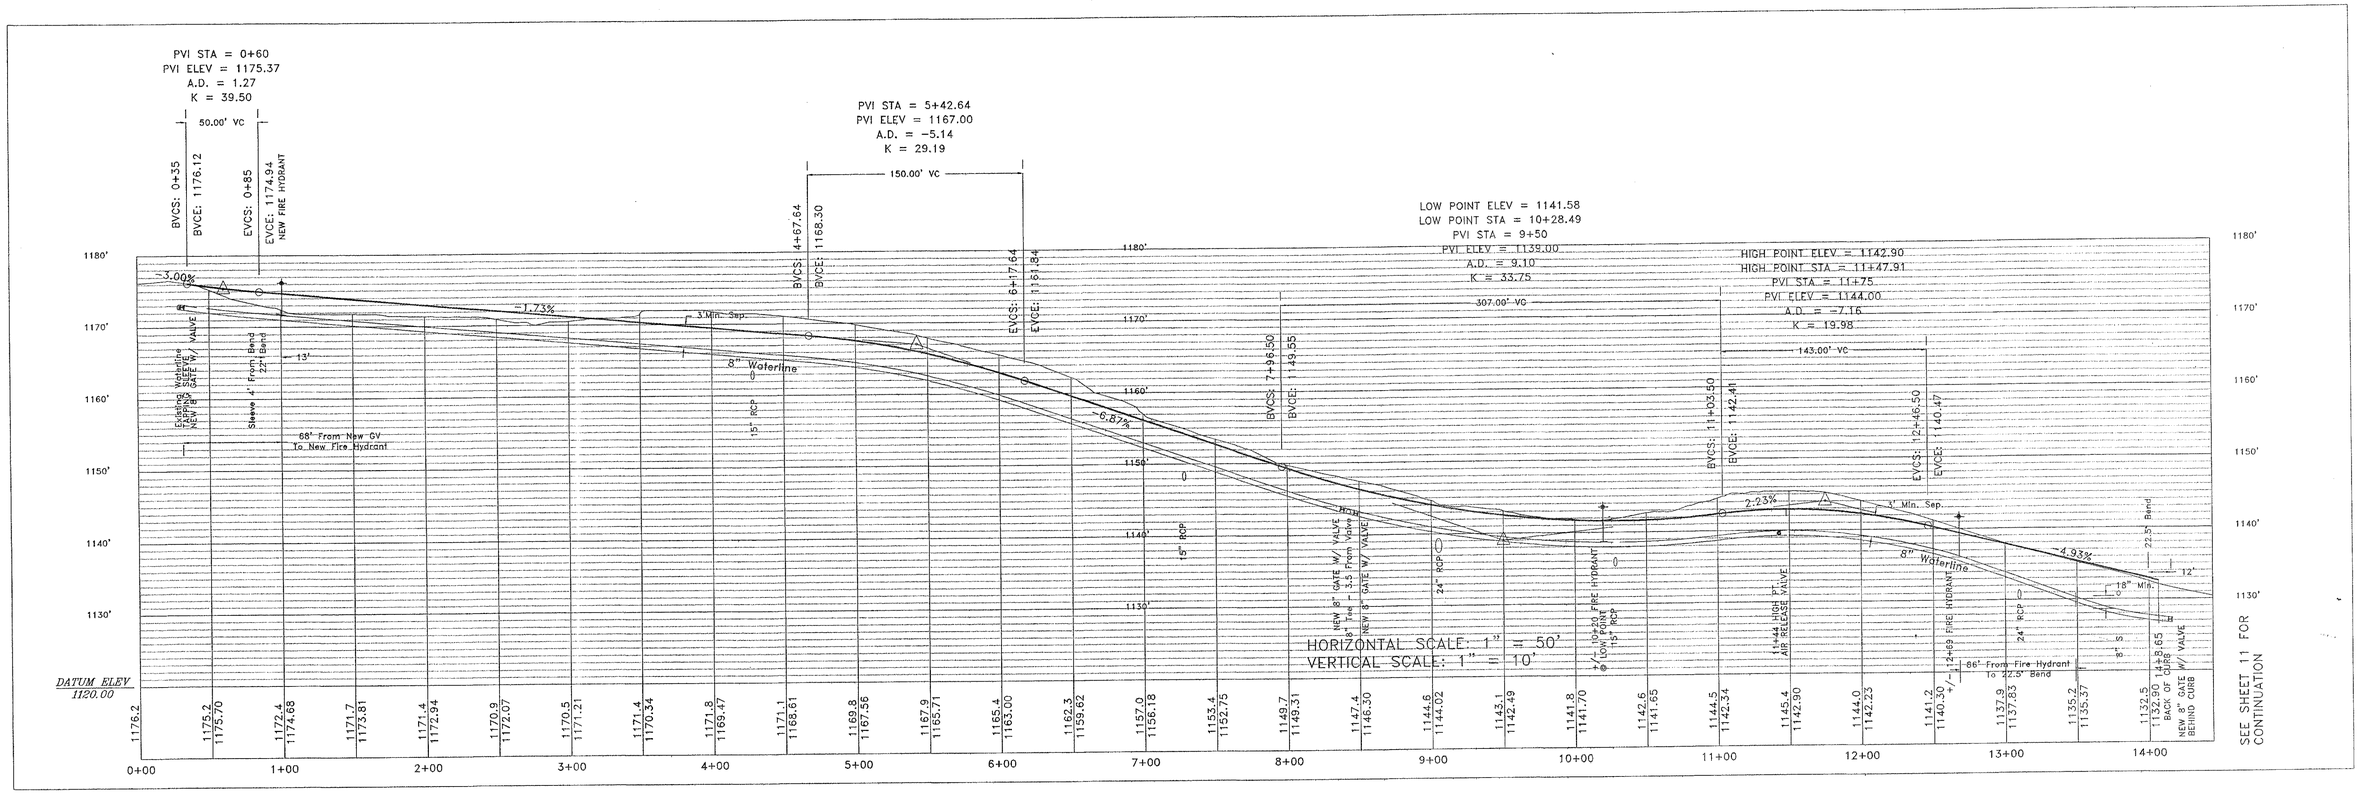

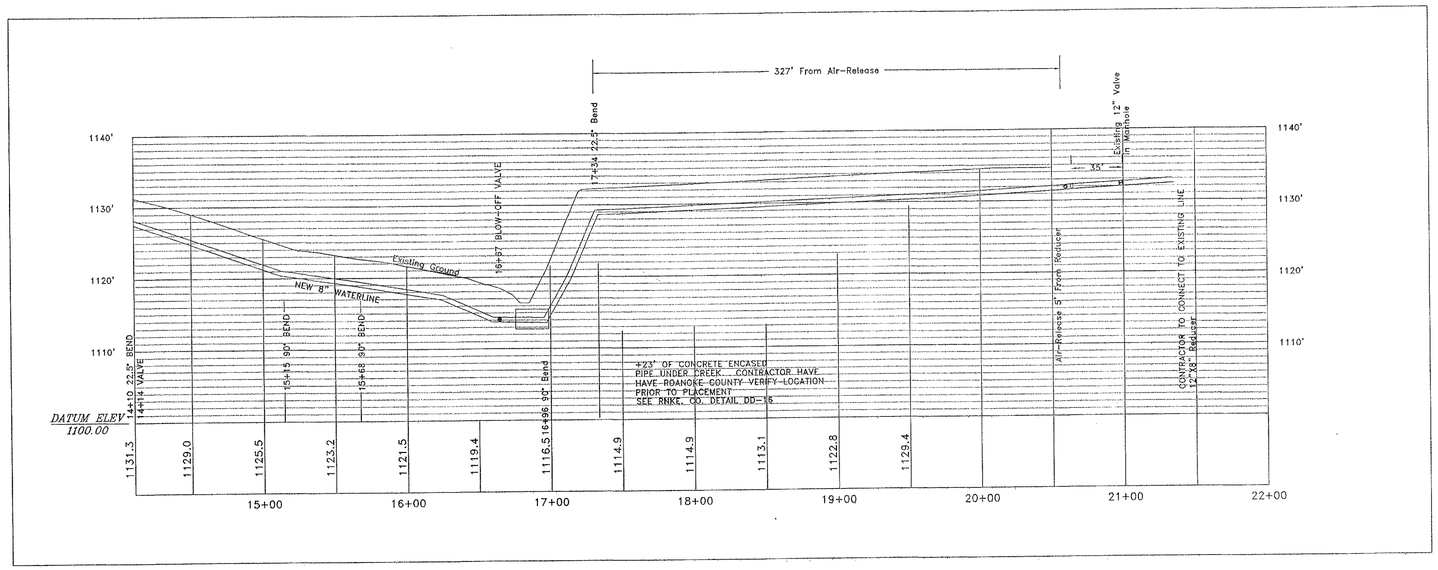

Roderick F. Pierson, P.E., L.L.S.
P.O. Box 311
1332 Roanoke Road, 220 North
Daleville, VA 24083
(540) 966-3027

REV	DATE	DESCRIPTION
1	10/01/01	PER COUNTY COMMENTS
2	11/12/01	PER COUNTY COMMENTS
3	12/20/01	PER COUNTY COMMENTS
4	02/12/02	PER COUNTY COMMENTS
5	10/30/02	AS-BUILTS

ROADWAY & WATERLINE PROFILE SHEET
LINNMEAD SUBDIVISION
ROANOKE COUNTY, VIRGINIA

COMMONWEALTH OF VIRGINIA
10-30-02
RODERICK F. PIERSON
NO. 023842
PROFESSIONAL ENGINEER

SCALE: 1" = 50'
COMM. NO. R200123
DATE: 04/25/01
SHEET 2 - A

PETERCRKPARSELL/SHT2

RC-9152