564'
~~PROPOSED 520'~~ 12" WATER MAIN
INSTALL PLUG
12" G.V.
8" S.D.
EXIST. SAN. 12" SEWER
EXIST. 6" WATER
EXIST. C&P
EXIST. C&P
24" S.D.
15" S.D.
15" S.D.
53' R/W
50' R/W
15" S.D.
53' R/W
GAS
12" S.D.
EXIST. SAN. 12" SEWER
36" x 42" S.D.
EXIST. GAS
24" S.D.
EXIST. S.S. 8"
TRAFFIC LIGHT
— TIE-IN NEW 12" MAIN TO EXIST 30" MAIN AT NEW GATE VALVE
— REMOVE B.O. & INSTALL 12" G.V.
D.I.
BLOW OFF
D=15.0'
S.S.
GAS
30" W
CURB
50' R/W
CURB
STREET
INSERT A-A
S.S.
GAS
6" W
AVENUE
LUCK
LIGHT POLE
LIGHT POLE
EXIST 1" W TO BE ABANDONED
LIGHT POLE
LIGHT POLE
LIGHT POLE
LIGHT POLE
EXIST. 30" W
EXIST. GAS
EXIST. GAS
EXIST. S.S.
FIRST BAPTIST CHURCH
515 THIRD STREET
3 RD
MARSHALL
AVENUE

NOTE: ALL UTILITIES TO BE ASCERTAINED IN FIELD PRIOR TO CONSTRUCTION.

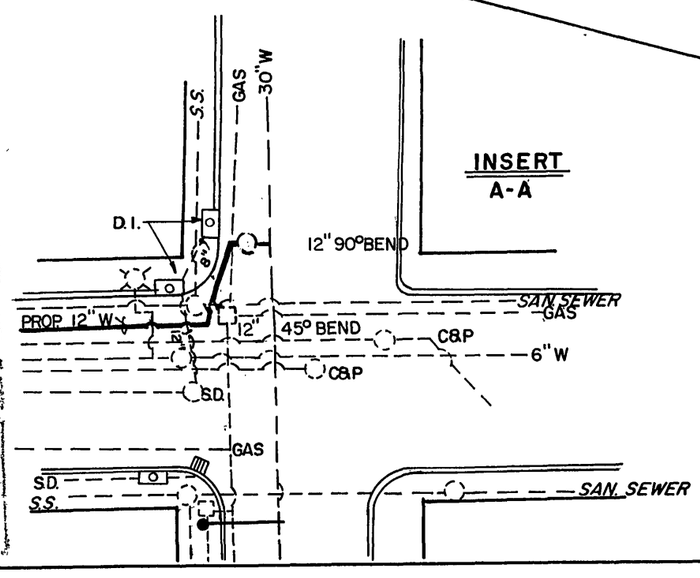

DATE STARTED	6-8-91			
DATE COMP.	7-2-1991			
FEET MAIN	SIZE	VALVE	VAULT	BOX
564'	12"	1	1	#2
F.H. COMP. 1	4 1/2"	6"	1	#2
F.H. STUB ONLY				
SERV. INS. BY:				
MAIN INS. BY:	CHUCK CLARK			
NO. 3/4" SERV. INS.				
CITY OR CO.	CITY			
DEPT. INSP.	U.L.S.			

MANAGER UTILITY LINES SERVICE

WATER DEPARTMENT
ROANOKE VIRGINIA

LUCK AVENUE
AND
THIRD STREET, S.W.

SCALE: 1"=50'	2/20/91 DIRECTOR UTILITIES & OPERATIONS DATE
DATE: 2-19-91	4/26/91 DIRECTOR OF PUBLIC WORKS DATE
DIST. MAP: 101	
PLAN NO.: 91-02	