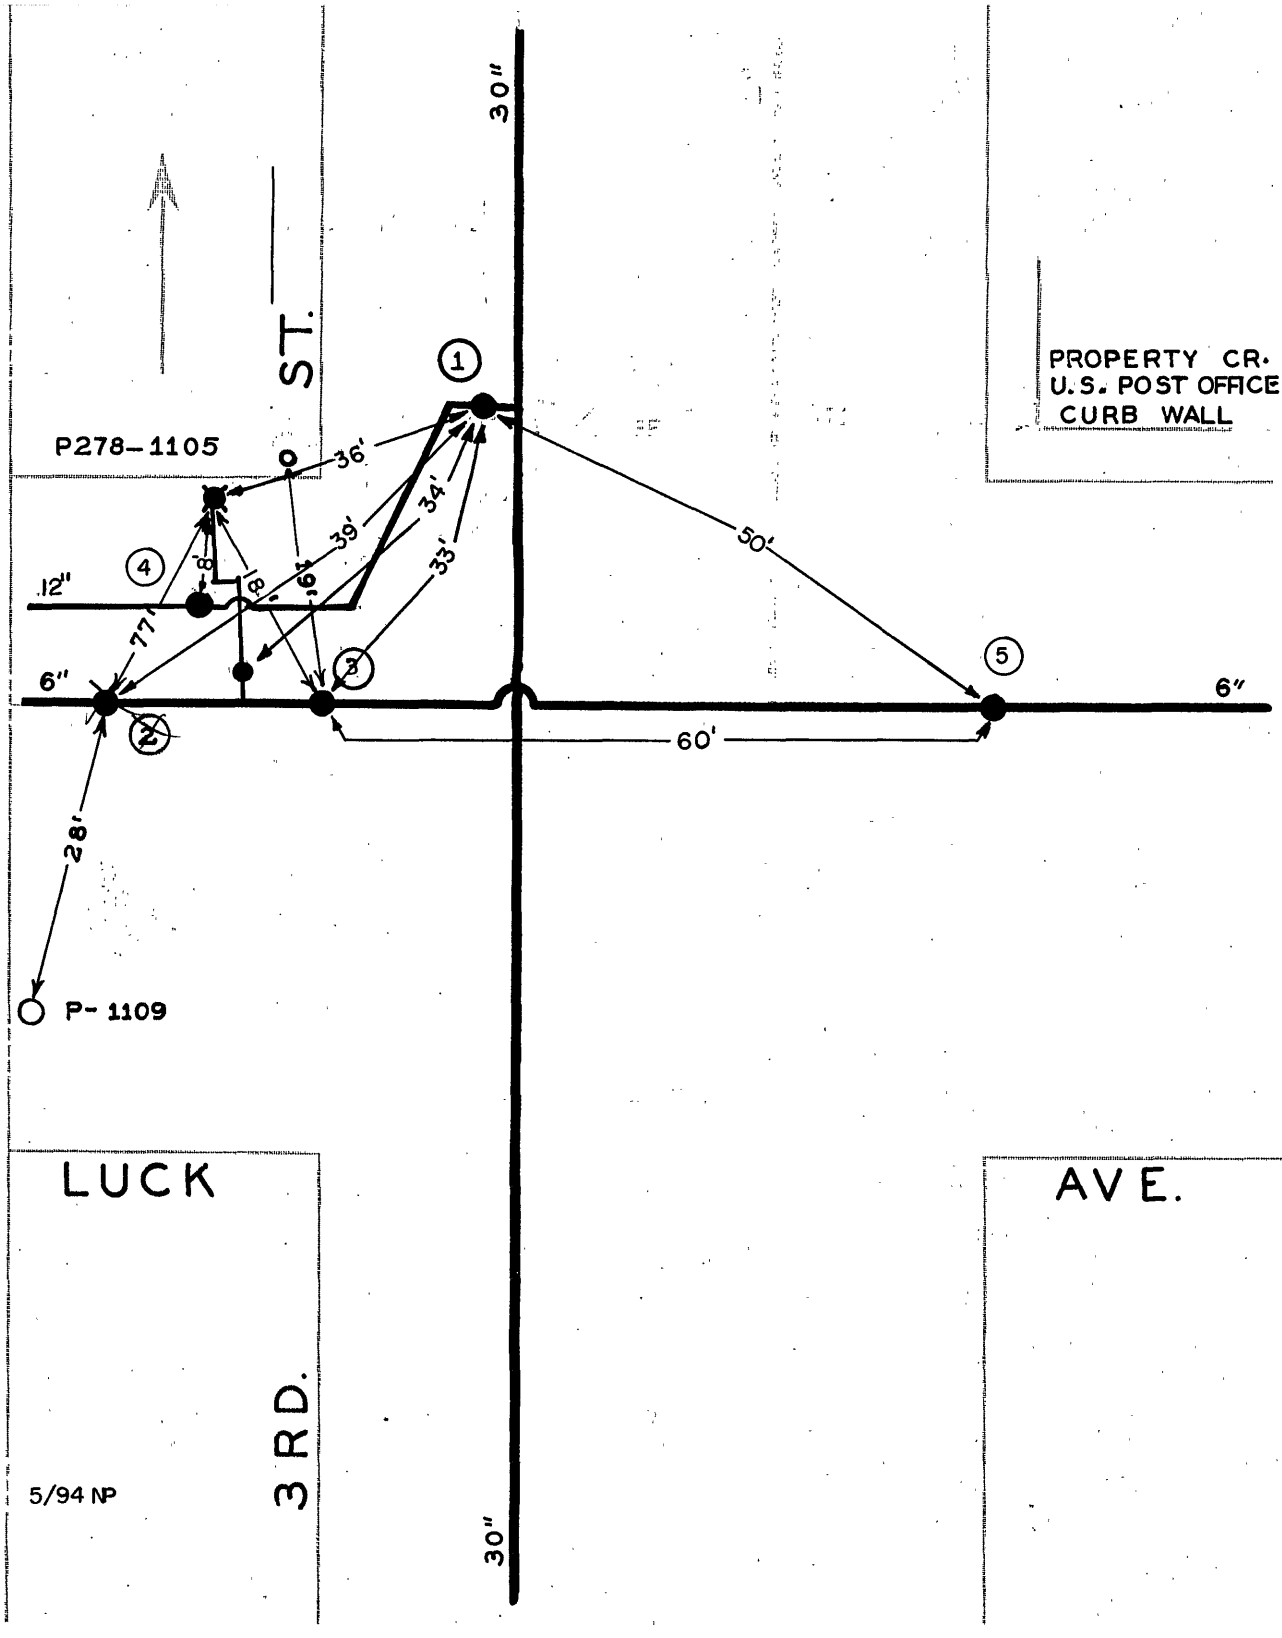

DATE	NO.	SIZE	MAKE	OPEN	TURNS
1946	1	8"	M. & H.	L	18
~~1892~~	~~2~~	~~6"~~			
1892	3	6"		L	21
1991	4	12"	MUELLER	R	39
1892	5	6"		L	21
	1	22'N	N.P.L.		
	2	82'W	W.P.L.		
	3	0'	W.P.L.		

CITY OF ROANOKE—WATER DEP'T

VALVE DIAGRAM

LUCK AVENUE & 3RD STREET S W

SEC. MAP 101

DATE PAGE NO. SW 551