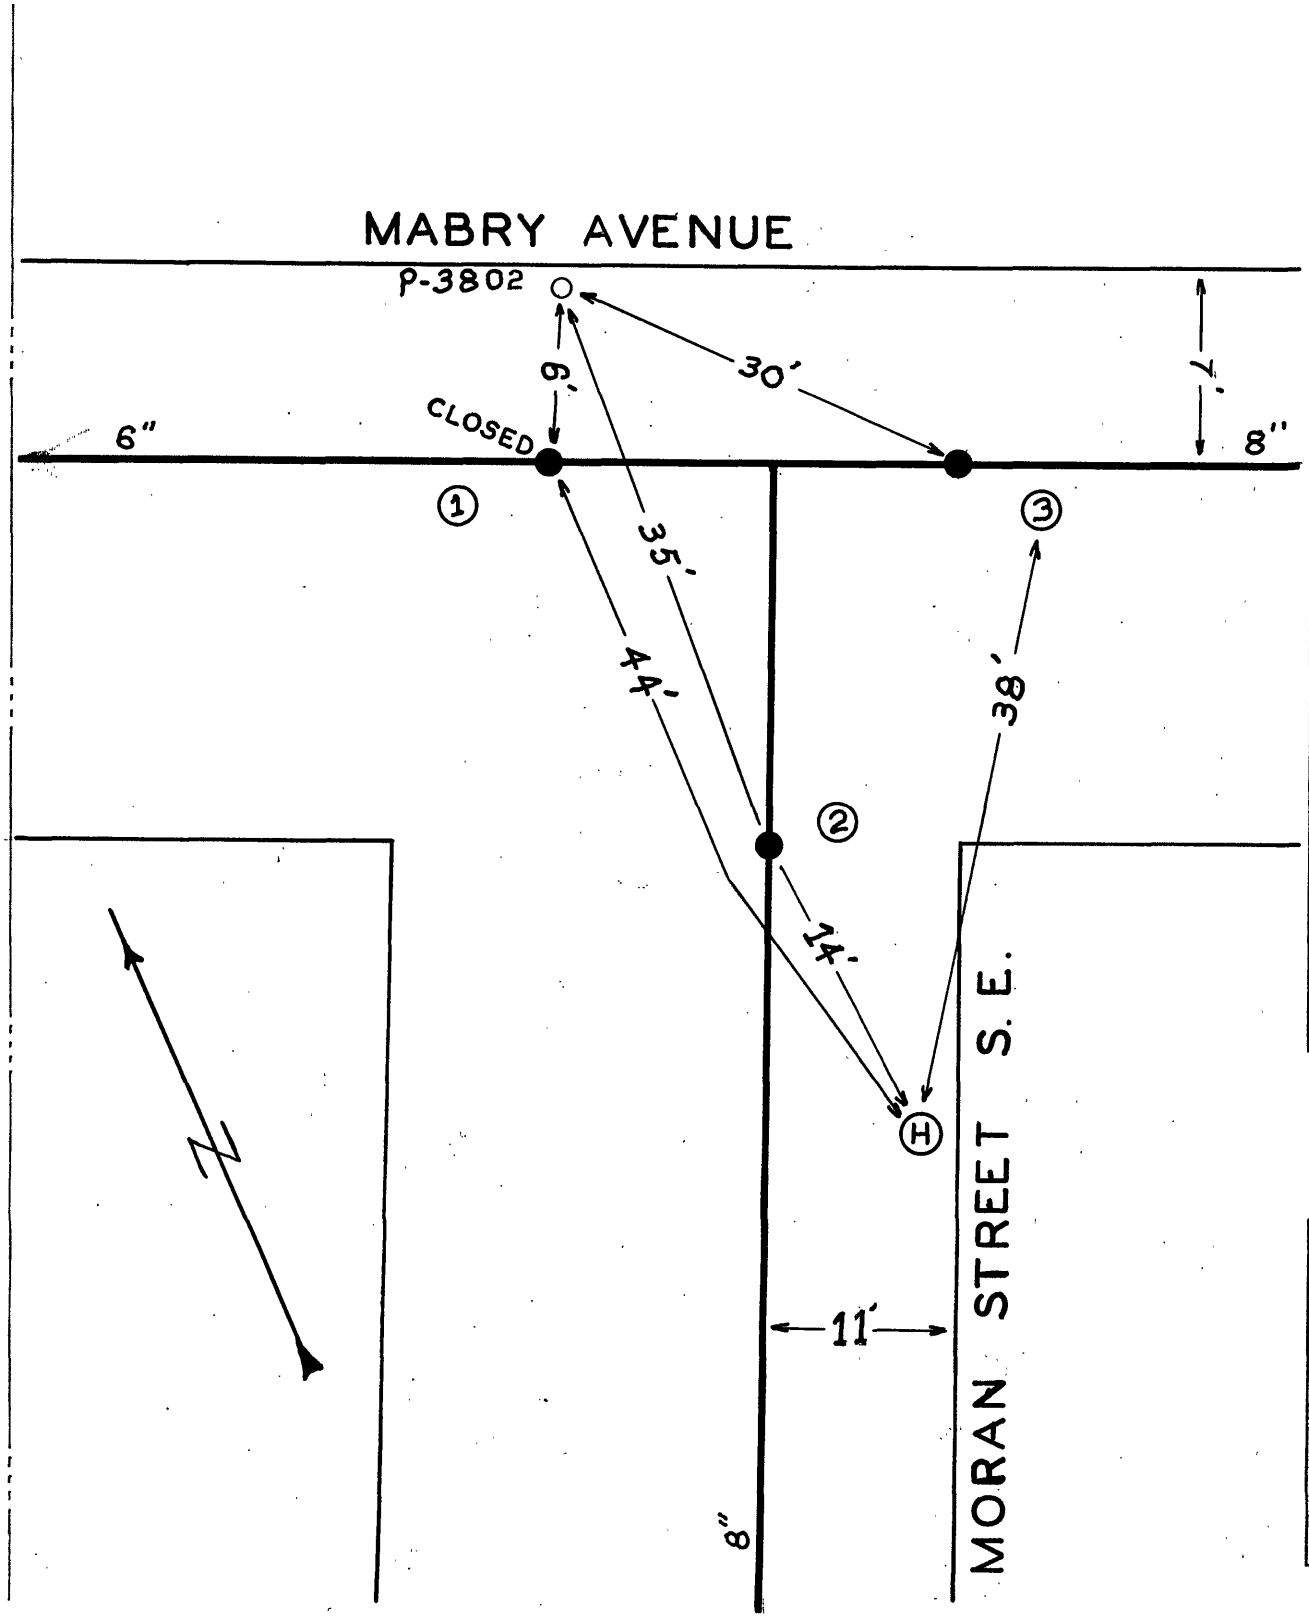

DATE	NO.	SIZE	MAKE	OPEN	TURNS
1953	1	6"	MUELLER	R	20
1953	2	8"	MUELLER	R	27
1953	3	8"	MUELLER	R	20
	1	6'-E	WPL		
	2	0	SPL		
	3	0	EPL		

CITY OF ROANOKE—WATER DEPT.

VALVE DIAGRAM

MABRY AVENUE &

MORAN STREET S.E.

SEC. MAP 438

DATE PAGE NO.

"IMPERIAL" TRACING CLOTH K & E CO., N. Y.

218-x