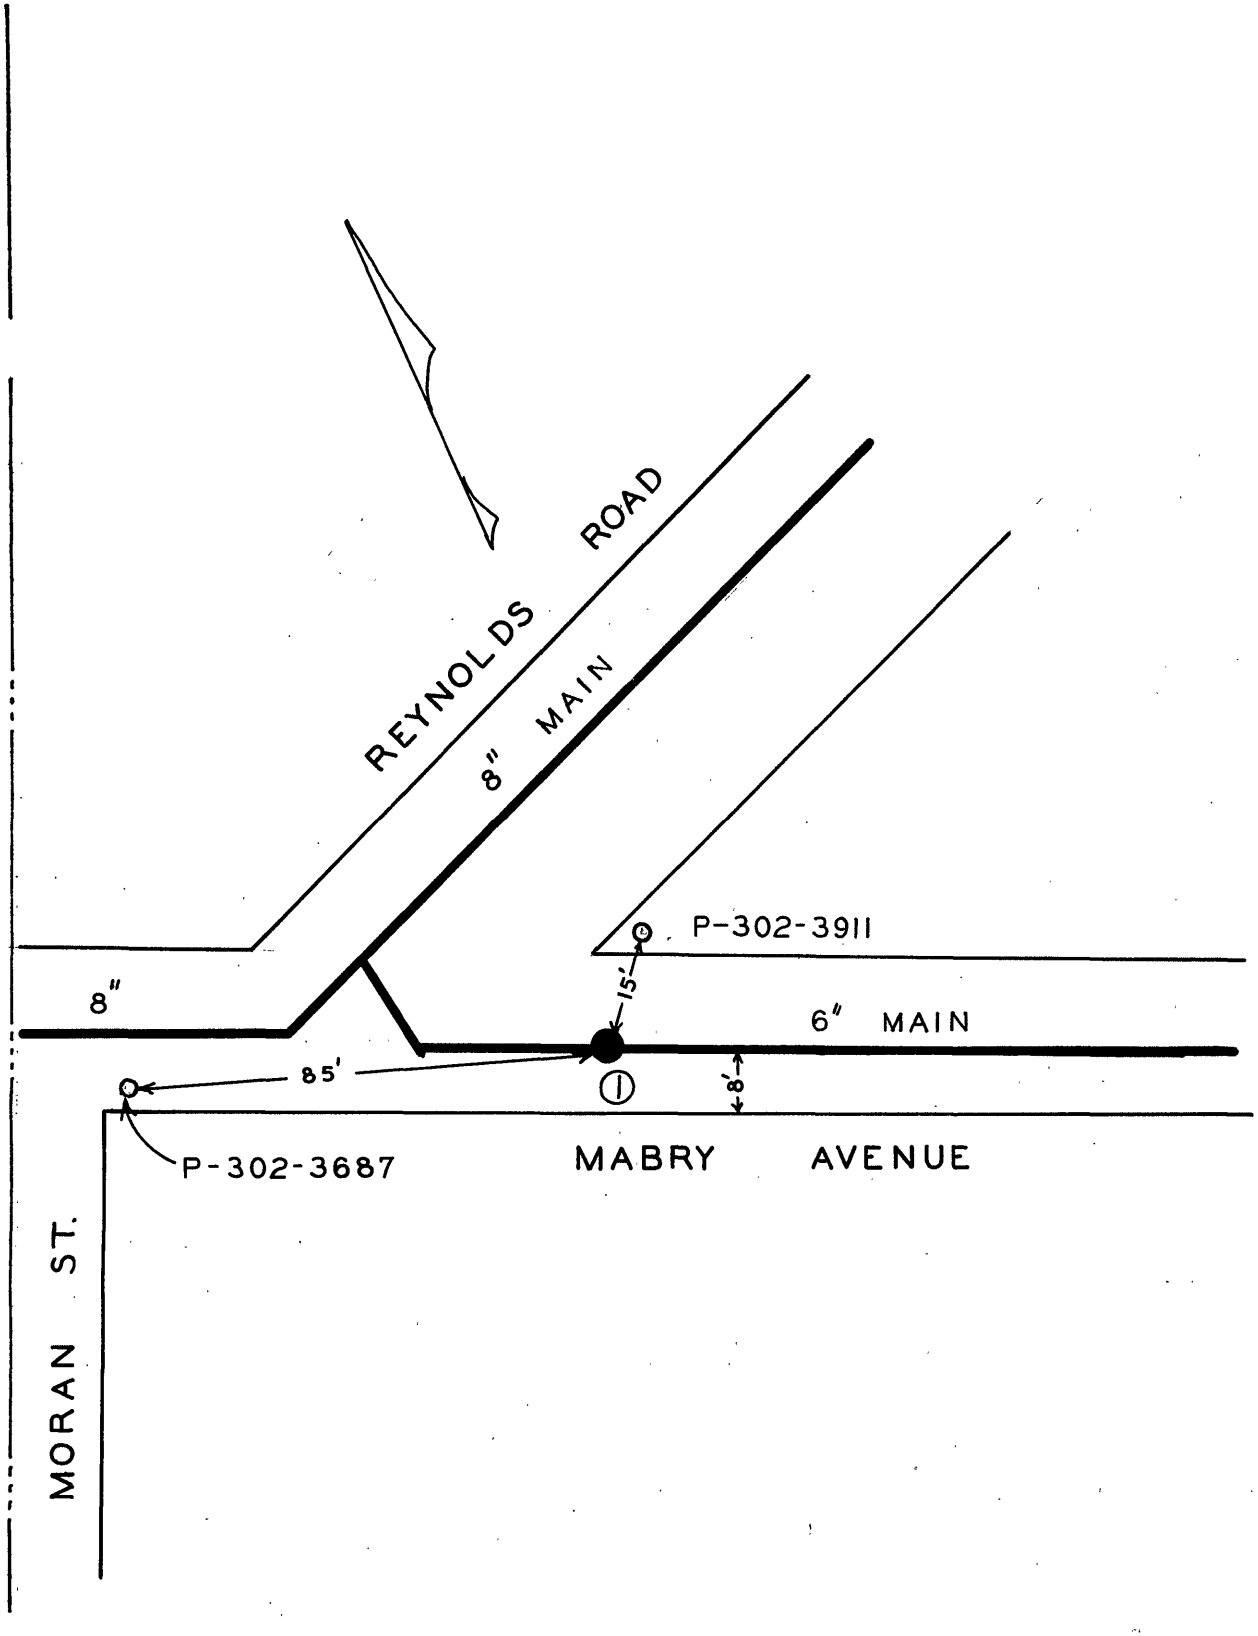

DATE	NO.	SIZE	MAKE	OPEN	TURNS
1966	1	6	MUELLER	K	
	1	0	EPL		

CITY OF ROANOKE—WATER DEPT.

VALVE DIAGRAM

MABRY AVENUE &

REYNOLDS RD. S.E.

SEC. MAP 438

DATE **PAGE NO.**