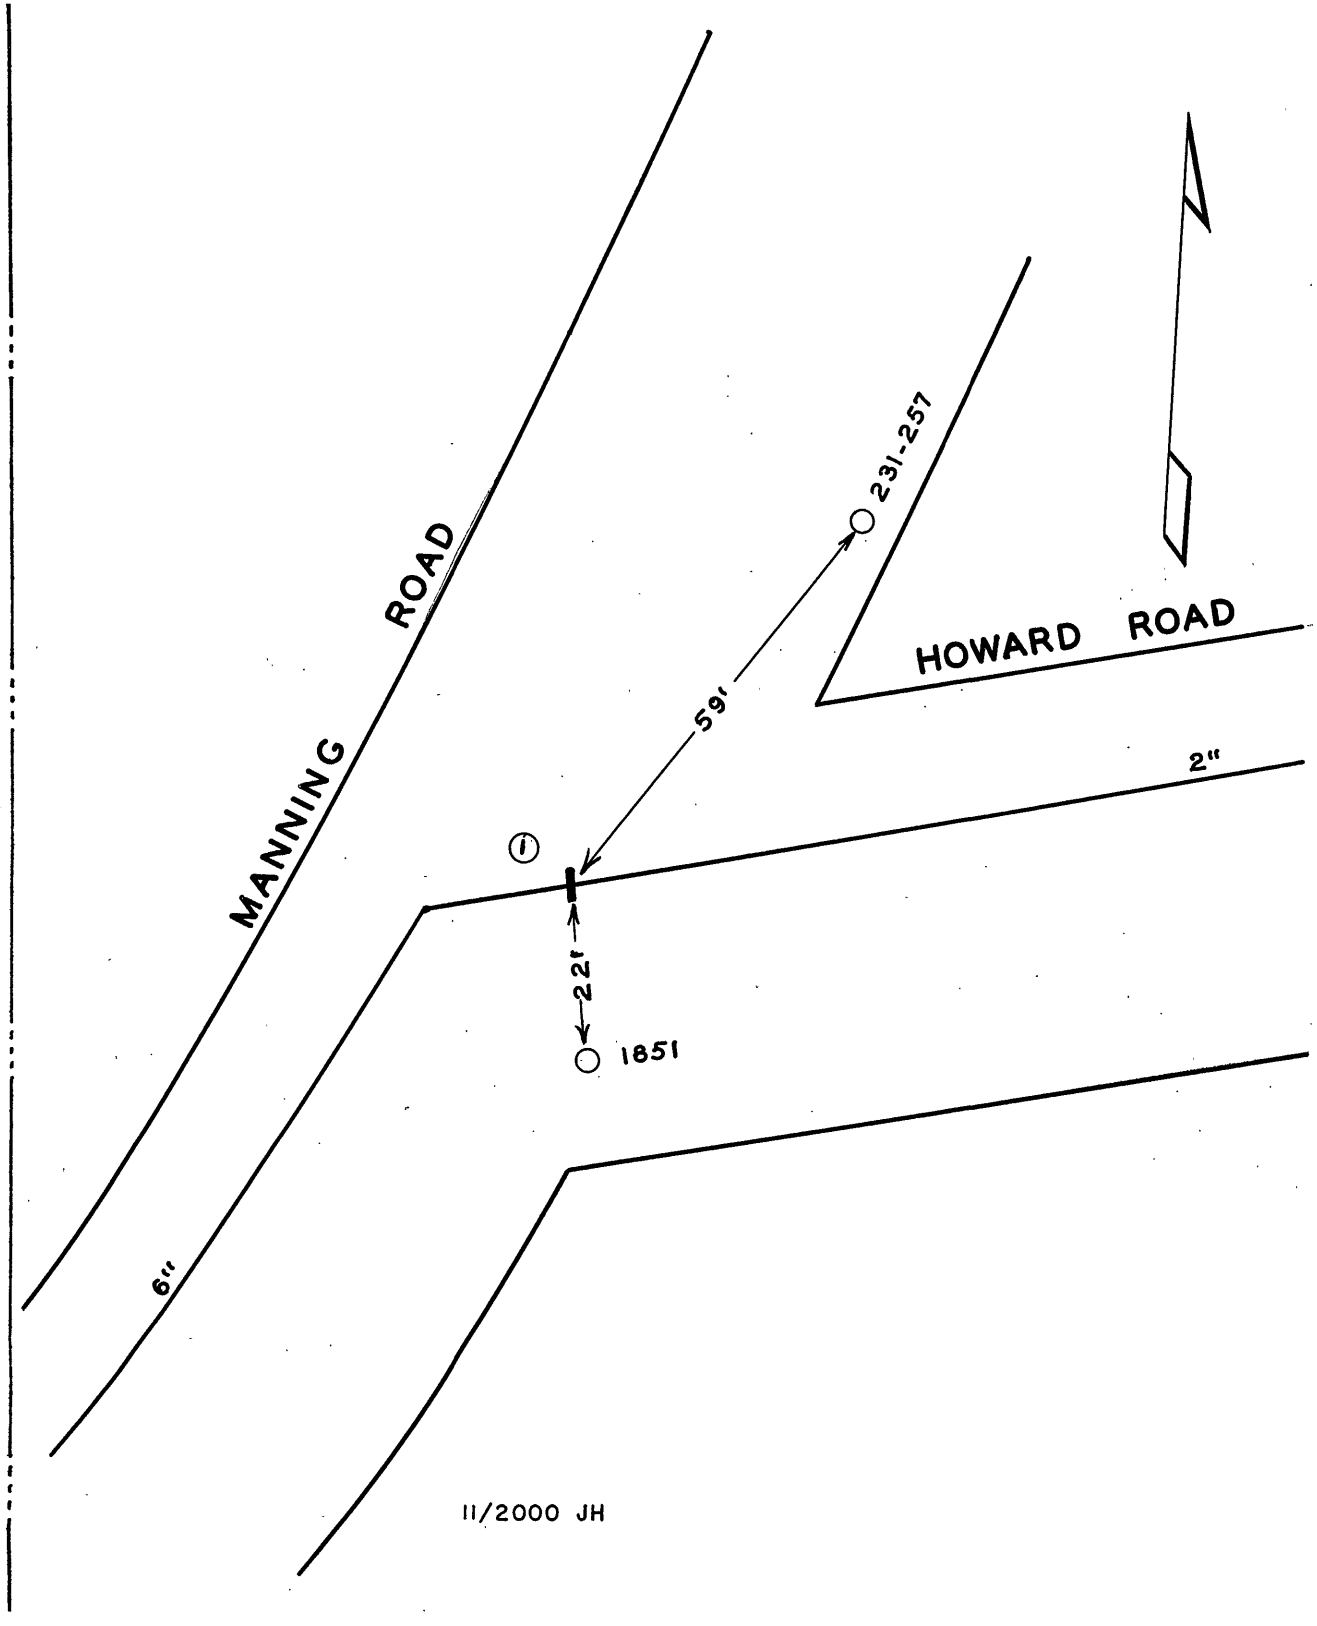

DATE	NO.	SIZE	MAKE	OPEN	TURNS
11-63	1	2"	MUELLER	R	

CITY OF ROANOKE—WATER DEPT.

VALVE DIAGRAM

HOWARD ROAD &

MANNING ROAD

SEC. MAP 712 N.E.

DATE PAGE NO.