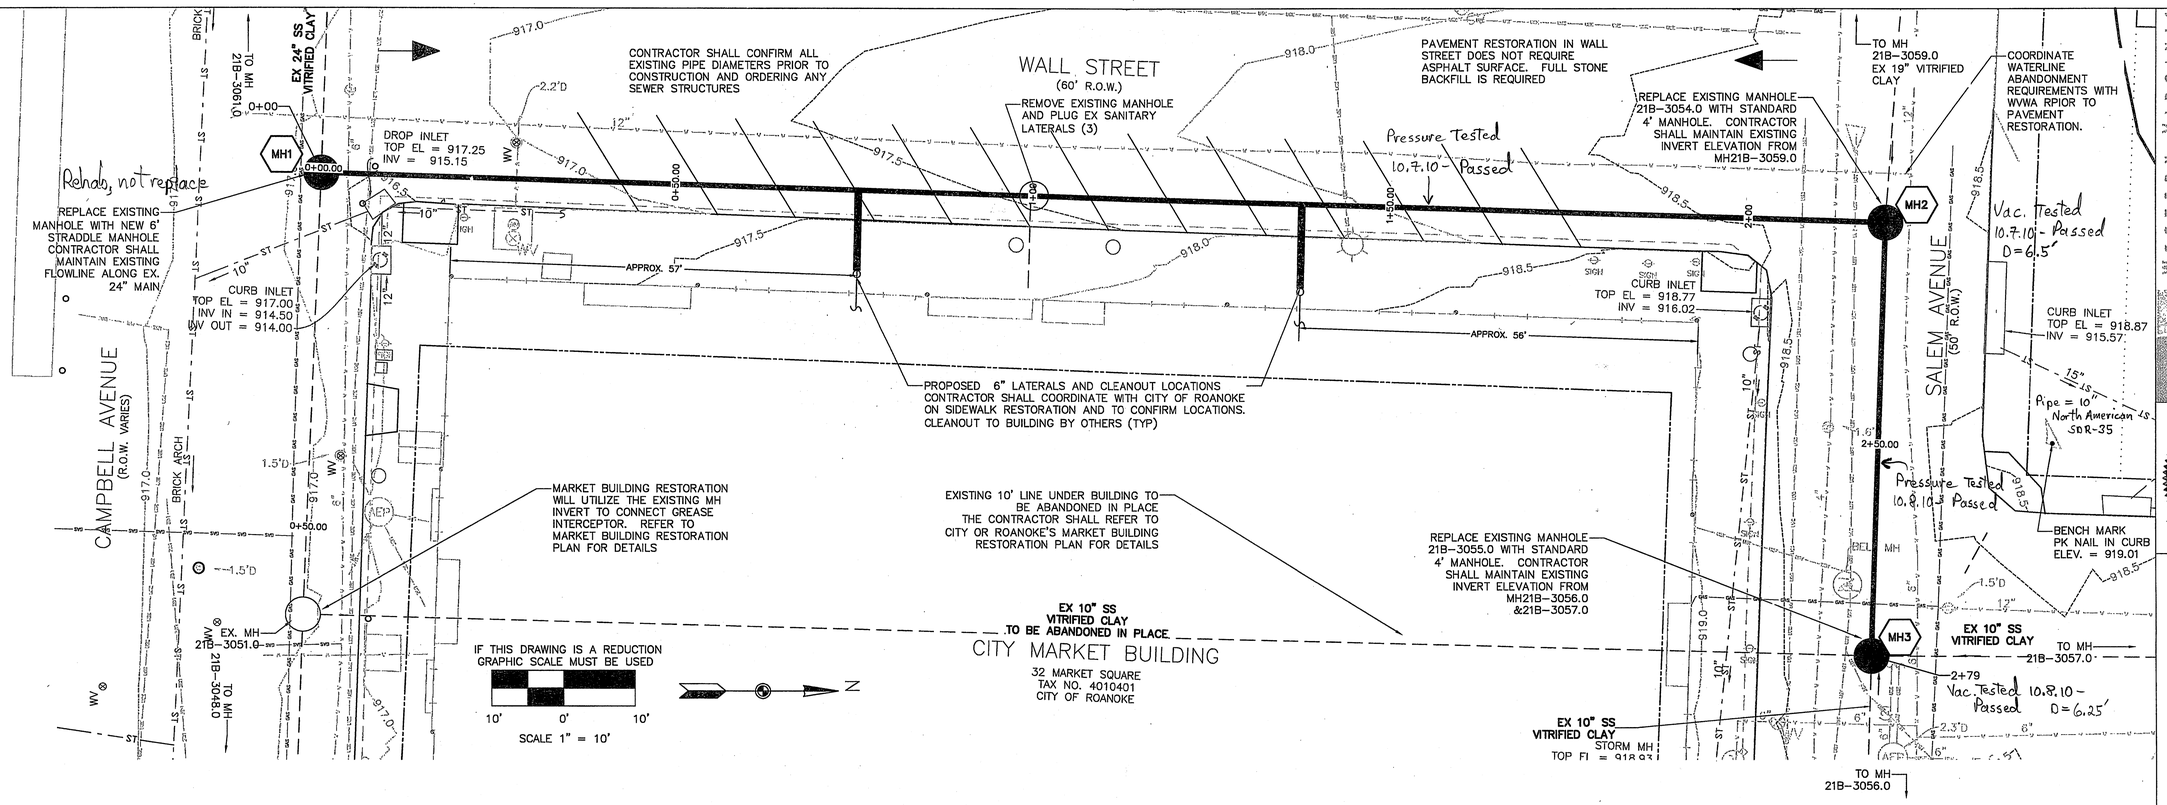

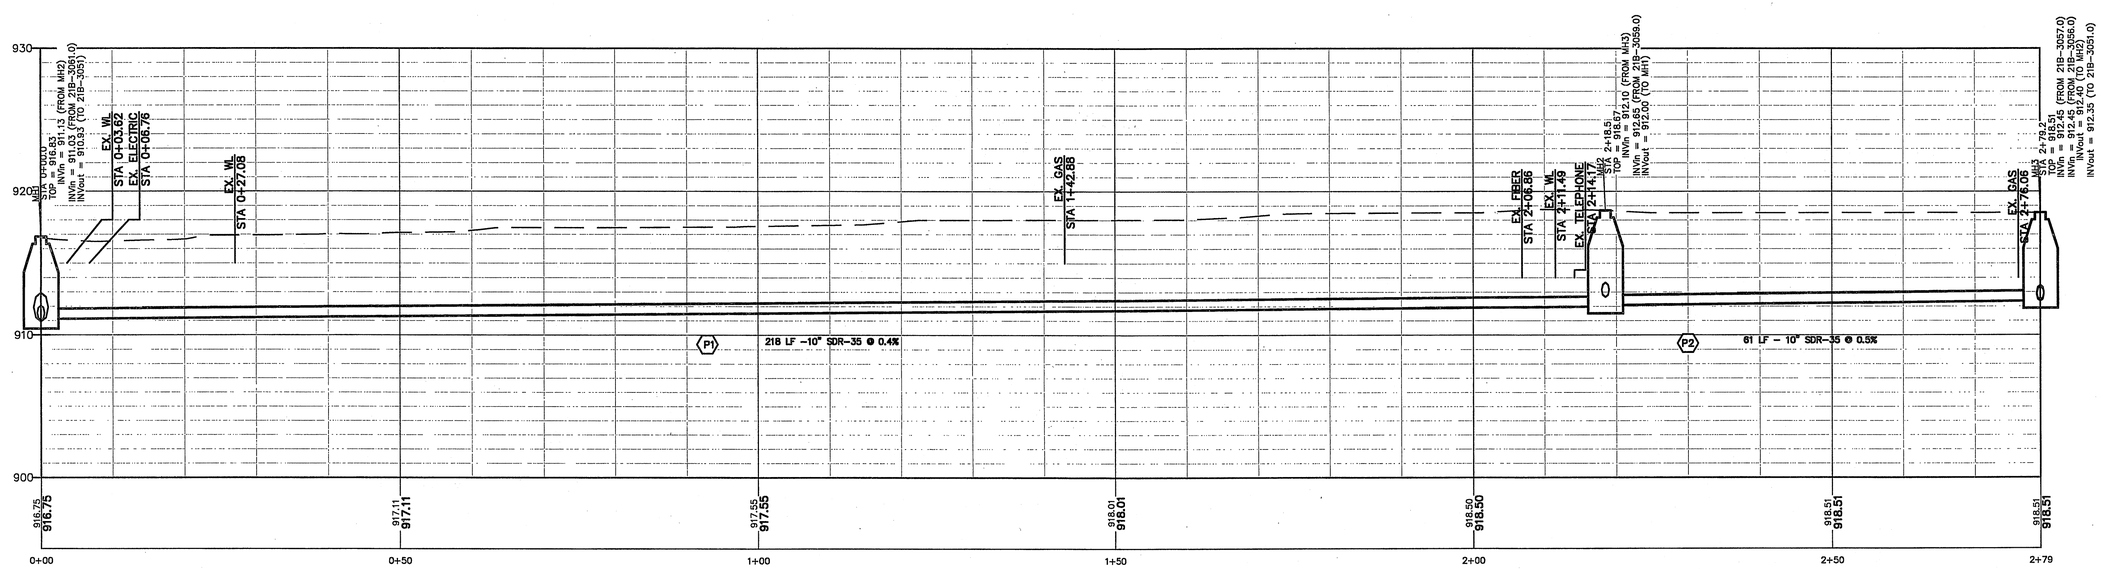

PROPOSED 10" SANITARY SEWER
SCALE:
VERT.: 1"=5'
HORZ: 1"=10'

WESTERN VIRGINIA WATER AUTHORITY
ENGINEERING SERVICES
601 S JEFFERSON ST, SUITE 300
ROANOKE, VA 24011
540-853-5641 or 540-853-5770

COMMONWEALTH OF VIRGINIA
Lic. No. 027721
10.8.10
PROFESSIONAL ENGINEER
APPROVED

MARKET BUILDING SEWER
PLAN AND PROFILE

Rev	Description	Date	By

Designed: AAS
Drawn: AAS
Checked: JGR
Approved: JGR
Date: 07/16/10
Project:

Sheet 2 of 3

As-Built 10.8.10 K. Winslow