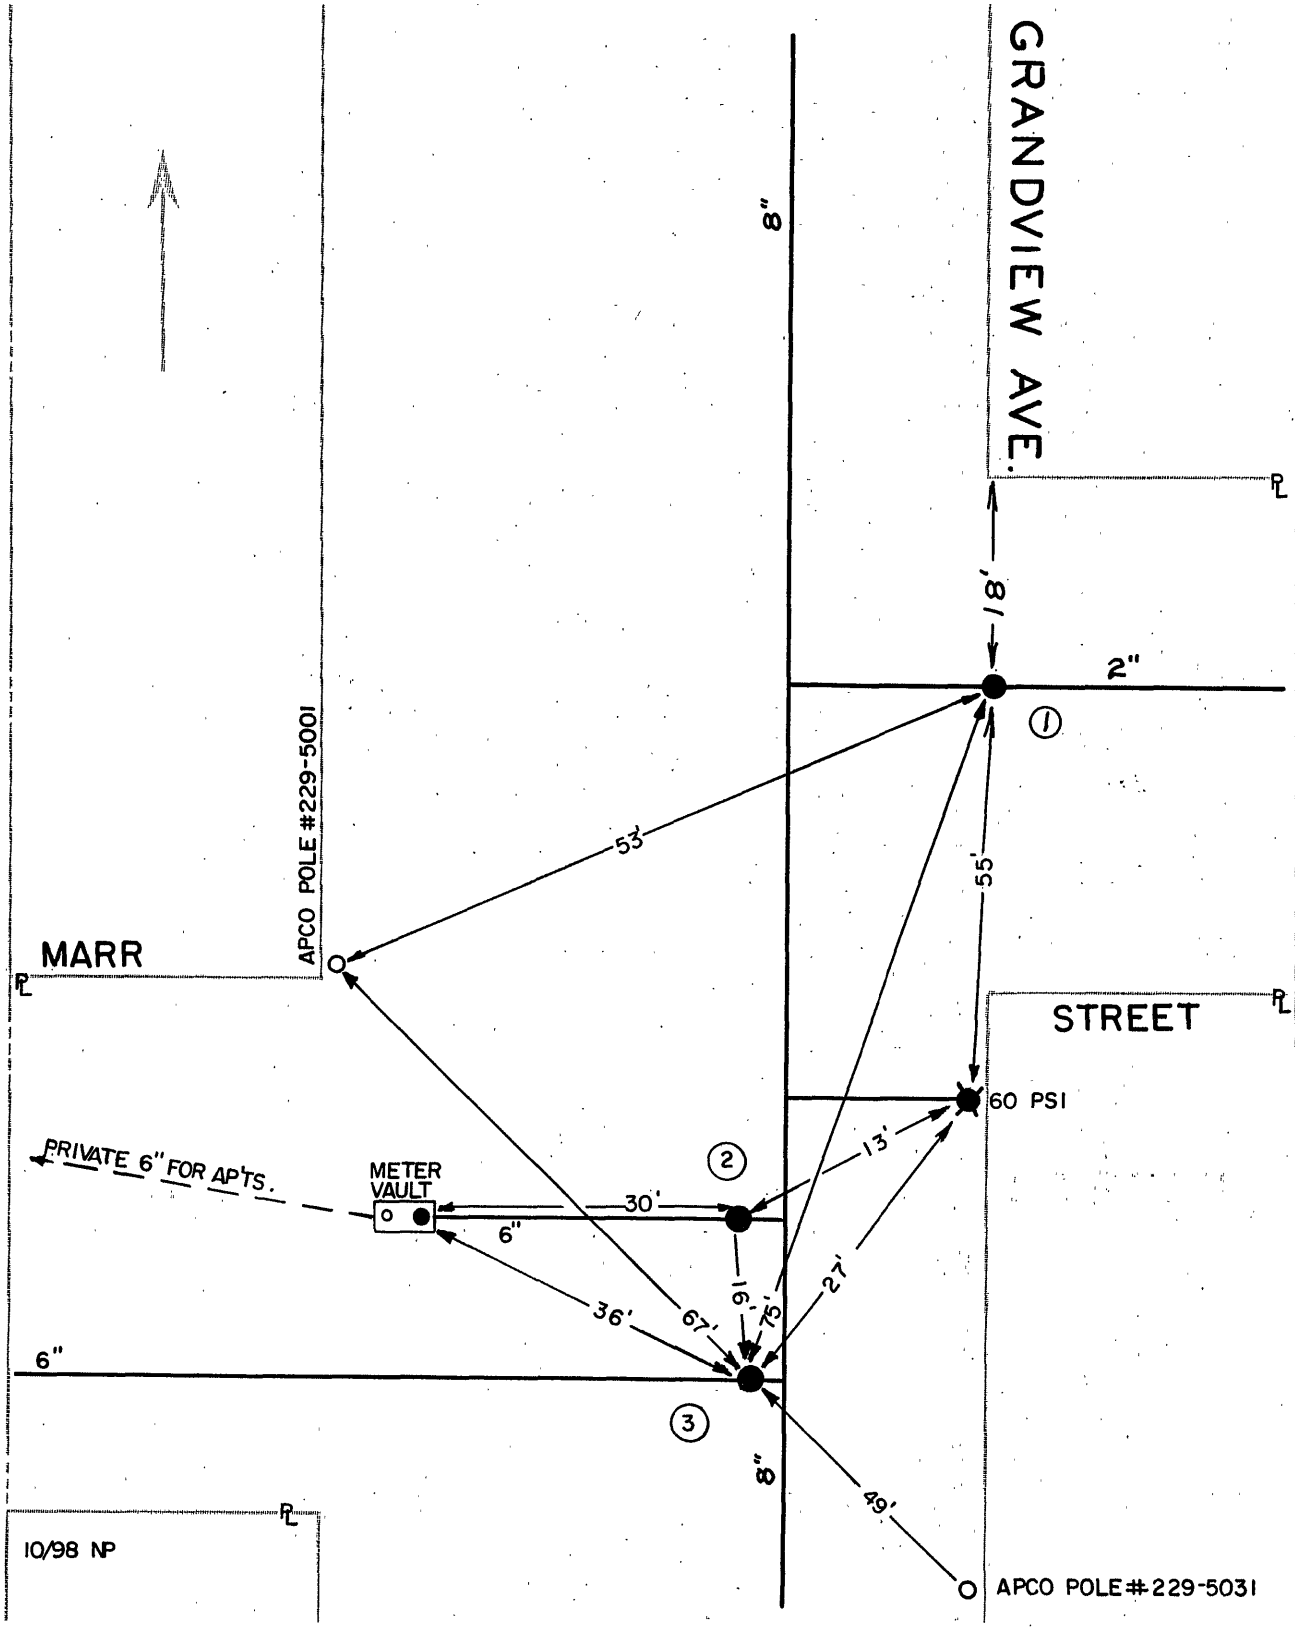

DATE	NO.	SIZE	MAKE	OPEN	TURNS
1955	1	2"	DARLING	R	7
	2	6"		R	21
4/1998	3	6"	MUELLER	R	21
	1	0	EPL		

CITY OF ROANOKE—WATER DEP'T

VALVE DIAGRAM

GRANDVIEW AVE. &

MARR STREET N.W.

SEC. MAP 227

DATE PAGE NO.