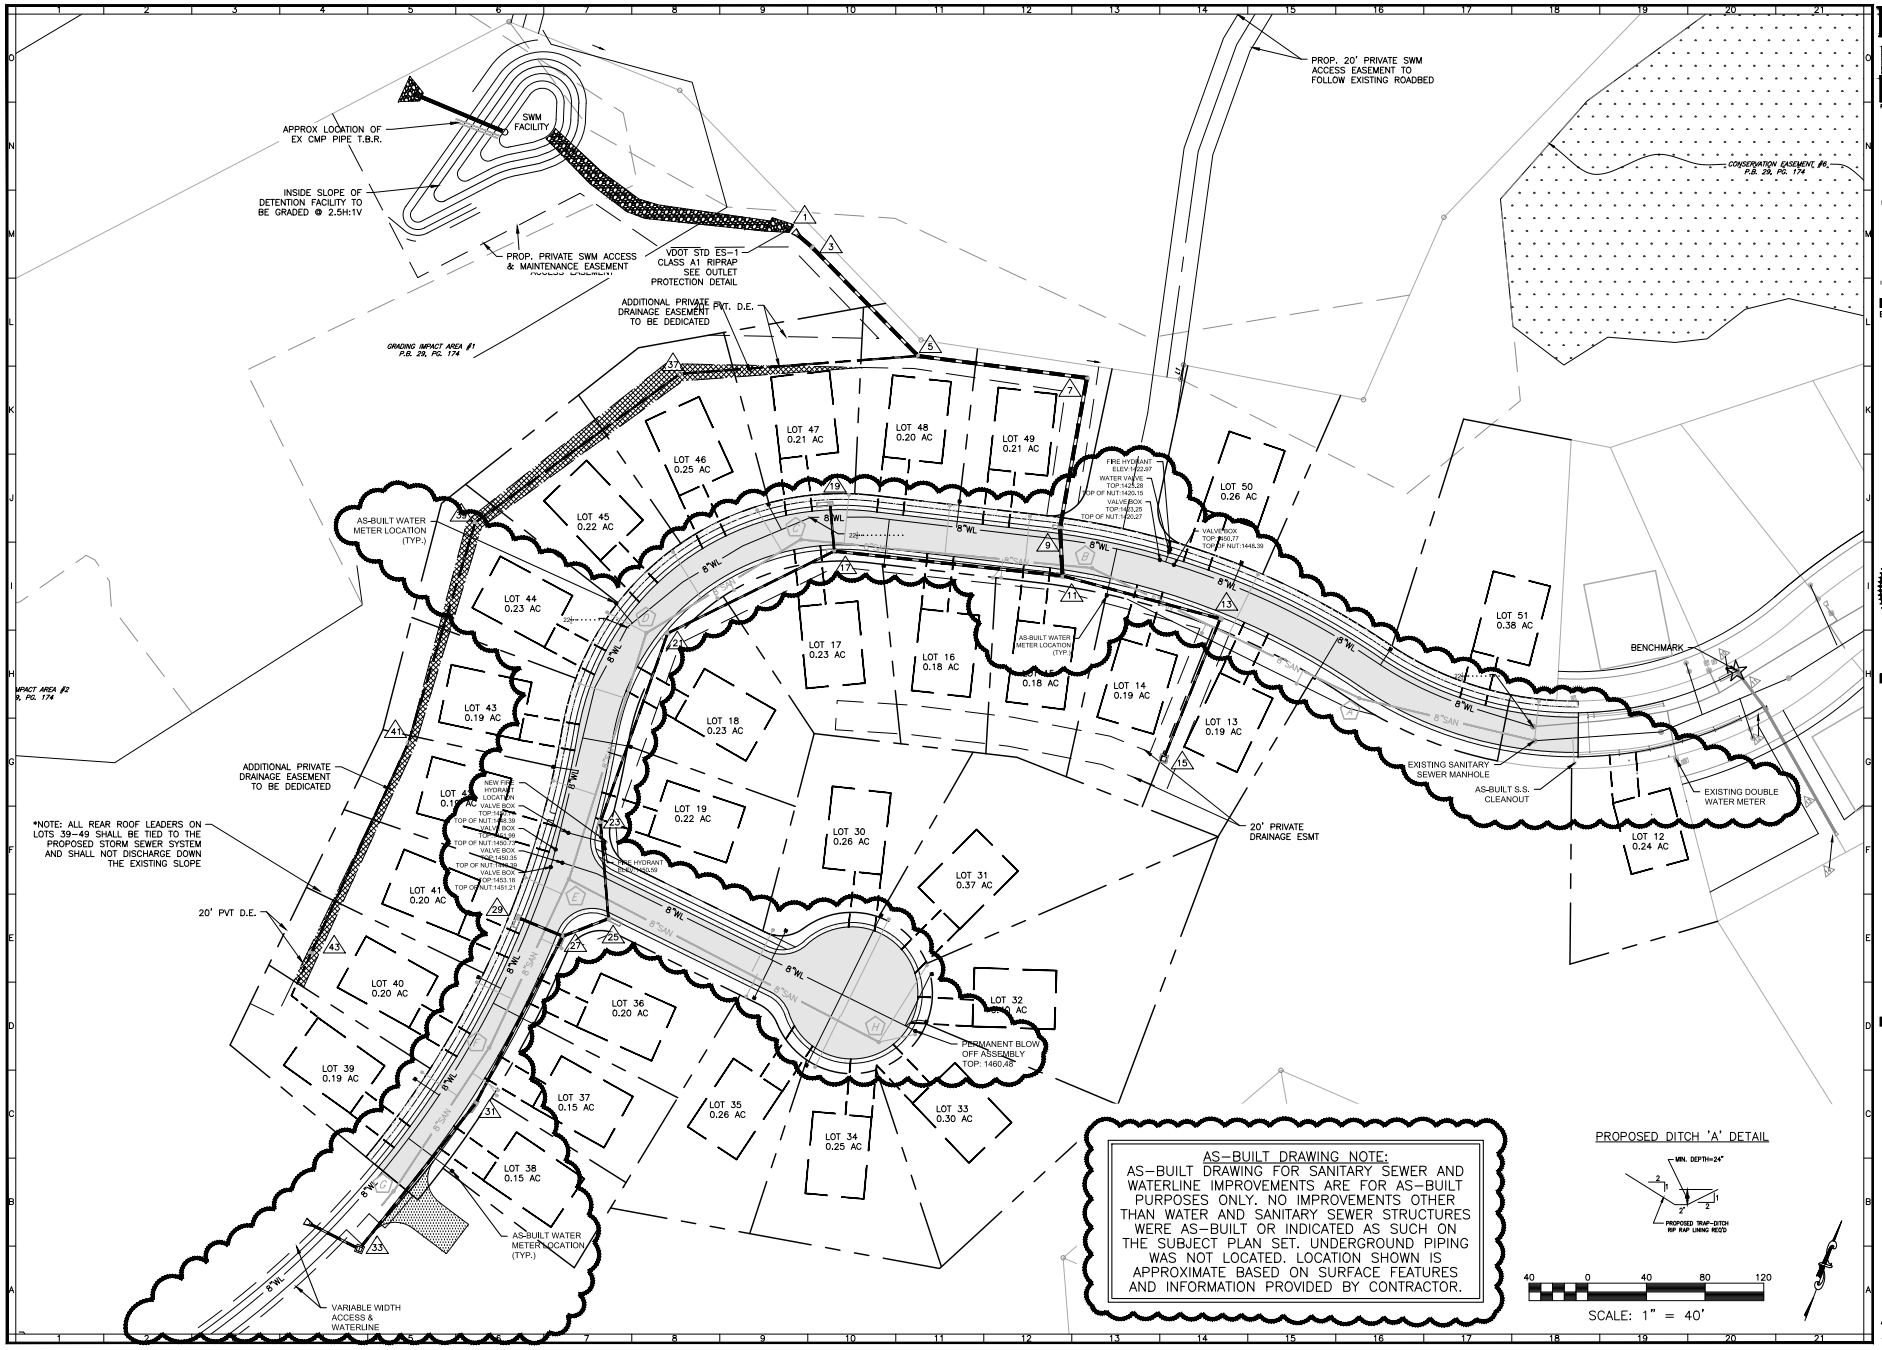

AS-BUILT DRAWING NOTE:
AS-BUILT DRAWING FOR SANITARY SEWER AND WATERLINE IMPROVEMENTS ARE FOR AS-BUILT PURPOSES ONLY. NO IMPROVEMENTS OTHER THAN WATER AND SANITARY SEWER STRUCTURES WERE AS-BUILT OR INDICATED AS SUCH ON THE SUBJECT PLAN SET. UNDERGROUND PIPING WAS NOT LOCATED. LOCATION SHOWN IS APPROXIMATE BASED ON SURFACE FEATURES AND INFORMATION PROVIDED BY CONTRACTOR.

PROPOSED DITCH 'A' DETAIL

SCALE: 1" = 40'

BALZER AND ASSOCIATES, INC.
REFLECTING TOMORROW
www.balzer.cc
Roanoke
New River Valley
Richmond
Staunton
Harrisonburg
RESIDENTIAL LAND DEVELOPMENT ENGINEERING
SITE DEVELOPMENT ENGINEERING
LAND USE PLANNING & ZONING
LANDSCAPE ARCHITECTURE
LAND SURVEYING
ARCHITECTURE
STRUCTURAL ENGINEERING
TRANSPORTATION ENGINEERING
ENVIRONMENTAL & SOIL SCIENCE
WETLAND DELINEATIONS & STREAM EVALUATIONS
Balzer and Associates, Inc.
1208 Corporate Circle
Roanoke, VA 24018
540-772-9580
FAX 540-772-8050

CHRISTOPHER P. BURNS
Lic. No.047338
1/18/21
PROFESSIONAL ENGINEER

MASON'S CREST - SECTION 3
LINN COVE COURT

WATER & SEWER AS-BUILT PLAN #1
CAVE SPRING DISTRICT
ROANOKE COUNTY, VIRGINIA

DRAWN BY	KRO
DESIGNED BY	CPB
CHECKED BY	BTC
DATE	1/18/2021
SCALE	1" = 40'
REVISIONS:	

SHEET NO.
AB1
JOB NO. 04160002.00