LEGEND

- PROPOSED PAVEMENT
- PROPOSED 4' SIDEWALK
- PROPOSED GRAVEL ACCESS ROAD

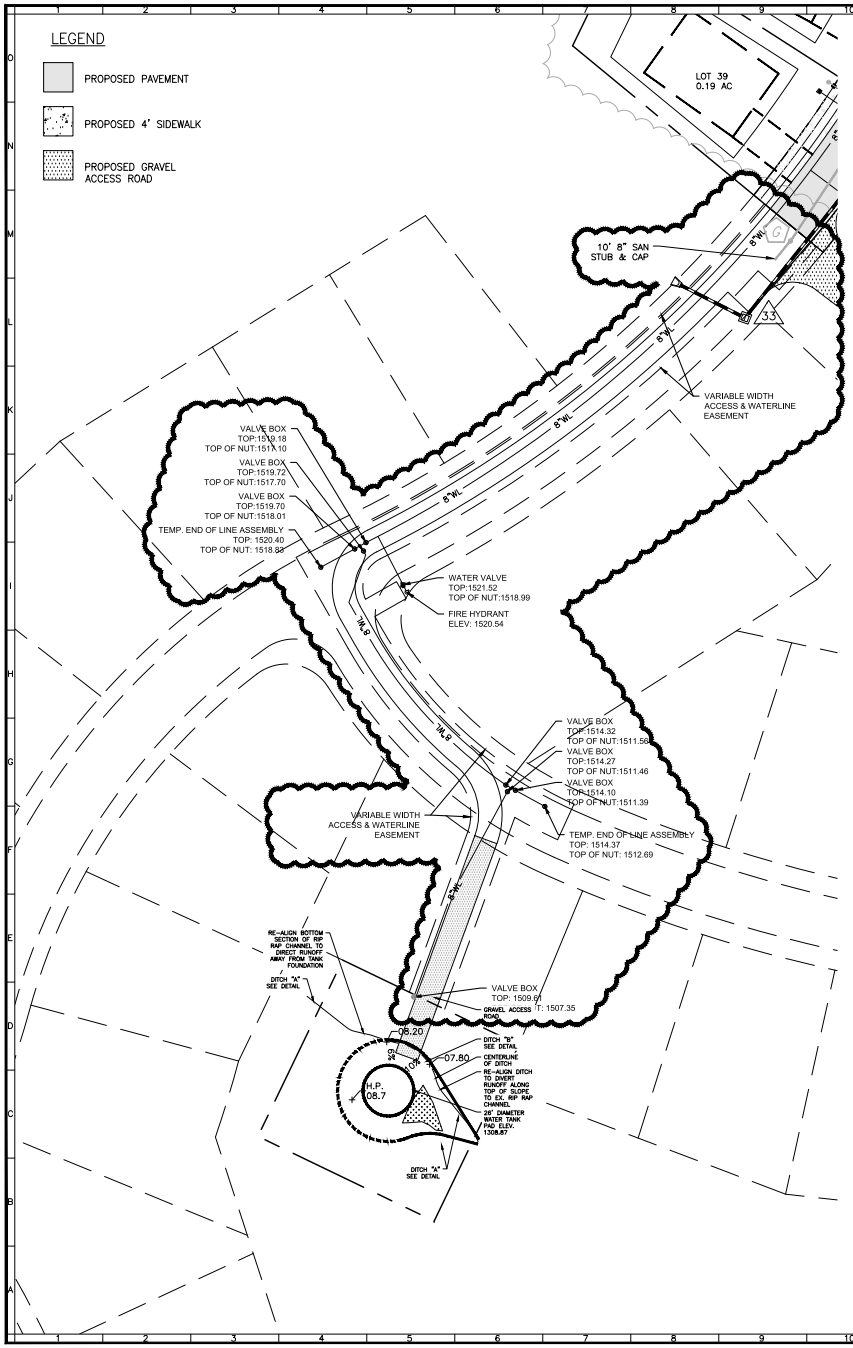

WATERLINE TO TANK PROFILE

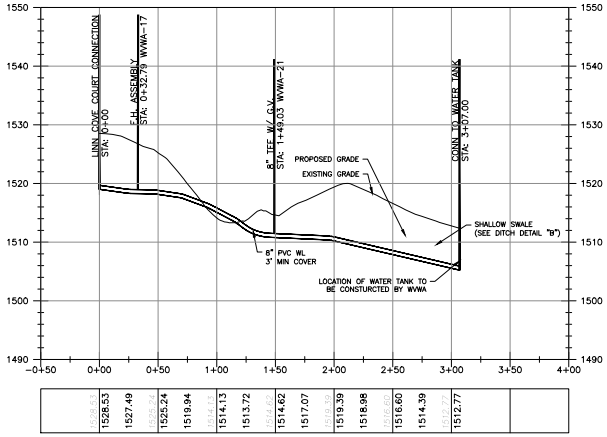

AS-BUILT DRAWING NOTE:
AS-BUILT DRAWING FOR SANITARY SEWER AND WATERLINE IMPROVEMENTS ARE FOR AS-BUILT PURPOSES ONLY. NO IMPROVEMENTS OTHER THAN WATER AND SANITARY SEWER STRUCTURES WERE AS-BUILT OR INDICATED AS SUCH ON THE SUBJECT PLAN SET. UNDERGROUND PIPING WAS NOT LOCATED. LOCATION SHOWN IS APPROXIMATE BASED ON SURFACE FEATURES AND INFORMATION PROVIDED BY CONTRACTOR.

VERTICAL
10 0 10 20 30
SCALE: 1" = 10'

HORIZONTAL
50 0 50 100 150
SCALE: 1" = 50'

30 0 30 60 90
SCALE: 1" = 30'

BALZER AND ASSOCIATES, INC.
REFLECTING TOMORROW
www.balzer.cc
Roanoke
New River Valley
Richmond
Staunton
Harrisonburg
RESIDENTIAL LAND DEVELOPMENT ENGINEERING
SITE DEVELOPMENT ENGINEERING
LAND USE PLANNING & ZONING
LANDSCAPE ARCHITECTURE
LAND SURVEYING
ARCHITECTURE
STRUCTURAL ENGINEERING
TRANSPORTATION ENGINEERING
ENVIRONMENTAL & SOIL SCIENCE
WETLAND DELINEATIONS & STREAM EVALUATIONS
Balzer and Associates, Inc.
1208 Corporate Circle
Roanoke, VA 24018
540-772-9580
FAX 540-772-8050

COMMONWEALTH OF VIRGINIA
CHRISTOPHER P. BURNS
Lic. No.047338
1/18/21
PROFESSIONAL ENGINEER

MASON'S CREST - SECTION 3
LINN COVE COURT

WATER & SEWER AS-BUILT PLAN #2

CAVE SPRING DISTRICT
ROANOKE COUNTY, VIRGINIA

DRAWN BY	KRO
DESIGNED BY	CPB
CHECKED BY	BTC
DATE	1/18/2021
SCALE	AS NOTED

REVISIONS:

SHEET NO.
AB2

JOB NO. 04160002.00