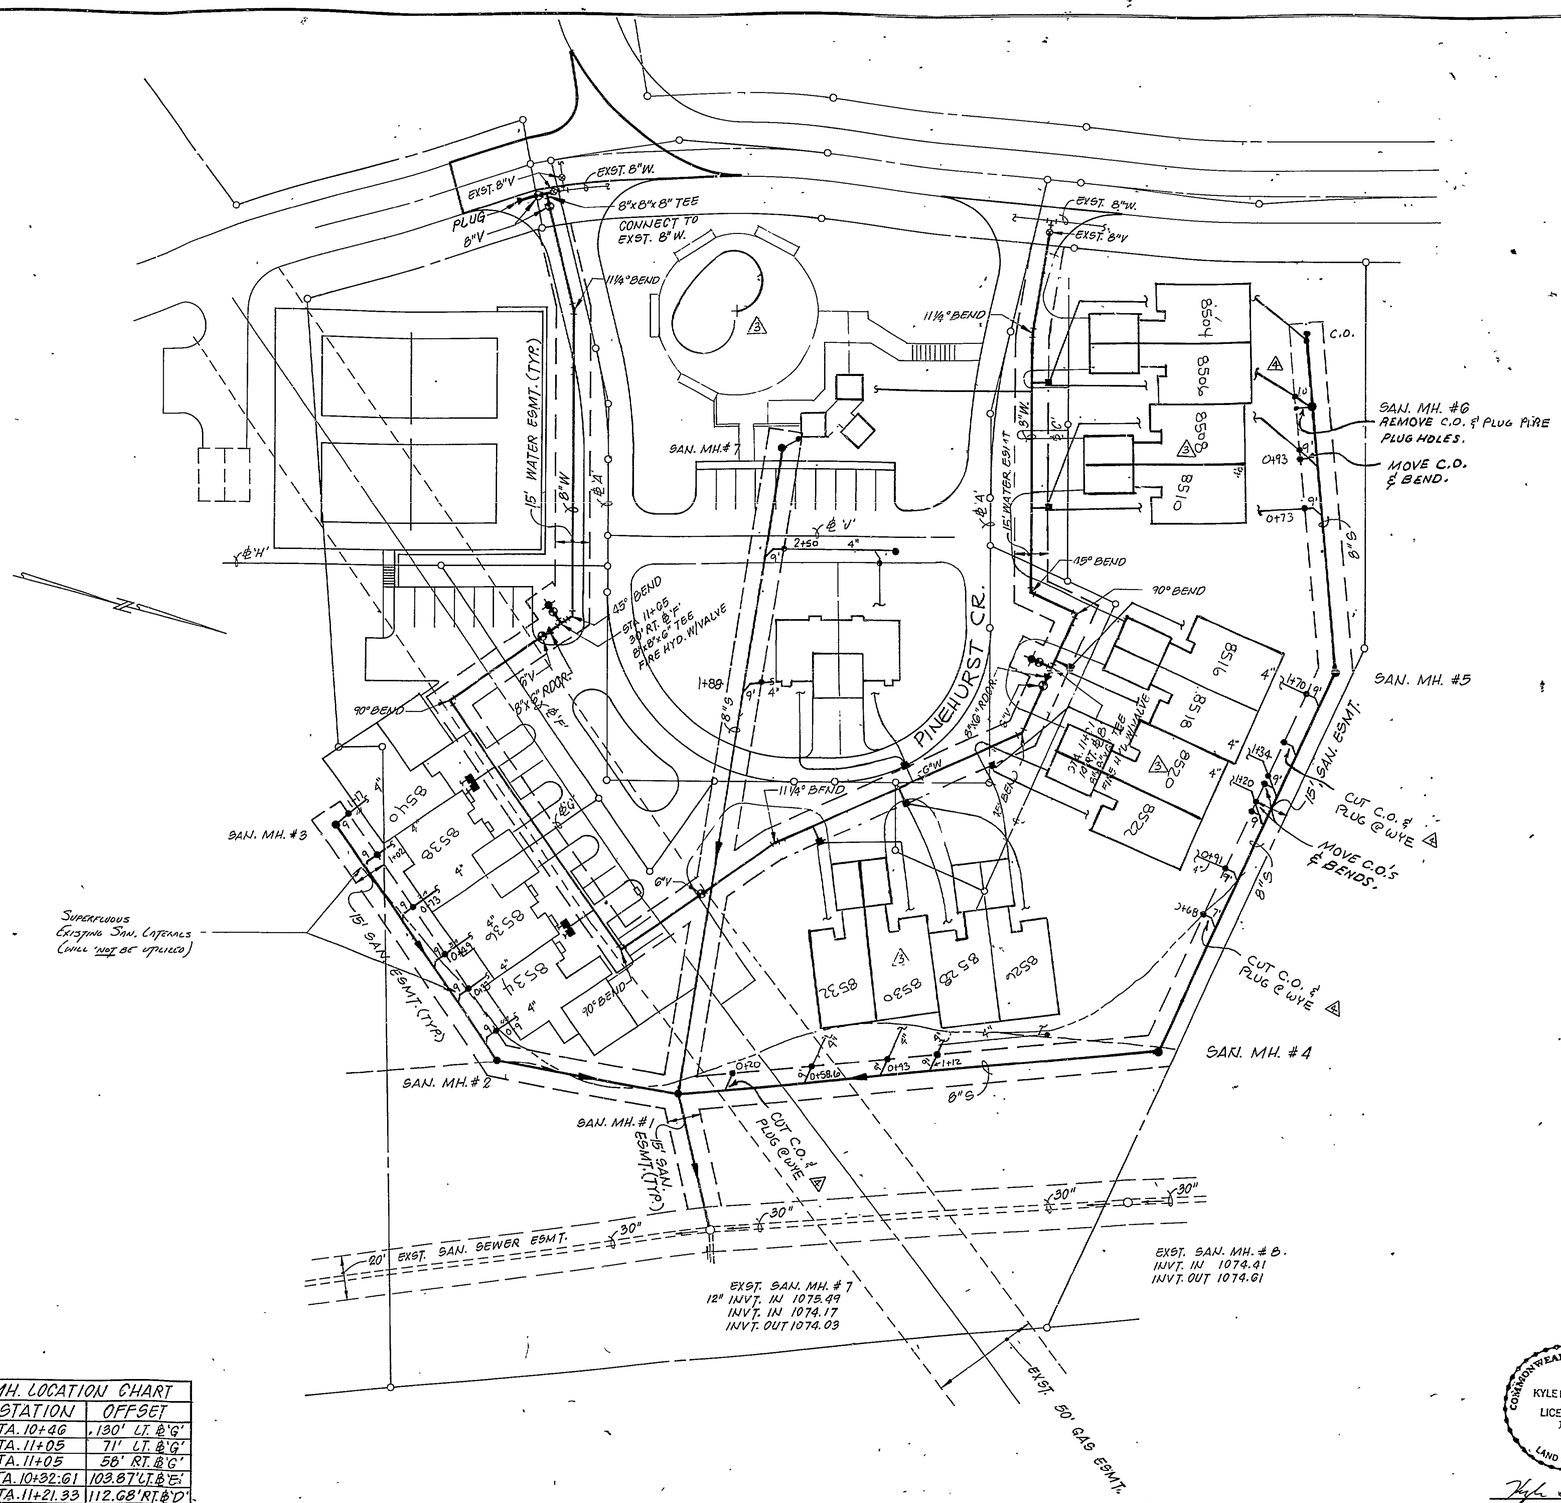

NOTES:

1. FOR BASELINE (℄) LAYOUT AND DIMENSIONS, SEE DIMENSIONAL LAYOUT SHEET 2.
2. FOR LOCATION OF FIRE HYDRANTS FROM EDGE OF PAVEMENT, SEE FIRE HYDRANT SETTING DETAIL SHEET 6.
3. THRUST BLOCKS SHALL BE PLACED AT ALL WATER LINE FITTINGS. FOR SIZE SEE THRUST BLOCK DETAIL SH. 6. FIRE HYDRANTS, VALVES, BLOWOFFS AND WATER METER SETTINGS SHALL BE SET IN ACCORDANCE WITH THE DETAILS ON SH. 6 AND ROANOKE COUNTY STANDARDS.
4. WATER METERS AND CLEANOUTS SHALL NOT BE LOCATED IN PAVED AREAS OR WALKS.
5. WATER SERVICE LATERAL W/WATER METER.
6. SAN. SEWER LATERAL W/CLEANOUT. SANITARY SEWERS SHALL BE INSTALLED IN ACCORDANCE W/THE DETAILS ON SH. 7 AND ROANOKE COUNTY STANDARDS.
7. SEE SH. 5 FOR SANITARY PROFILES.
8. THERE SHALL BE NO FILL PLACED IN TINKER CREEK FLOODWAY.
9. WATER LINE DISINFECTION AND TESTING SHALL CONFORM TO AWWA C600-82.
10. SAN. MH. #1, #2 & #4 SHALL HAVE WATERTIGHT FRAME & COVER.
11. REFER TO REVISED SUBDIVISION PLAT (NOV. 3, 1990), OR REVISED DIMENSIONAL LAYOUT (NOV. 3, 1990), FOR ACCURATE BLDG. AND BOUNDARY SITUATIONS.

SANITARY MH. LOCATION CHART

MH. NO.	STATION	OFFSET
SAN. MH #1	STA. 10+46	130' LT. ℄ 'G'
SAN. MH. #2	STA. 11+05	71' LT. ℄ 'G'
SAN. MH. #3	STA. 11+05	58' RT. ℄ 'G'
SAN. MH. #4	STA. 10+32.61	103.87' LT. ℄ 'E'
SAN. MH. #5	STA. 11+21.33	112.68' RT. ℄ 'D'
SAN. MH. #6	STA. 11+10.5	7' LT. ℄ 'D'
SAN. MH. #7	STA. 10+79	40' LT. ℄ 'J'

REVISION	DATE	DESCRIPTION	BY	APP.
7	11/14/90	PER RKE. CO. COMMENTS	RCH	
6	6/22/87	AS BUILT SEWER LATERALS ADDED	SWH	
5	5/8/87	REV. TO TOWNHOUSES	RSM	
4	3/10/87	PER RKE. CO. COMMENTS	SWH	
3	2/12/87	PER OWNERS COMMENTS	JCD	
2	7/11/86	PER RKE CO. COMMENTS	ARB	
1	6/12/86	PER RKE. CO. COMMENTS	ARB	

COMMONWEALTH OF VIRGINIA
KYLE D. AUSTIN
LICENSE No. 2483
LAND SURVEYOR

Kyle D. Austin

DESIGNED RCB
DRAWN ARB
CHECKED KDA
APPROVED
SUBMITTED

MEADOWBROOK VILLAGE

UTILITY PLAN

Mattern & Craig
CONSULTING ENGINEERS

SCALE: 1" = 30'
COMM NO. 592
DATE: MAY 1986
SHEET 4

RC-3937