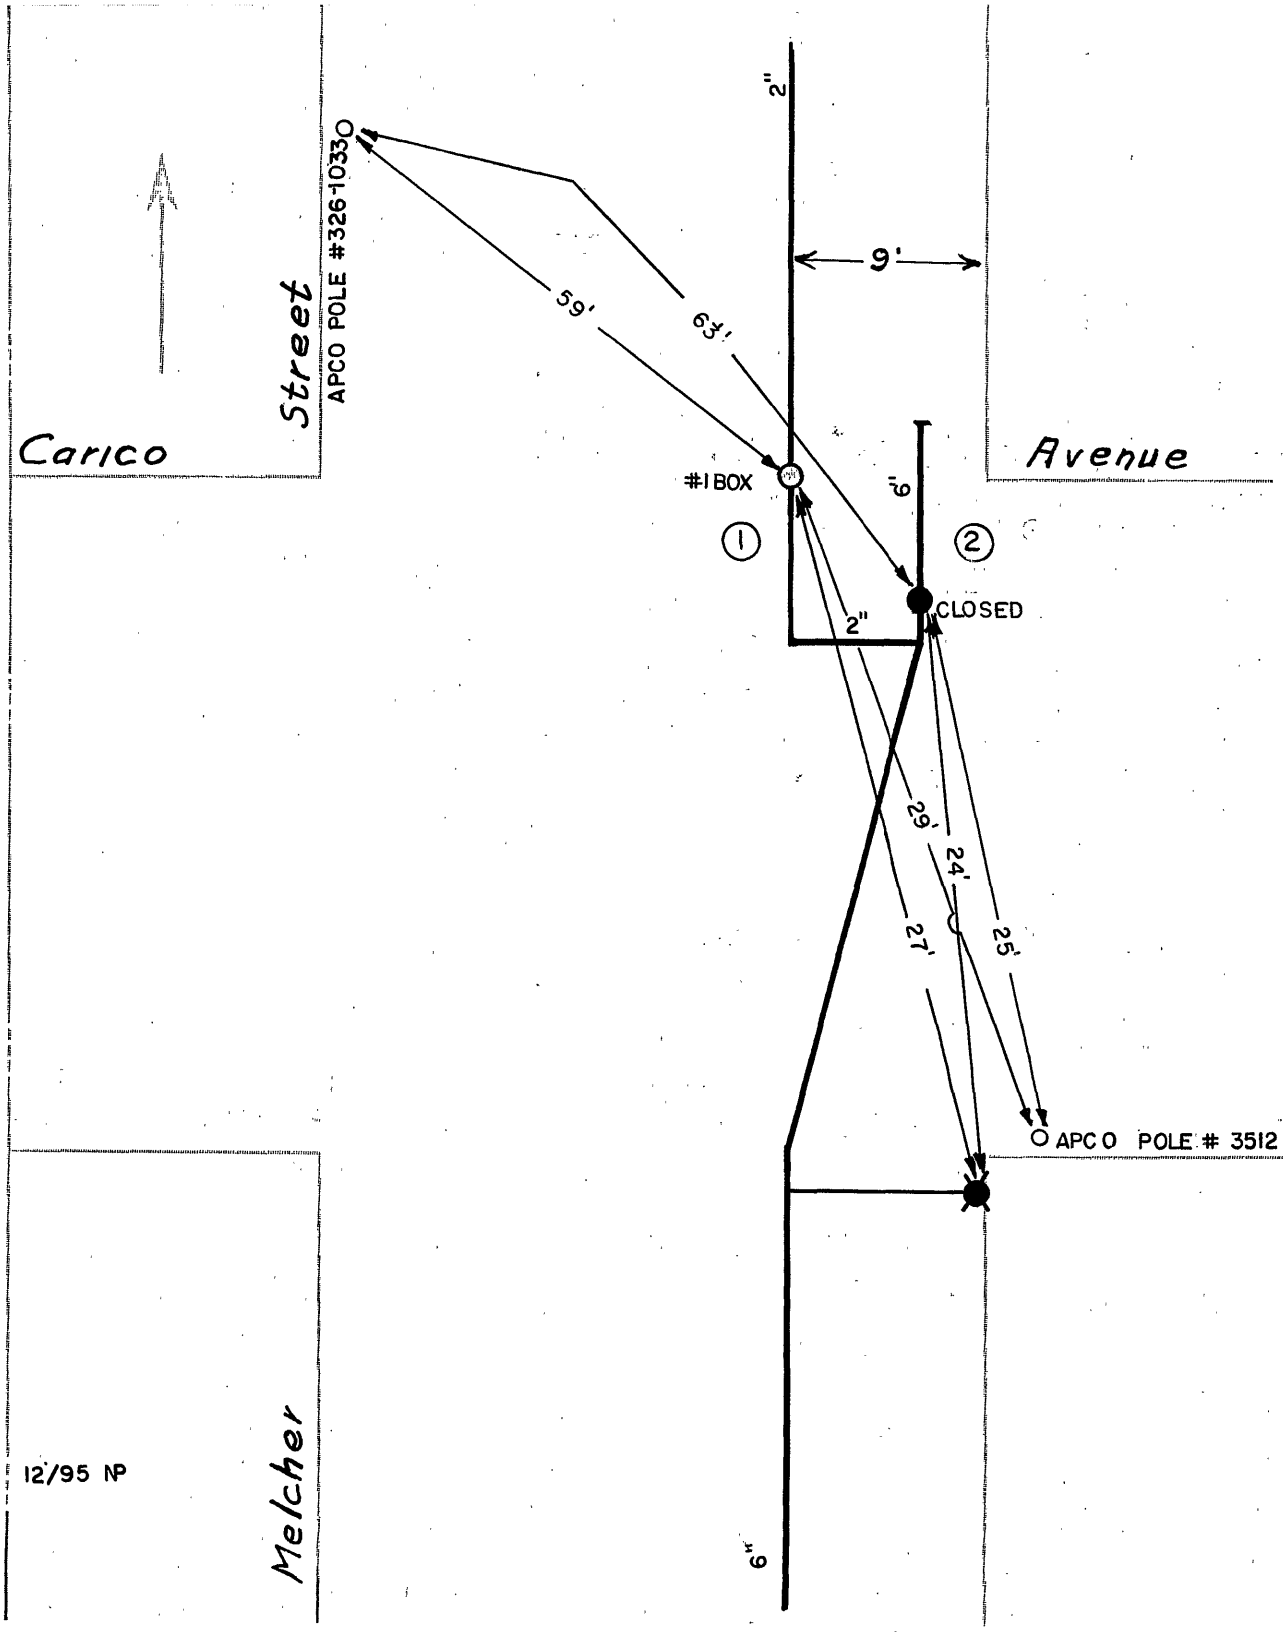

DATE	NO.	SIZE	MAKE	OPEN	TURNS
1954	1	2"	Darling	R	7
1994	2	6"	DARLING	R	20
	1	0'	N.P.L.		

12/95 NP

CITY OF ROANOKE – WATER DEP'T

VALVE DIAGRAM

Carico Avenue &

Melcher Street

SEC. MAP 430, 439 S.E.

DATE PAGE NO.