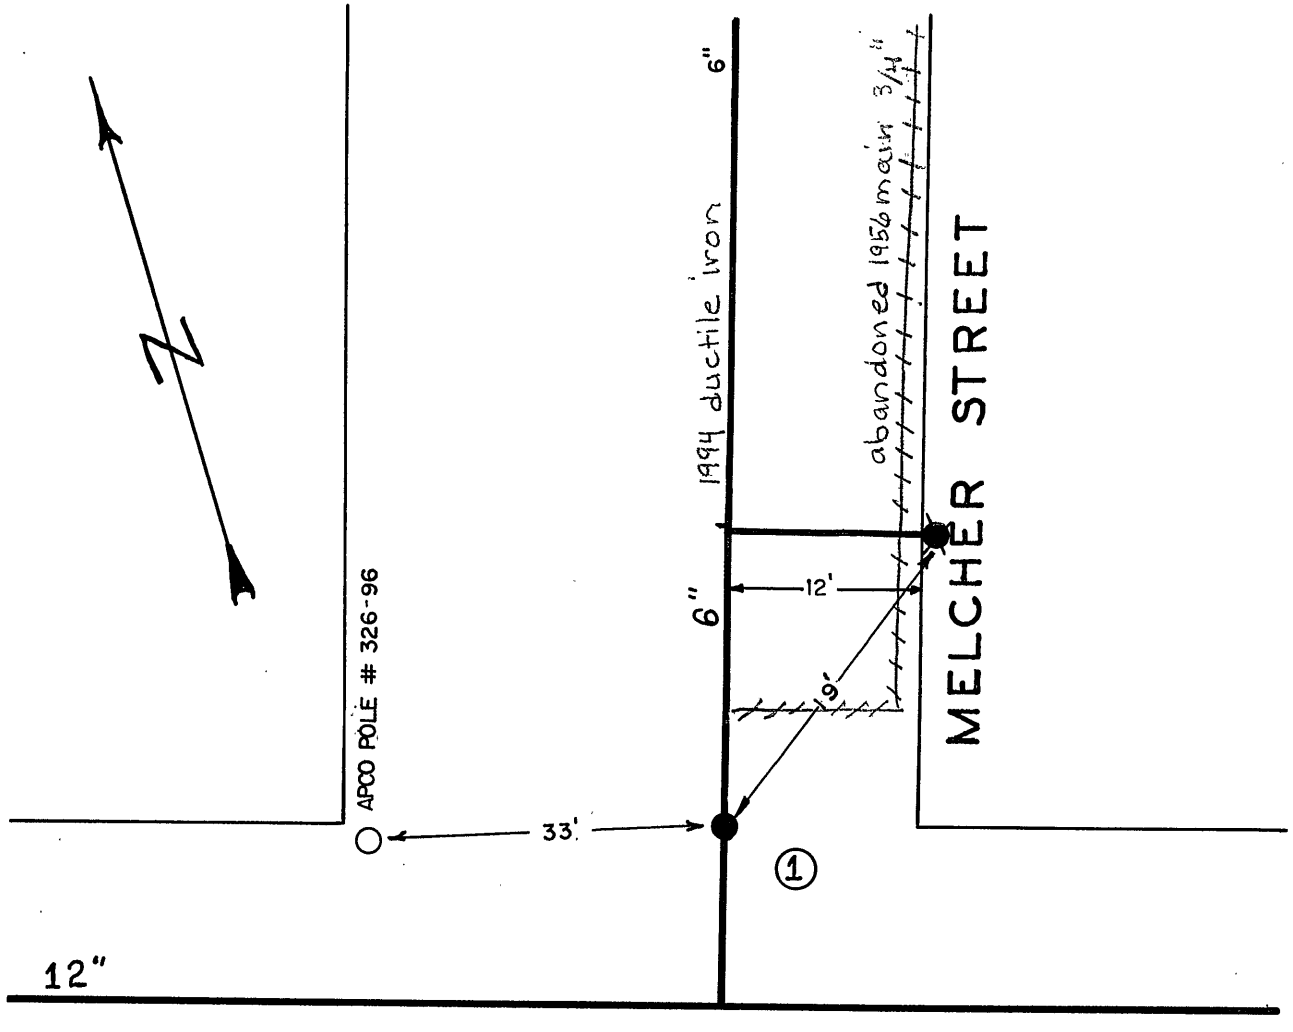

DATE	NO.	SIZE	MAKE	OPEN	TURNS
1953	1	6"	MUELLER	R	20
	1	0	NPL		

CITY OF ROANOKE—WATER DEPT.

VALVE DIAGRAM

MELCHER STREET &

YELLOW MT. ROAD

SEC. MAP 430 S.E.

DATE PAGE NO.

12/95 NP

"IMPERIAL" TRACING CLOTH K & E CO., N. Y.