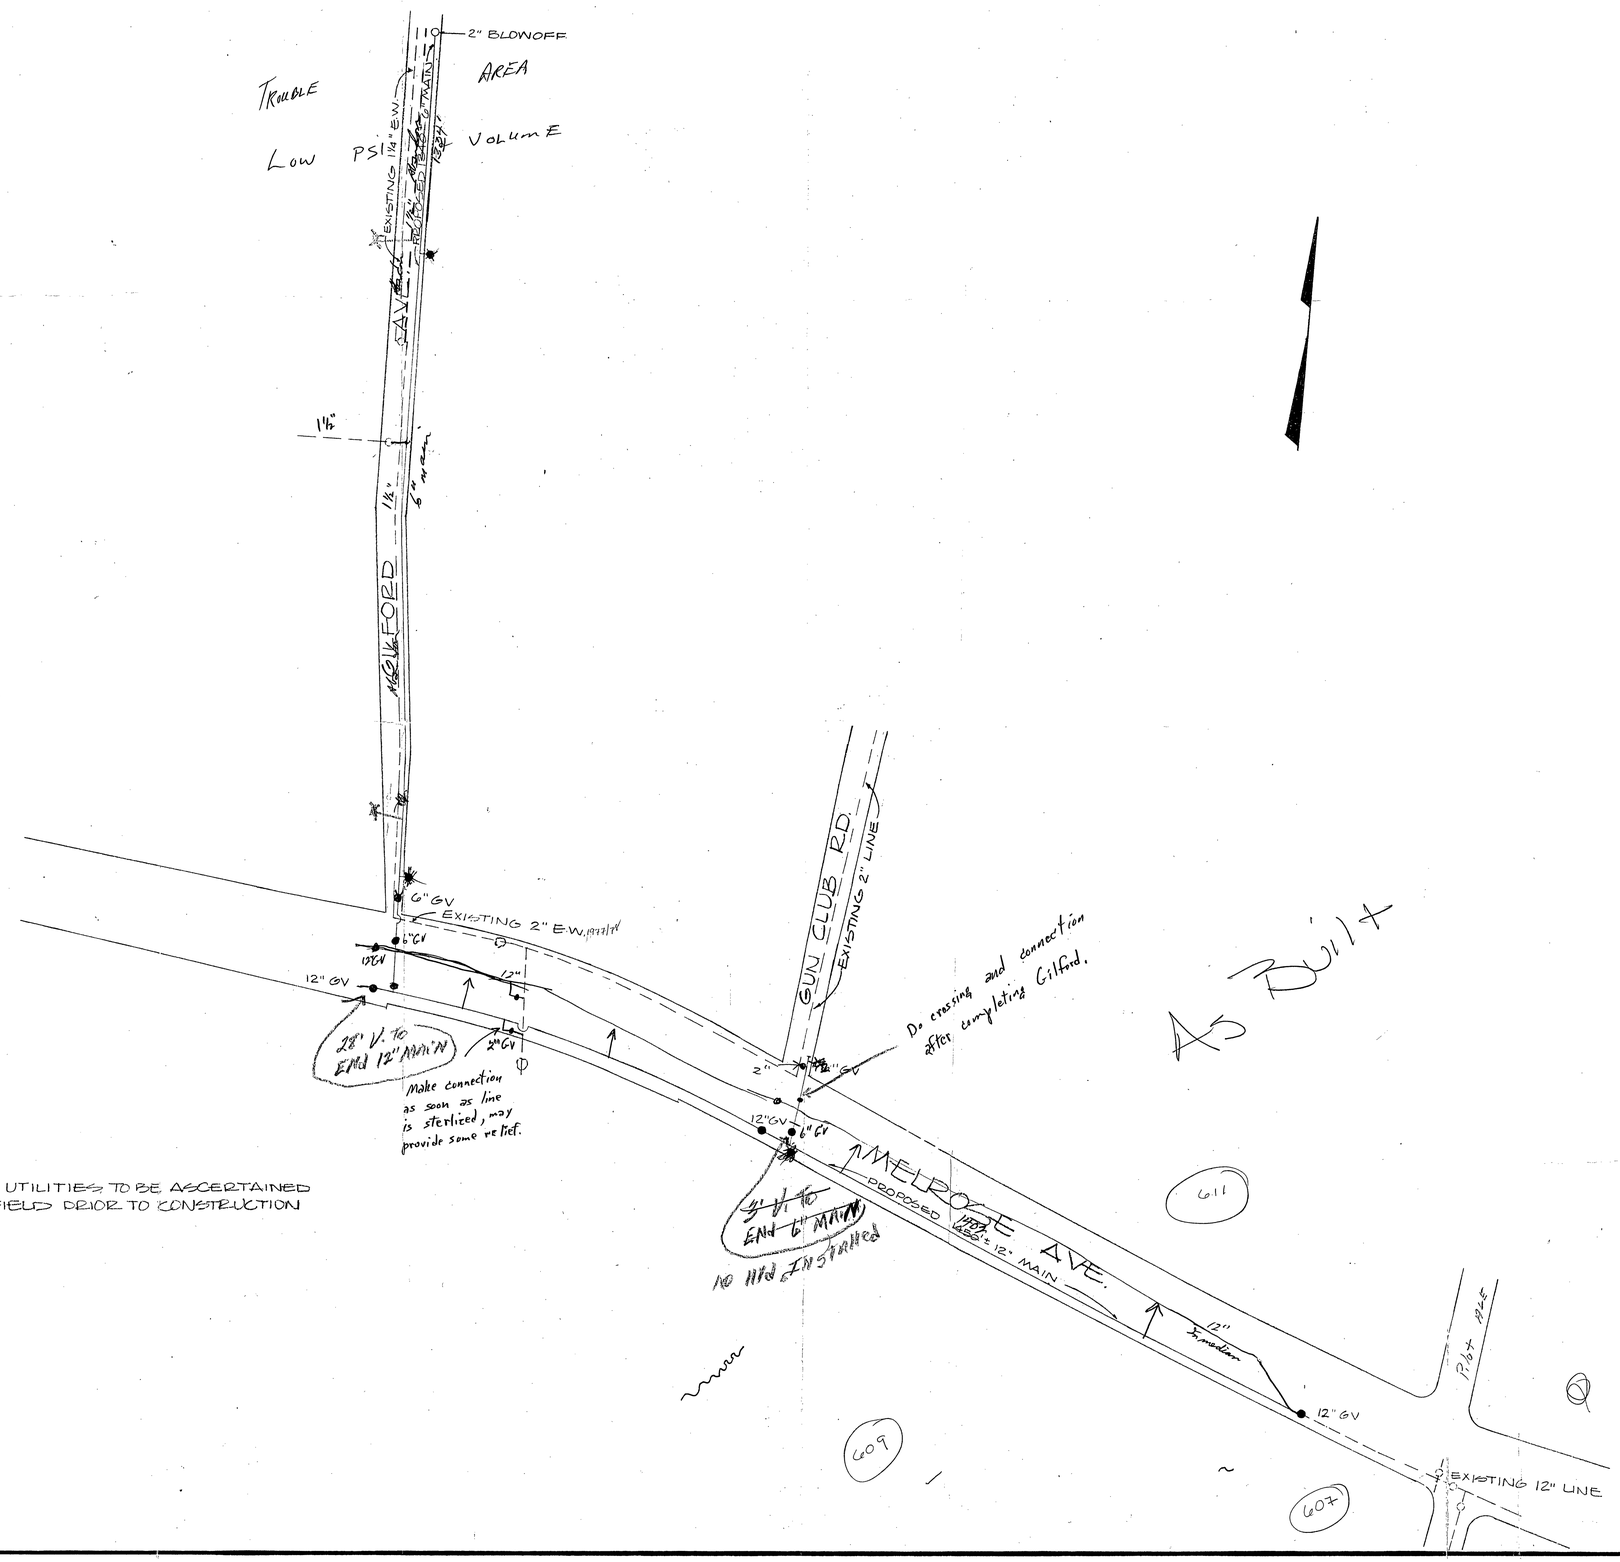

NOTE:
EXISTING UTILITIES TO BE ASCERTAINED IN THE FIELD PRIOR TO CONSTRUCTION

SURVEYED 1-1-80
DRAWN 5-28-80
1402' 12" 3 V #2
1345' 6" 3 V #2
2 6" 6" V #2
4 2 F
J W MAXEY

DIRECTOR OF PUBLIC WORKS — DATE 31 Dec. 79
CITY ENGINEER — DATE 31 Dec. 79
DIRECTOR OF PUBLIC HEALTH — DATE 12-21-79
AGENT FOR ROANOKE GAS CO. — DATE 12-31-79

map 611

~~600~~ 607, 609, 611
600'
Original Valve Chart

WATER MAIN EXTENSION
MELROSE AVE.
ROANOKE, VIRGINIA

CEV
9-25-79
7914
1