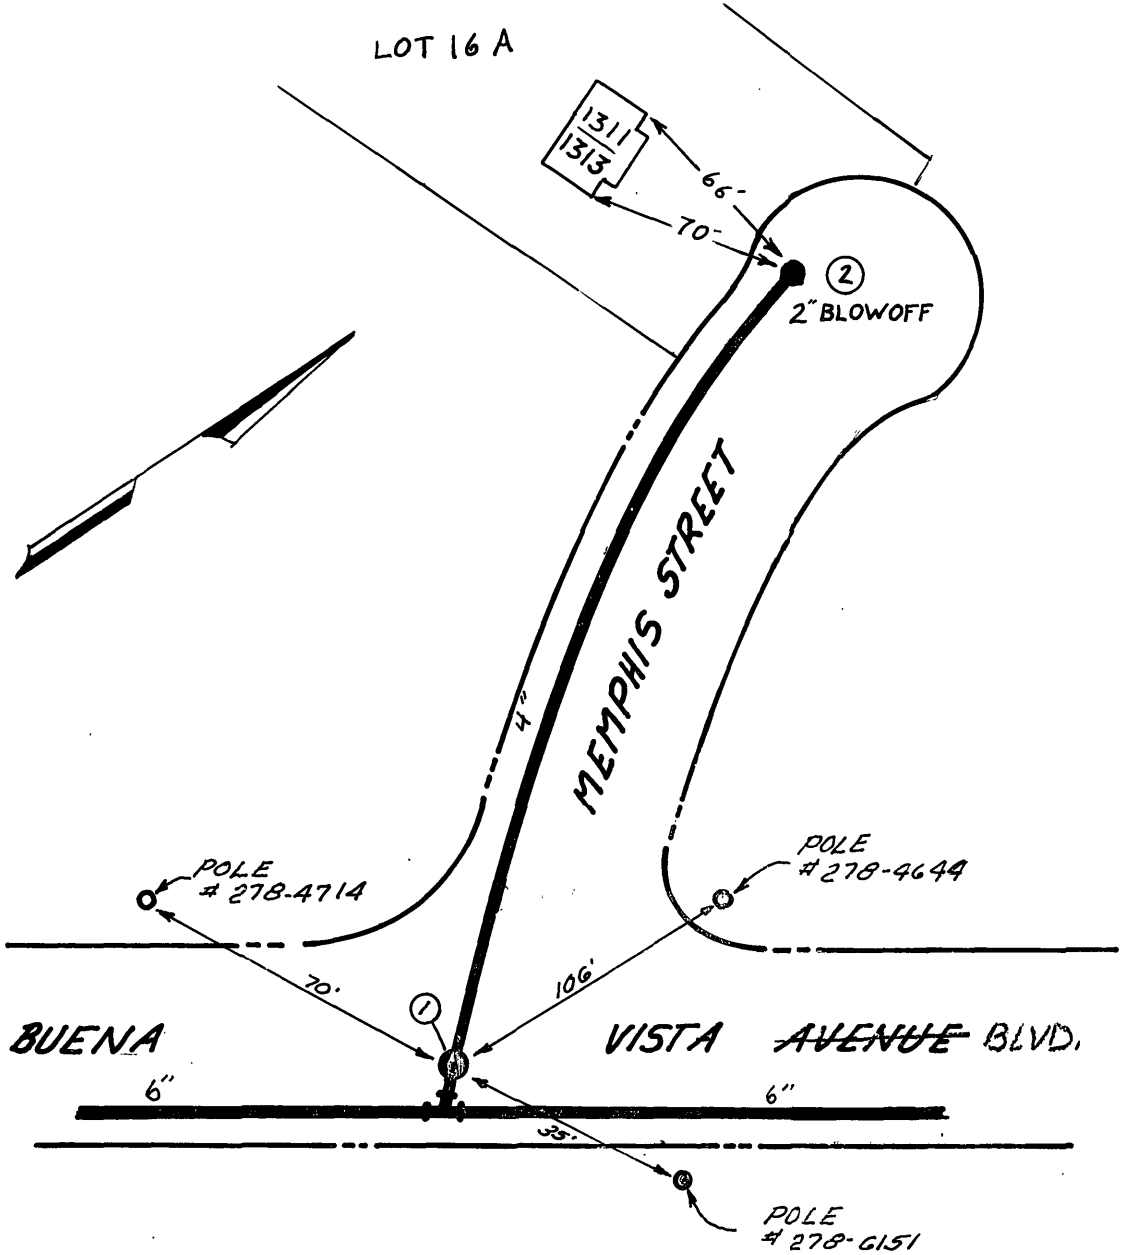

DATE	NO.	SIZE	MAKE	OPEN	TURNS
1/85	1	4"	MULLER	R	15
1/85	2	2"	MISC.	L	

8/2000 JH

CITY OF ROANOKE—WATER DEP'T
VALVE DIAGRAM

BUENA VISTA AV. &
MEMPHIS STREET
S.E.

SEC. MAP 414

DATE 7-1-85 PAGE NO. 1