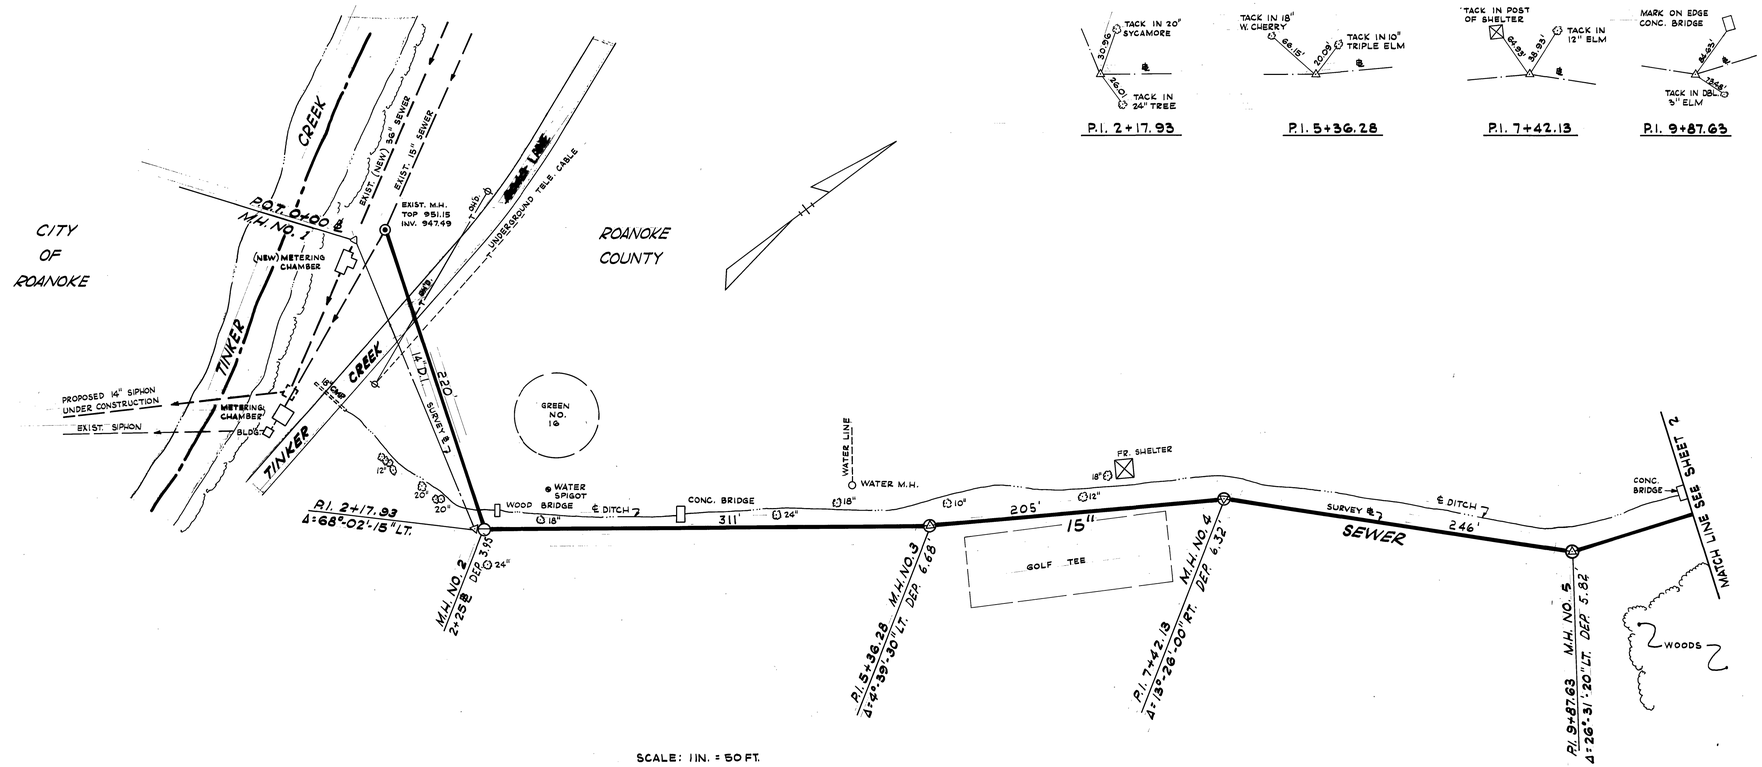

SCALE: 1 IN. = 50 FT.

BENCH MARK: CHISELED "□" ON SOUTH END OF WEST ABUT. OF NEW BRIDGE OVER TINKER CREEK ℄ INT. OF READ ROAD & OLD MOUNTAIN ROAD. EL. 960.86 .

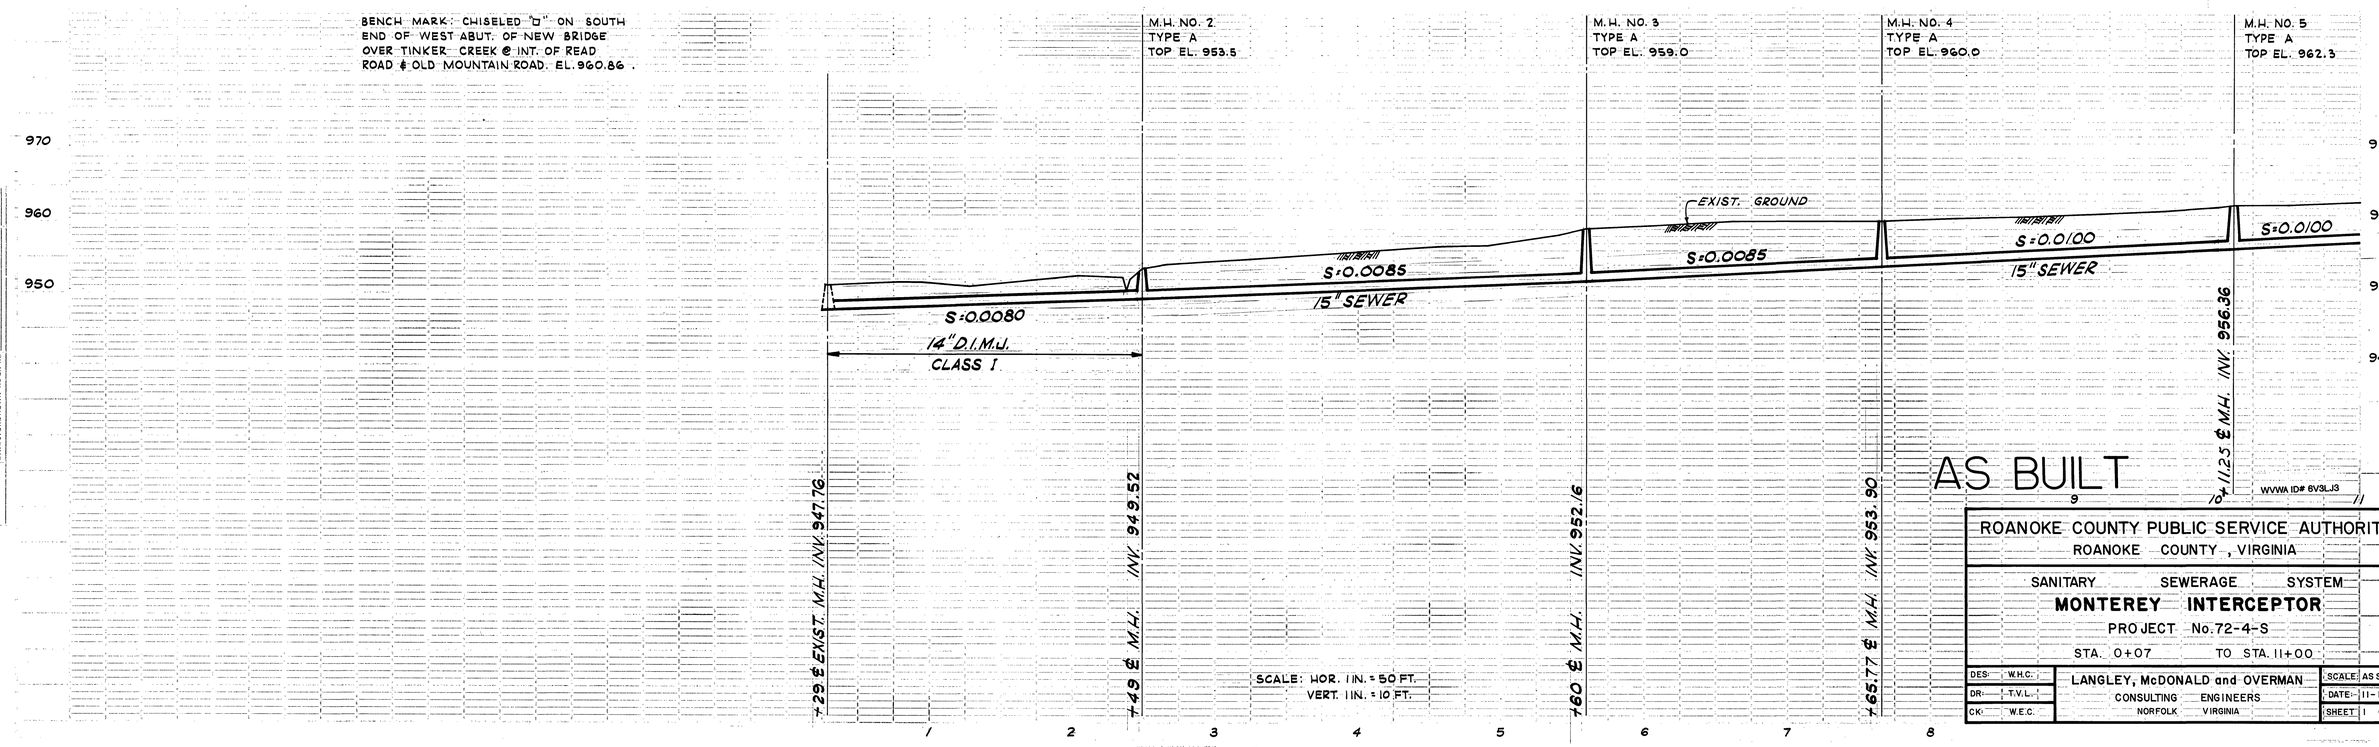

AS BUILT

WVWA ID# 6V3L13

ROANOKE COUNTY PUBLIC SERVICE AUTHORITY ROANOKE COUNTY, VIRGINIA	
SANITARY SEWERAGE SYSTEM **MONTEREY INTERCEPTOR** PROJECT No. 72-4-S STA. 0+07 TO STA. 11+00	
DES: W.H.C. DR: T.V.L. CK: W.E.C.	LANGLEY, McDONALD and OVERMAN CONSULTING ENGINEERS NORFOLK VIRGINIA
SCALE: AS SHOWN DATE: 11-1-72 SHEET 1 OF 4	

3454