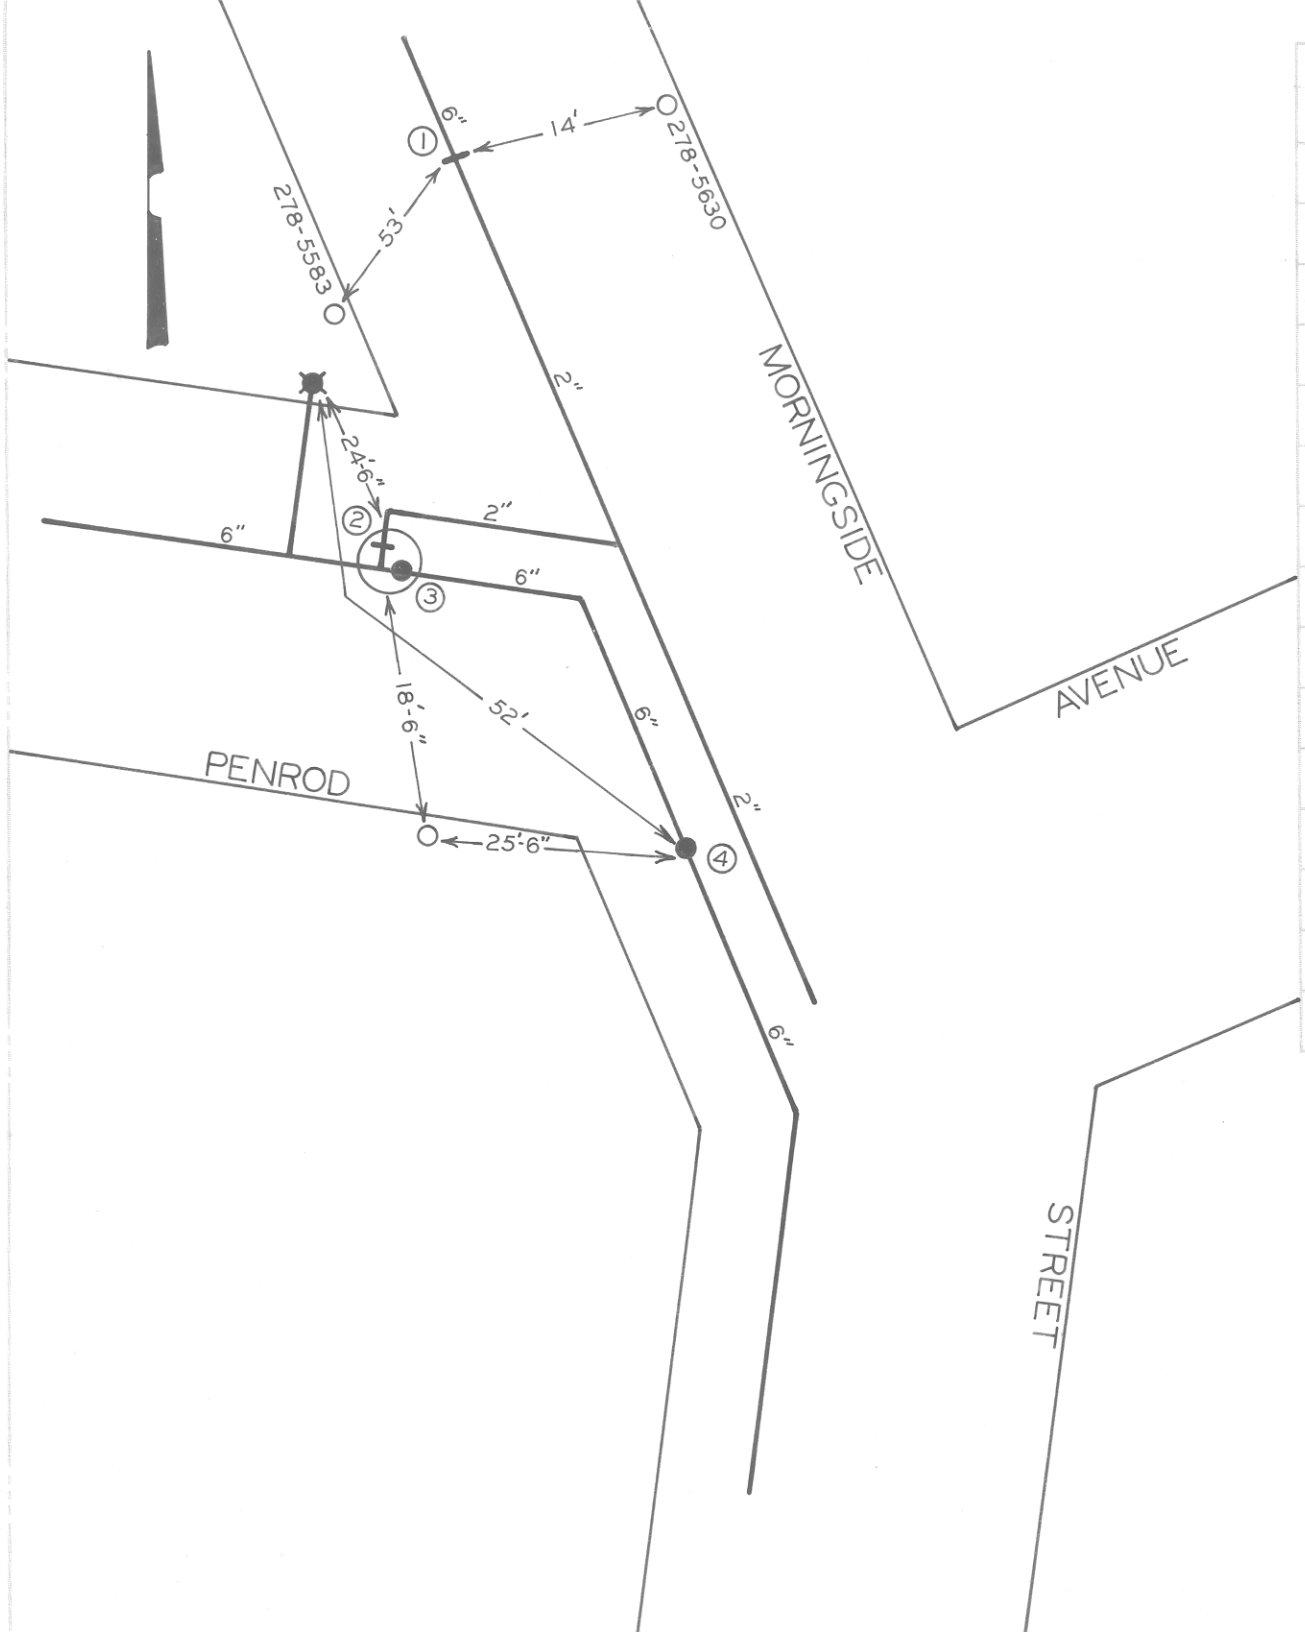

DATE	NO.	SIZE	MAKE	OPEN	TURNS
70	1	2"	DARLING	R	
71	2	2"	DARLING	R	
71	3	6"	MUELLER	R	
71	4	6"	MUELLER	R	
	1	47'N	N.P.L.		

CITY OF ROANOKE—WATER DEP'T

VALVE DIAGRAM

MORNINGSIDE STREET &

PENROD AVENUE S.E.

SEC. MAP 413

DATE PAGE NO.