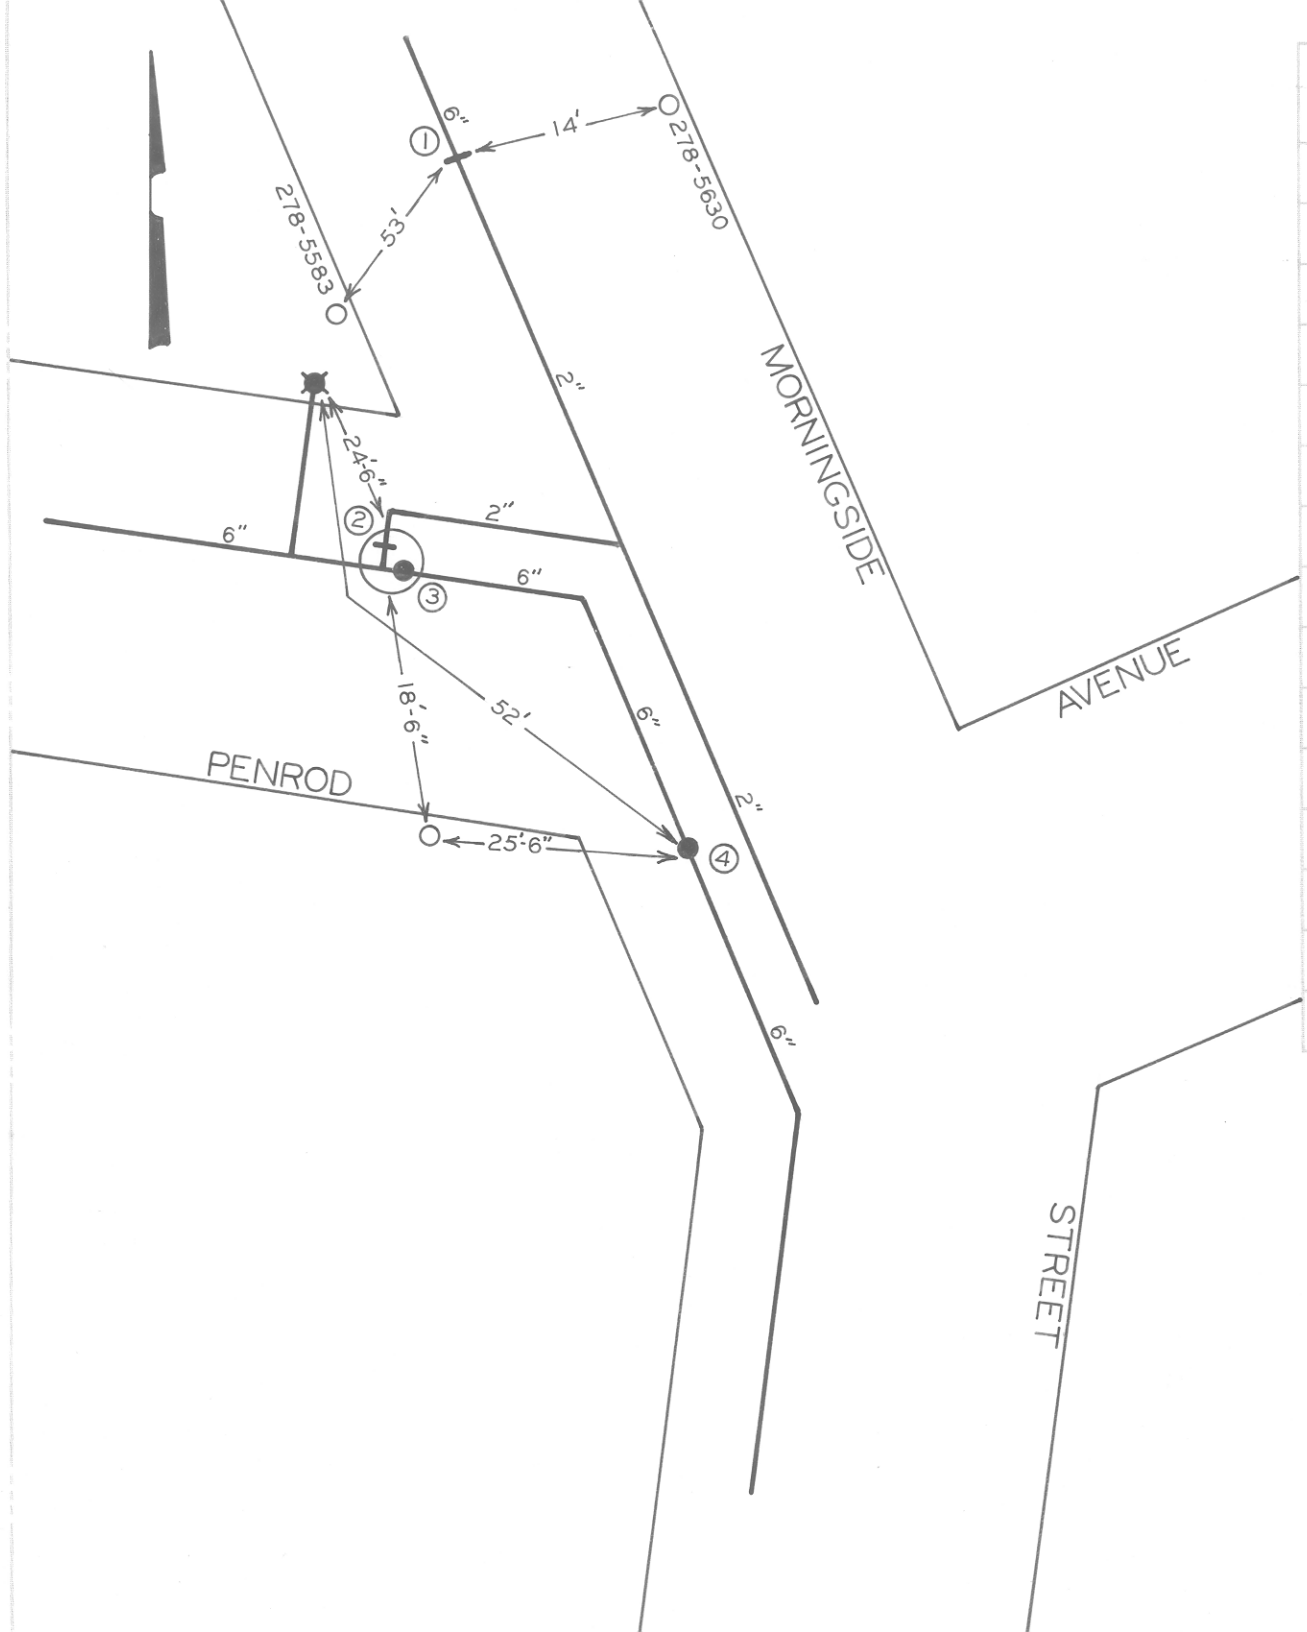


| DATE | NO. | SIZE | MAKE | OPEN | TURNS |
|---|---|---|---|---|---|
| 70 | 1 | 2" | DARLING | R | |
| 71 | 2 | 2" | DARLING | R | |
| 71 | 3 | 6" | MUELLER | R | |
| 71 | 4 | 6" | MUELLER | R | |
| | | | | | |
| | | | | | |
| | | | | | |
| | | | | | |
| | | | | | |
| | | | | | |
| | 1 | 47'N | N.P.L. | | |
| | | | | | |
| | | | | | |
| | | | | | |
| | | | | | |

CITY OF ROANOKE—WATER DEP'T

VALVE DIAGRAM

MORNINGSIDE STREET &
PENROD AVENUE S.E.

SEC. MAP 413

DATE PAGE NO.