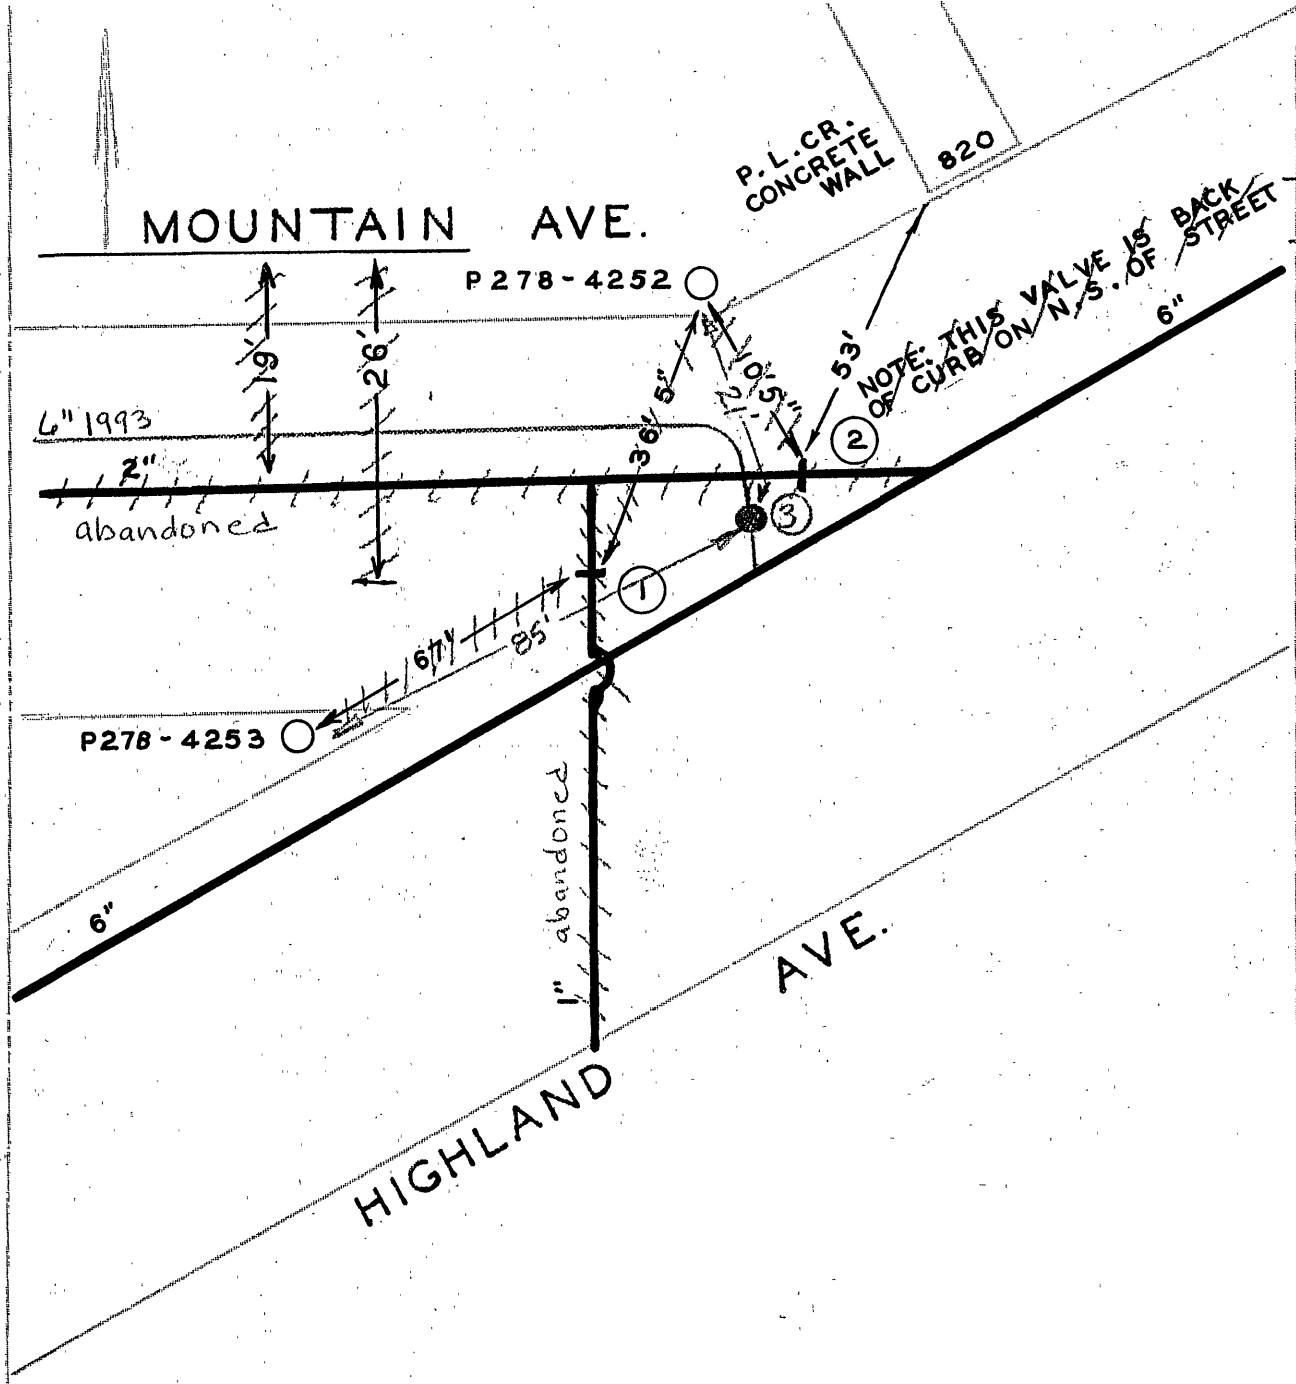

DATE	NO.	SIZE	MAKE	OPEN	TURNS
~~1909~~	~~1~~	~~1"~~	~~CURB COCK~~		
~~1927~~	~~2~~	~~2"~~		~~R~~	~~8 1/2~~
6/ 1993	3	6"	Darling	R	
	1	254-W	WPL	9TH ST.	
	2	216-W	WPL	9TH ST.	

11/20/42. J.H.W.

CITY OF ROANOKE—WATER DEP'T

VALVE DIAGRAM

HIGHLAND AVE. &
MOUNTAIN AVE. S.E.

SEC. MAP 412

DATE PAGE NO. S.E. 139