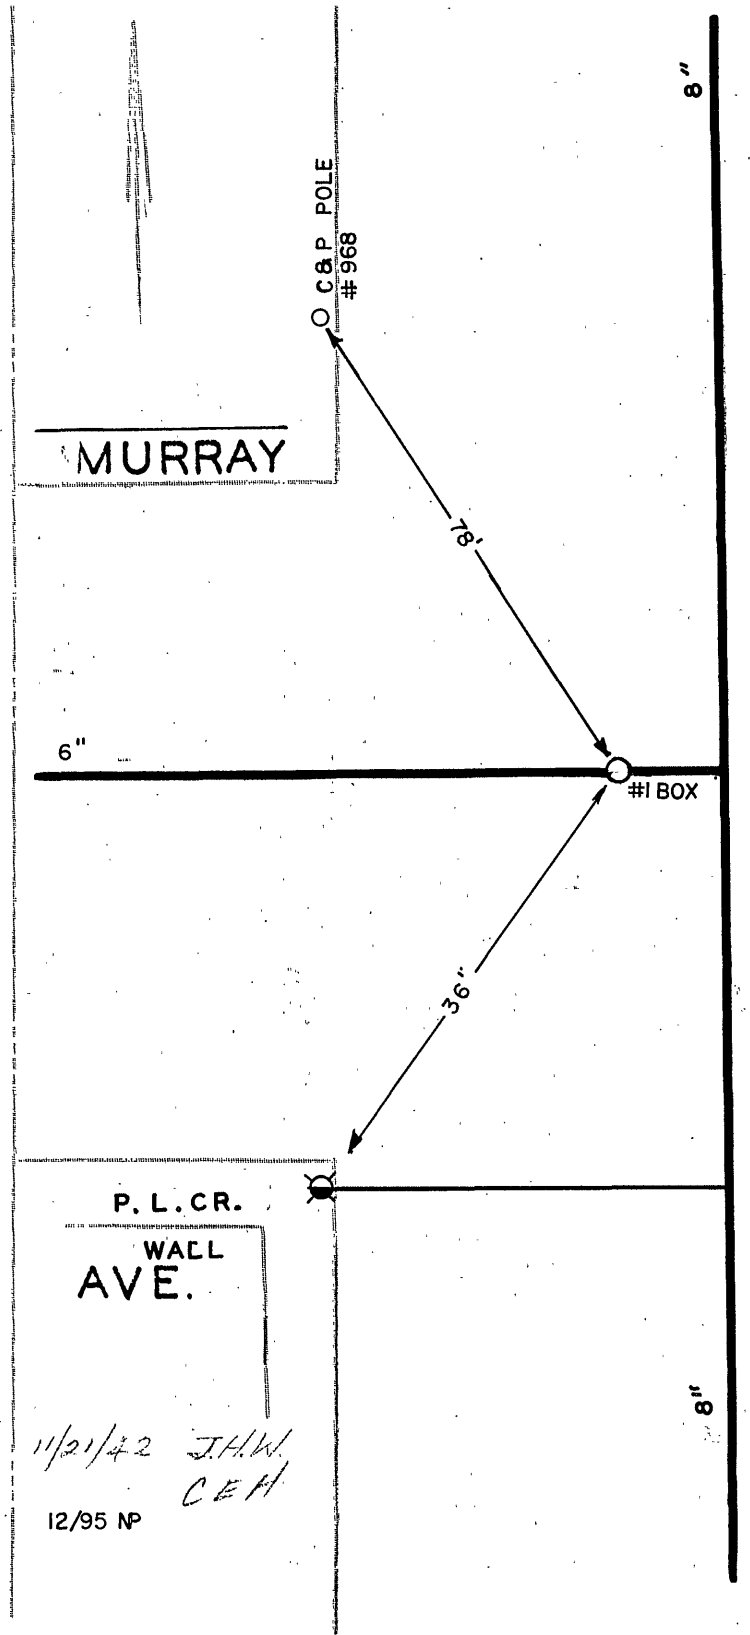

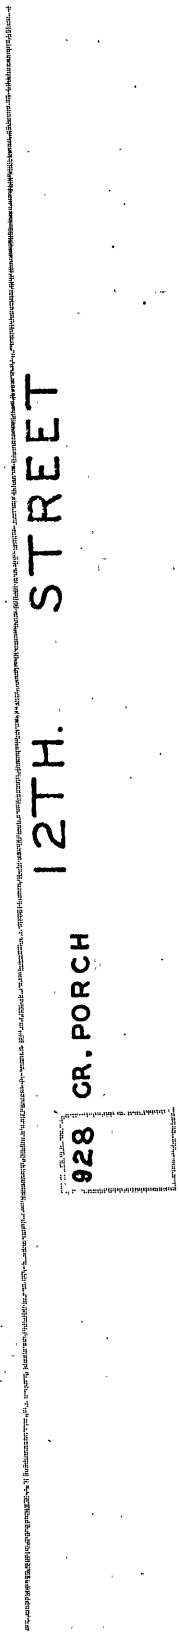

DATE	NO.	SIZE	MAKE	OPEN	TURNS
1994	1	6"	MUELLER	R	21

CITY OF ROANOKE—WATER DEPT.

VALVE DIAGRAM

MURRAY AVE. & 12TH. ST. S.E.

SEC MAP 412

DATE

PAGE NO. S.E.145