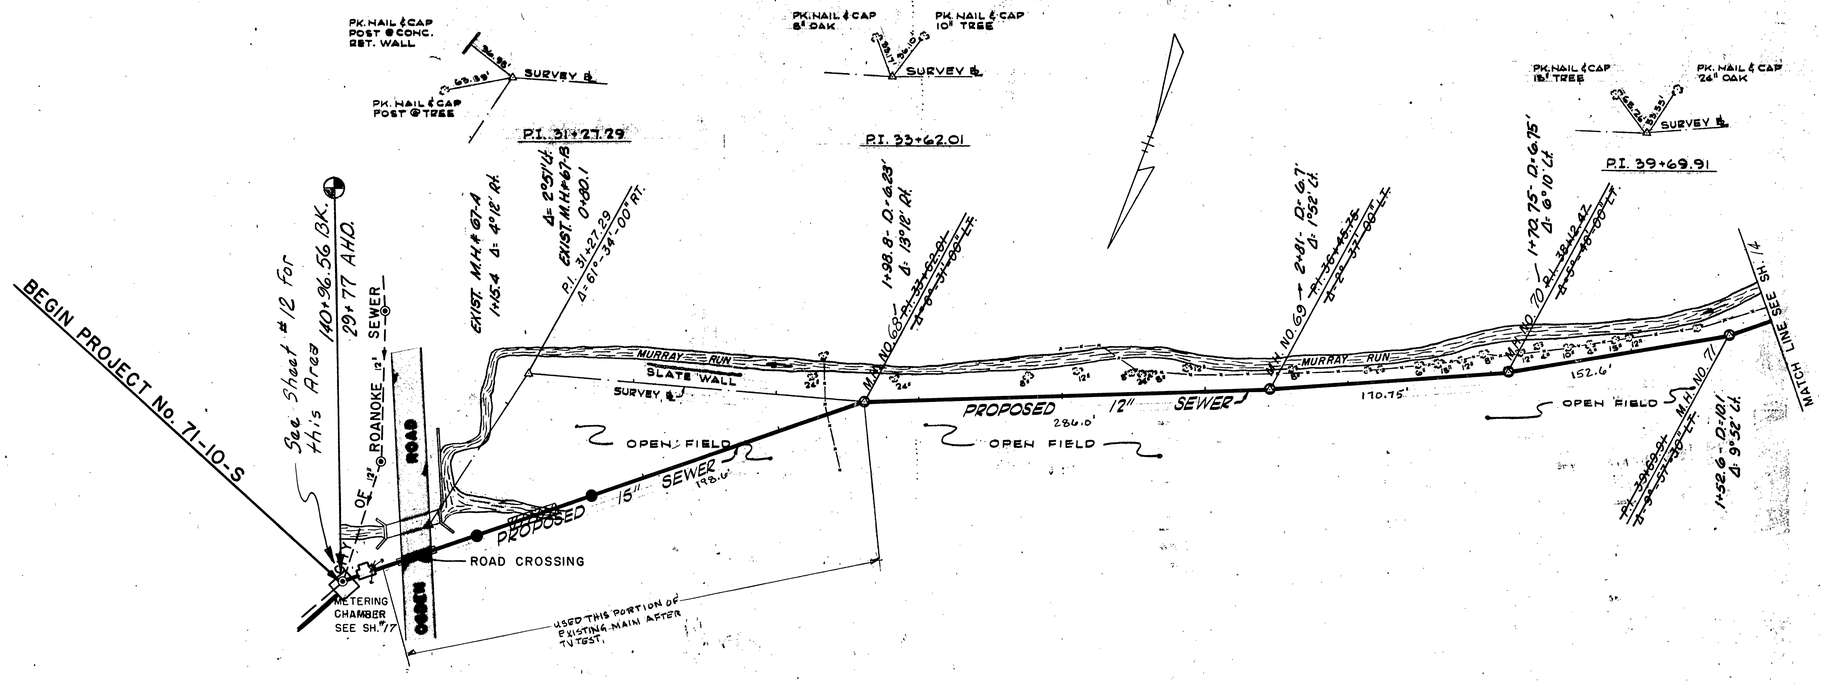

SCALE: 1 IN = 50 FT

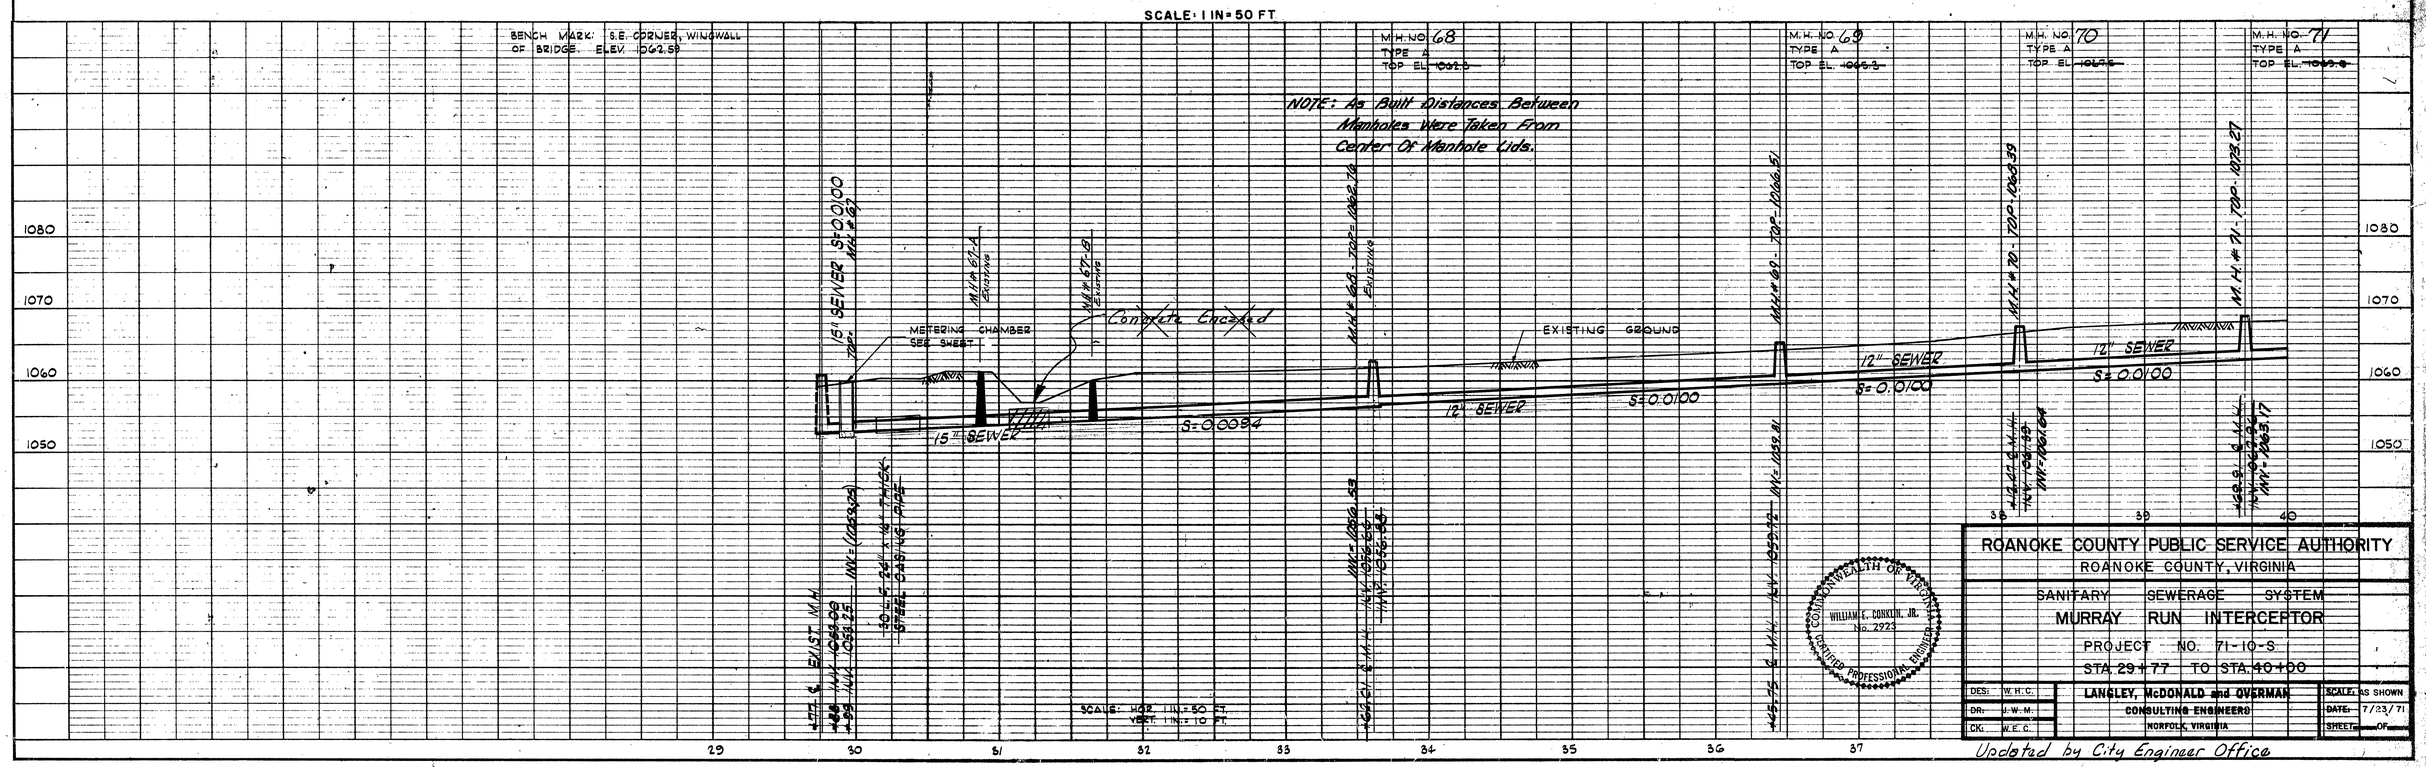

PLAN		BY	DATE
NOTE BOOK	SURVEYED. PLOTTED. ALIGNMENT CHECKED. RT. OF WAY CHECKED.		
NO.			

PROFILE		BY	DATE
NOTE BOOK	SURVEYED. PLOTTED. GRADES CHECKED. R.R. X'INGS. STRUCTURE NOTATIONS CHECKED.		
No.			

ROANOKE COUNTY PUBLIC SERVICE AUTHORITY
ROANOKE COUNTY, VIRGINIA
SANITARY SEWERAGE SYSTEM
MURRAY RUN INTERCEPTOR
PROJECT NO. 71-10-S
STA. 29+77 TO STA. 40+00

DES: W.H.C.	LANGLEY, McDONALD and OVERMAN	SCALE: AS SHOWN	
DR: J.W.M.	CONSULTING ENGINEERS	DATE: 7/23/71	
CK: W.E.C.	NORFOLK, VIRGINIA	SHEET ___ OF ___	

COMMONWEALTH OF VIRGINIA
WILLIAM E. CONKLIN, JR.
No. 2923
CERTIFIED PROFESSIONAL ENGINEER

Updated by City Engineer Office

Corrected To As Built.
See Book # 597

Sheet #13 of 18
Plan No. 5412

K+E PLATE 1, PLAN-PROFILE
KEUFFEL & ESSER CO.
48 7003 MADE IN U.S.A.