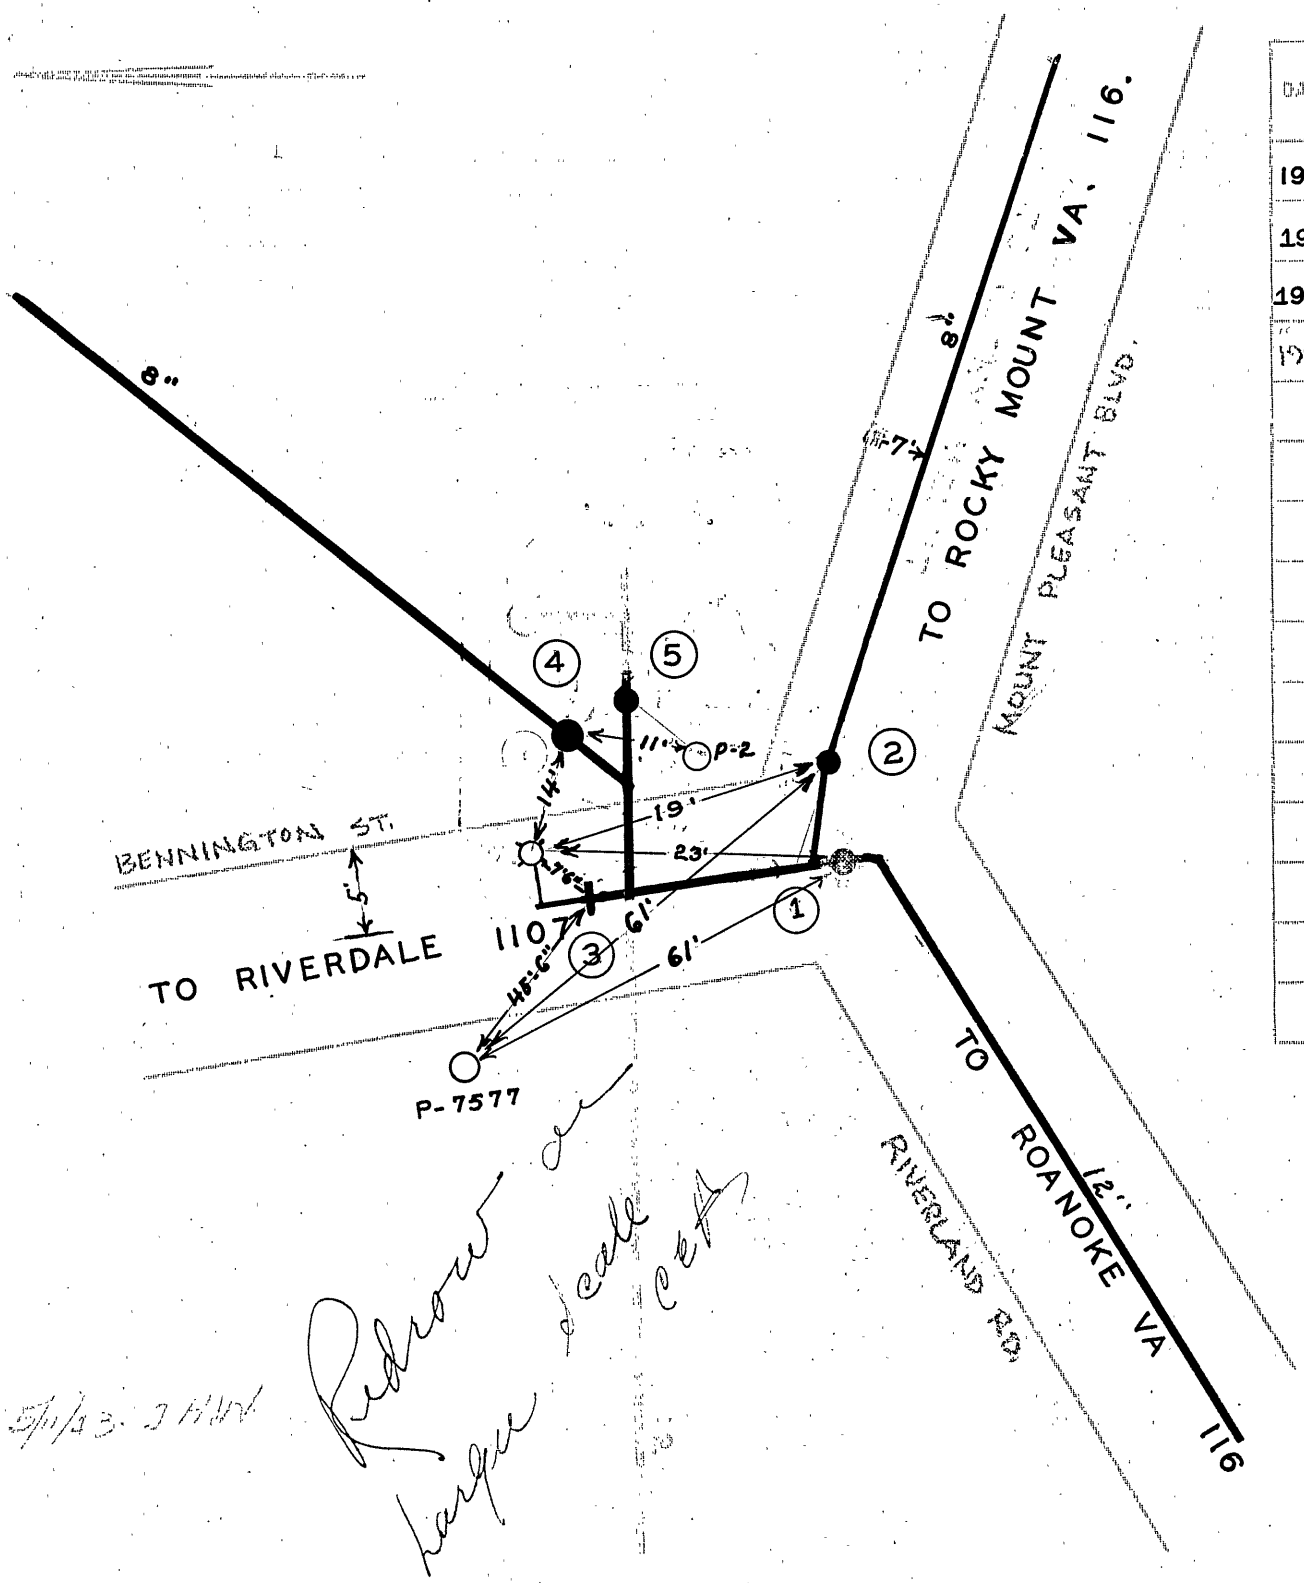

DATE	NO.	SIZE	MAKE	OPEN	TURNS
1917	4	8"		R	27
1947	3	12"	DARLING	R	38
1947	1	12"	DARLING	R	38
1953	2	8"			
	5	10"			
	1	61'N	S.P.L		
	2	0	E.P.L.		
	3	0	N.P.L.		
	4	IN	LOT		
	5	IN	LOT in Meter Vault		

CITY OF ROANOKE — WATER DEP'T

VALVE DIAGRAM

MUSE SPRING PUMPING STATION

SEC. MAP S-425

DATE

PAGE NO. S.E. 89

Redrawn on large scale