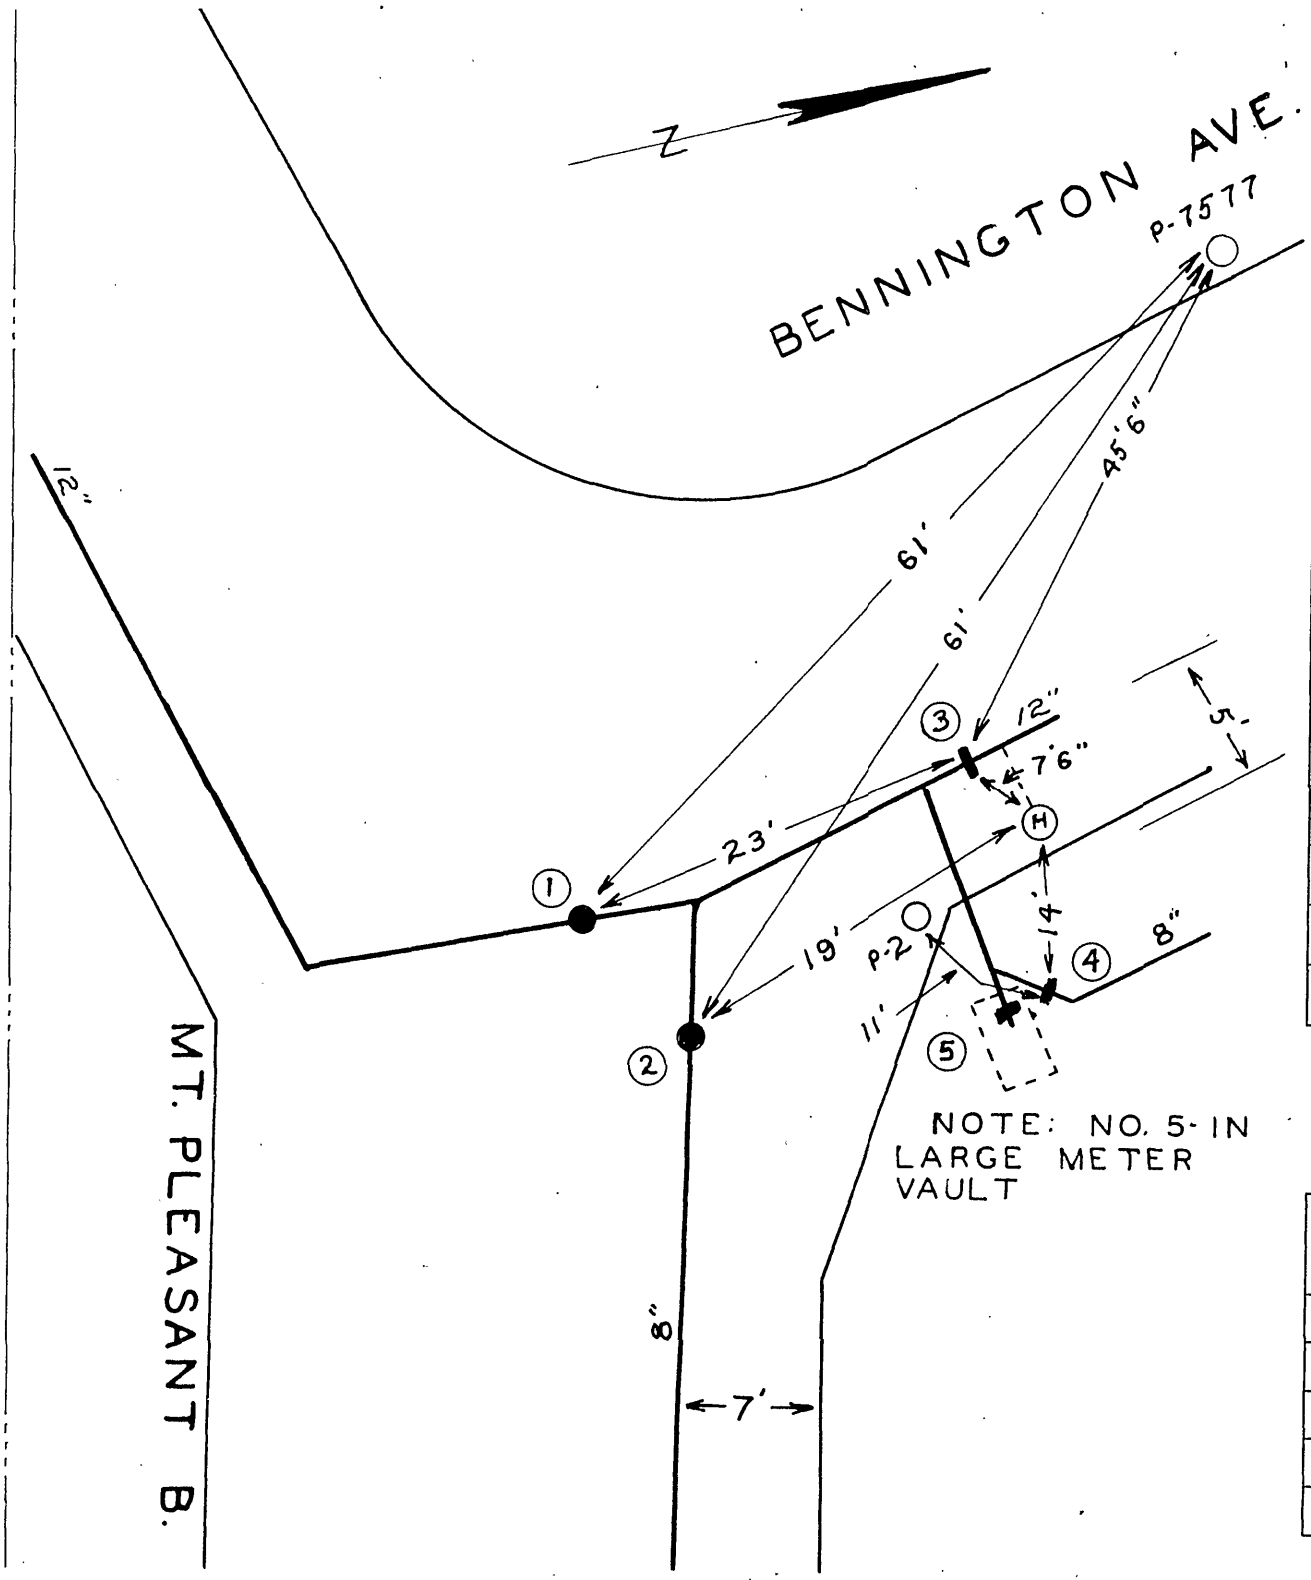

NOTE: NO. 5 IN LARGE METER VAULT

DATE	NO.	SIZE	MAKE	OPEN	TURNS
	1	12"			
	2	8"			
	3	12"			
	4	8"			
	5	10"			
	1	61'-N	SPL		
	2	0	EPL		
	3	0	NPL		
	4	IN	LOT		
	5	IN	VAULT		

CITY OF ROANOKE—WATER DEPT.

VALVE DIAGRAM

BENNINGTON AVE. &

MT. PLEASANT BLVD. S.E.

MUSE SPRING P.S.

SEC. MAP

DATE PAGE NO.

"IMPERIAL" TRACING CLOTH K & E CO., N.Y.