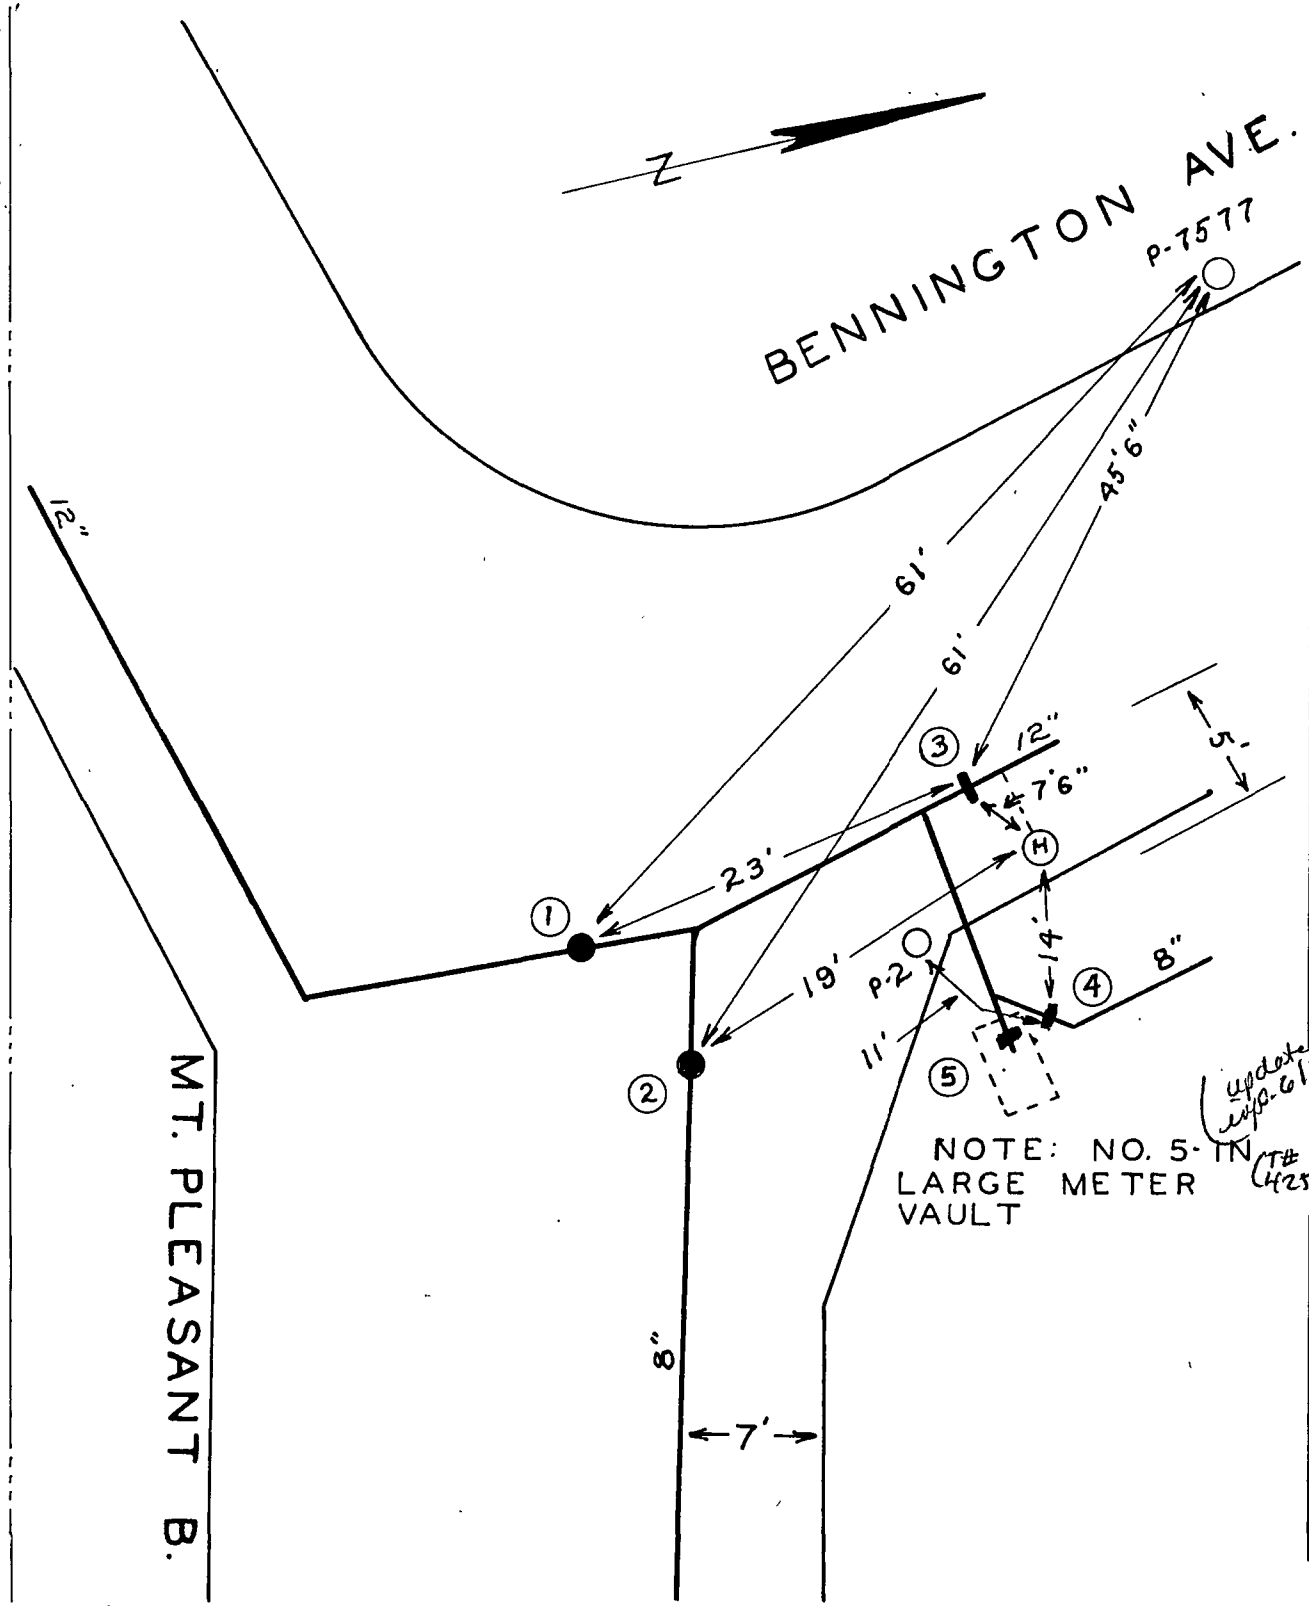

DATE	NO.	SIZE	MAKE	OPEN	TURNS
	1	12"			
	2	8"			
	3	12"			
	4	8"			
	5	10"			
	1	61'-N	SPL		
	2	0	EPL		
	3	0	NPL		
	4	IN	LOT		
	5	IN	VAULT		

(updated info. 6/2005 (T# 4250 20)) abandoned - replaced years later in 1994 w/ Mt. Pleasant Pump Station - next to Fire Stat. at 2264 Bennington St. S.E.

CITY OF ROANOKE — WATER DEPT. VALVE DIAGRAM	
BENNINGTON AVE. &	
MT. PLEASANT BLVD. S.E.	
MUSE SPRING P.S.	
SEC. MAP	
DATE	PAGE NO.

"IMPERIAL" TRACING CLOTH K & E CO., N. Y.