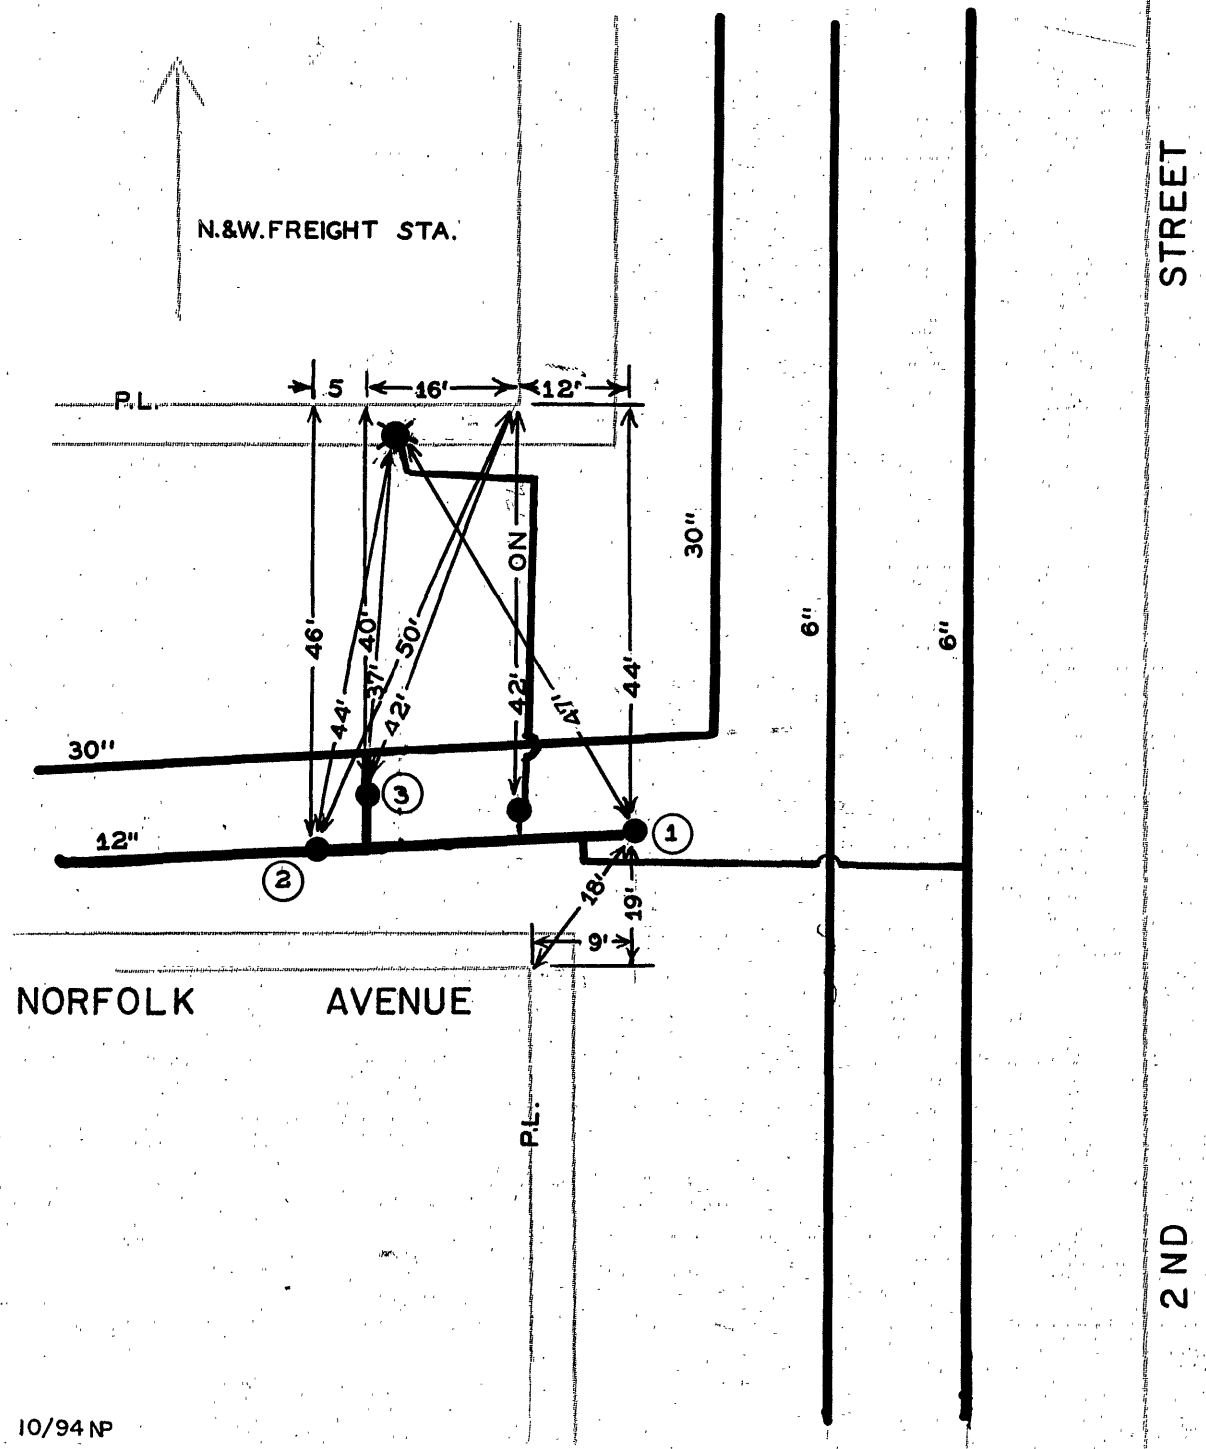

DATE	NO.	SIZE	NAME	OPEN	TURNS
1917	1	12"	KEEP CLOSED		
1946	2	12"	DARLING	R	38
1946	3	12"	M & H	L	26

CITY OF ROANOKE—WATER DEP'T
VALVE DIAGRAM

NORFOLK AVENUE &
2ND STREET
SOUTH INTERSECTION

SEC. MAP 101 S.W.

DATE PAGE NO. S.W. 5

10/94 NP