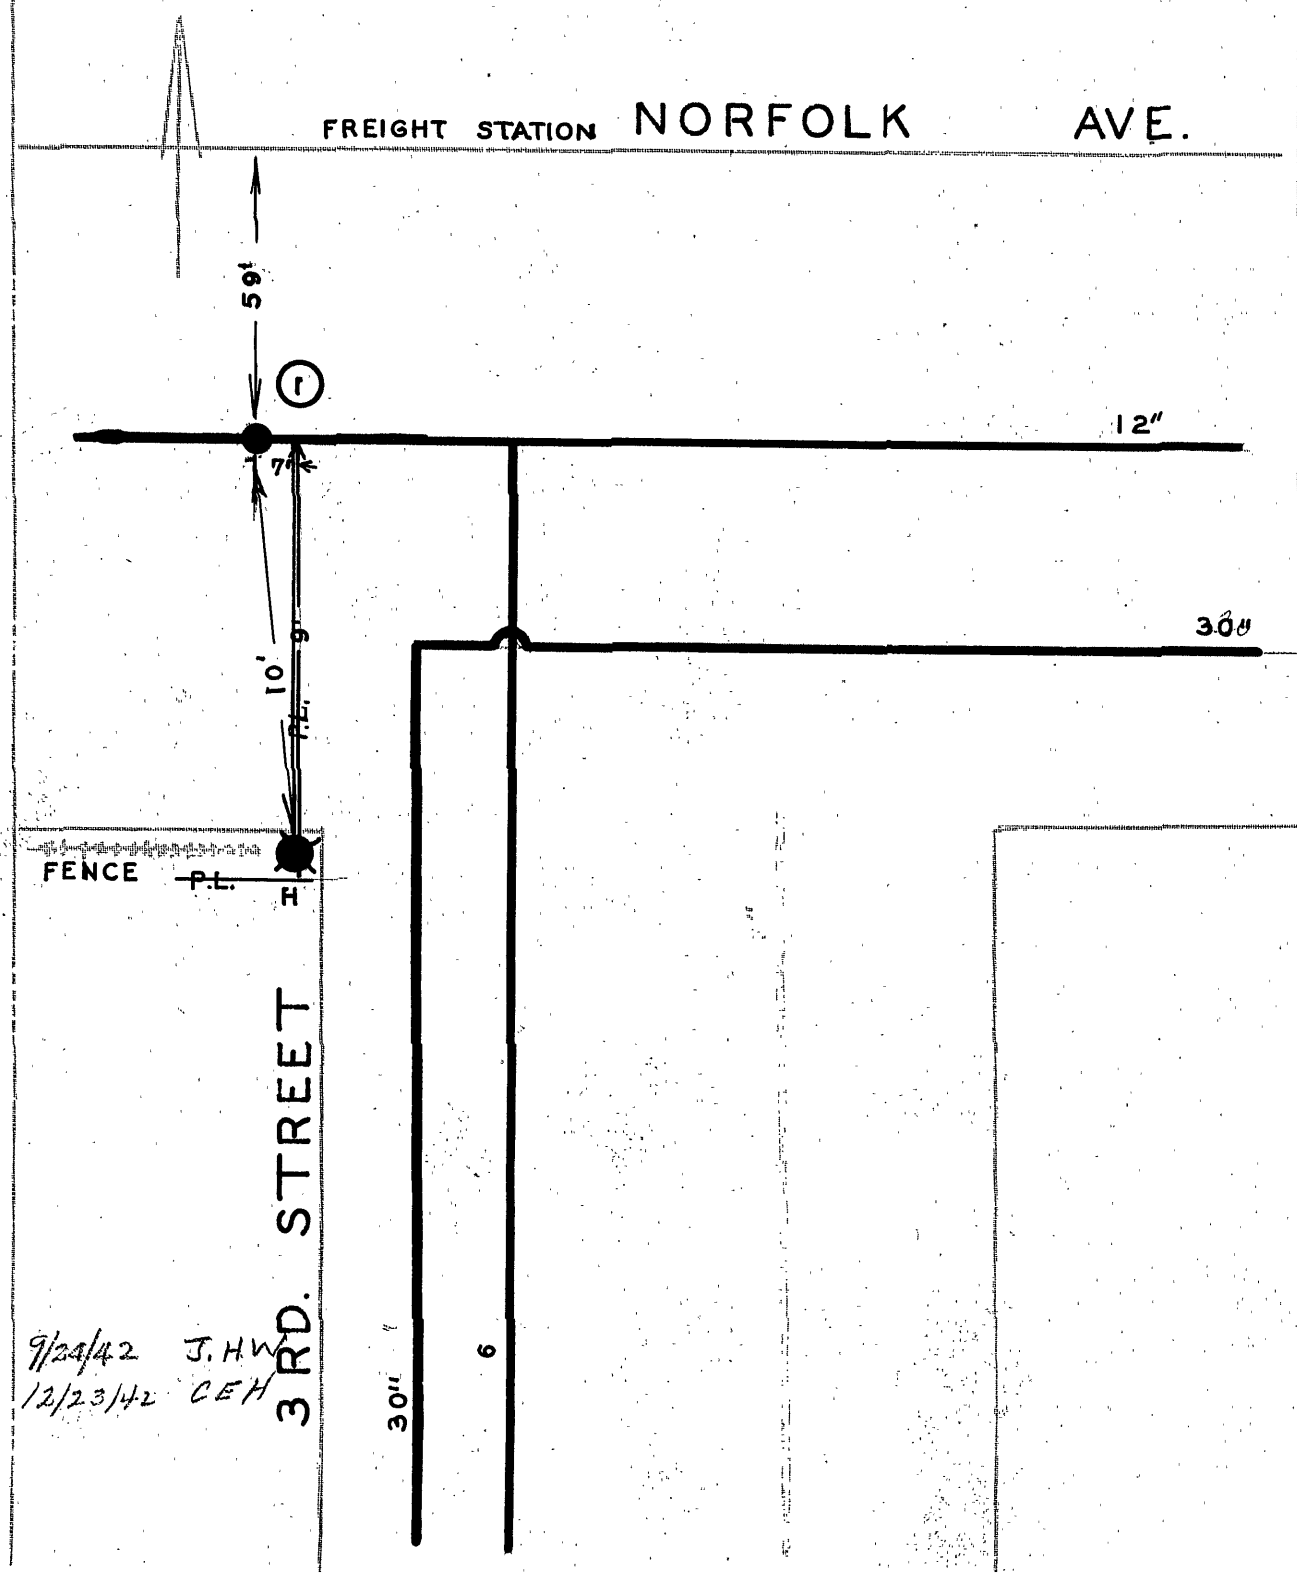

DATE	NO.	SIZE	MAKE	OPEN	TURNS
1917	1	12"		R	39
	1	7'-W	WPL		

CITY OF ROANOKE — WATER DEP'T

VALVE DIAGRAM

NORFOLK AVE. & 3RD. ST. S.W.

SEC. MAP 101

DATE

PAGE NO. S.W. 6