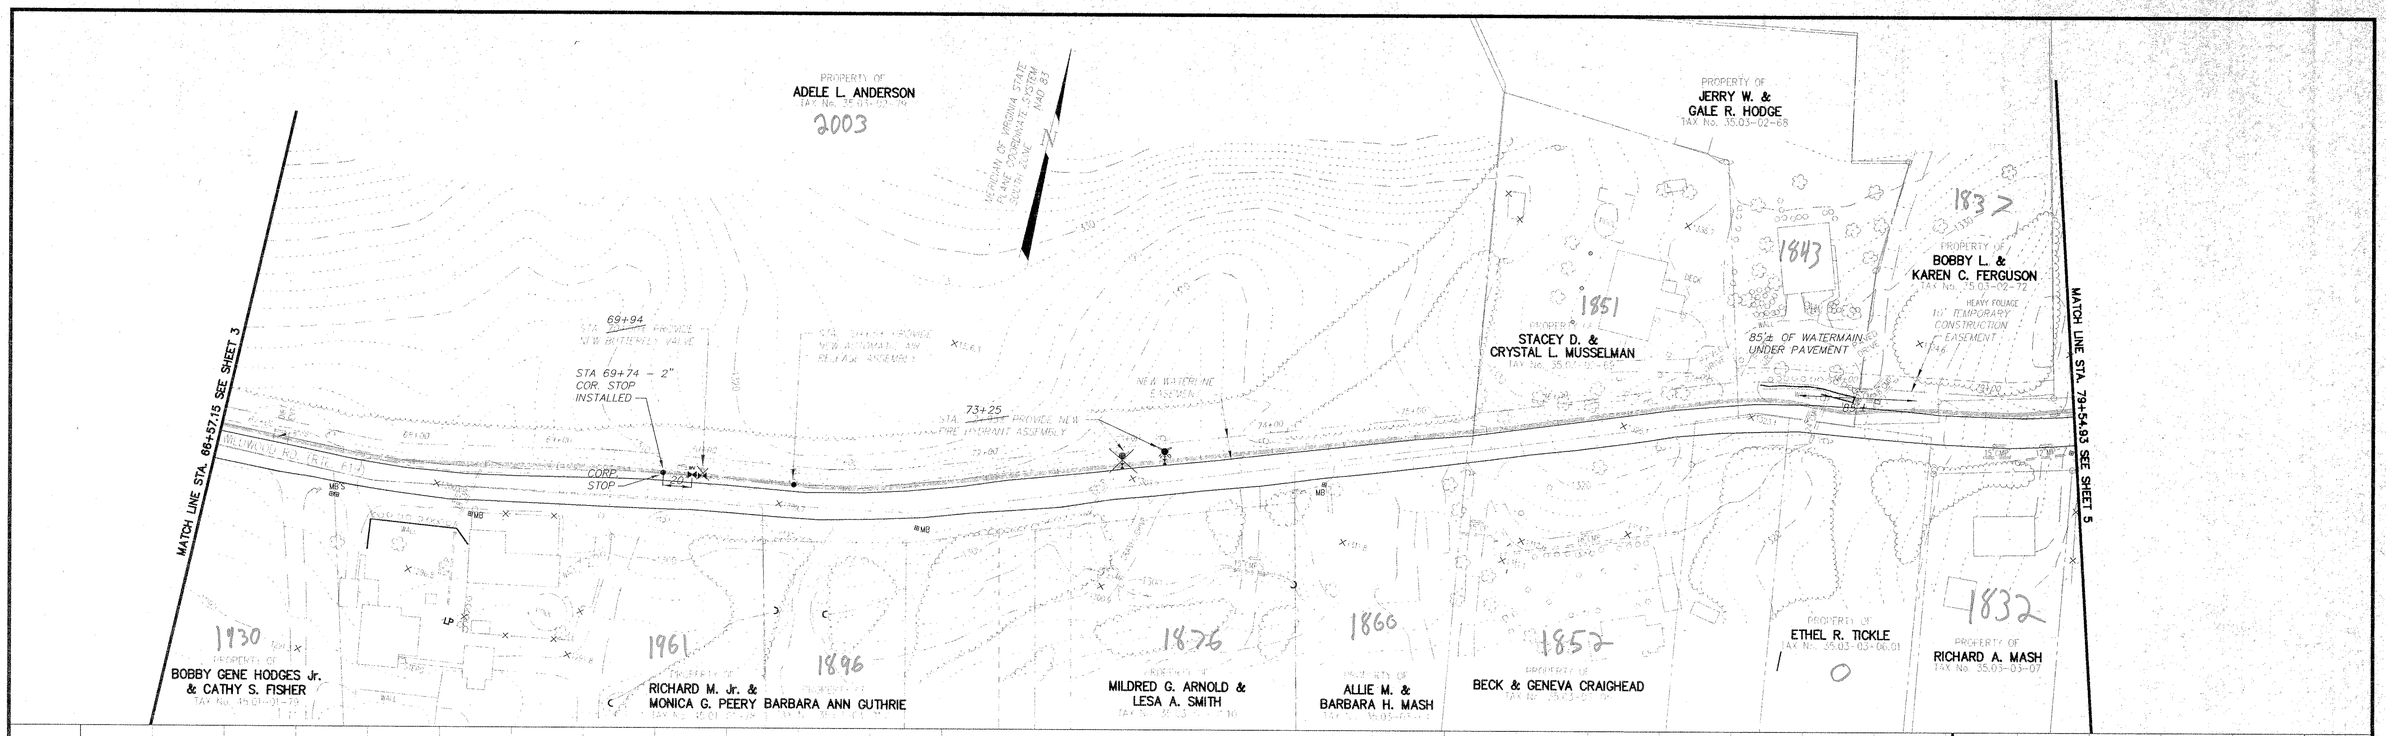

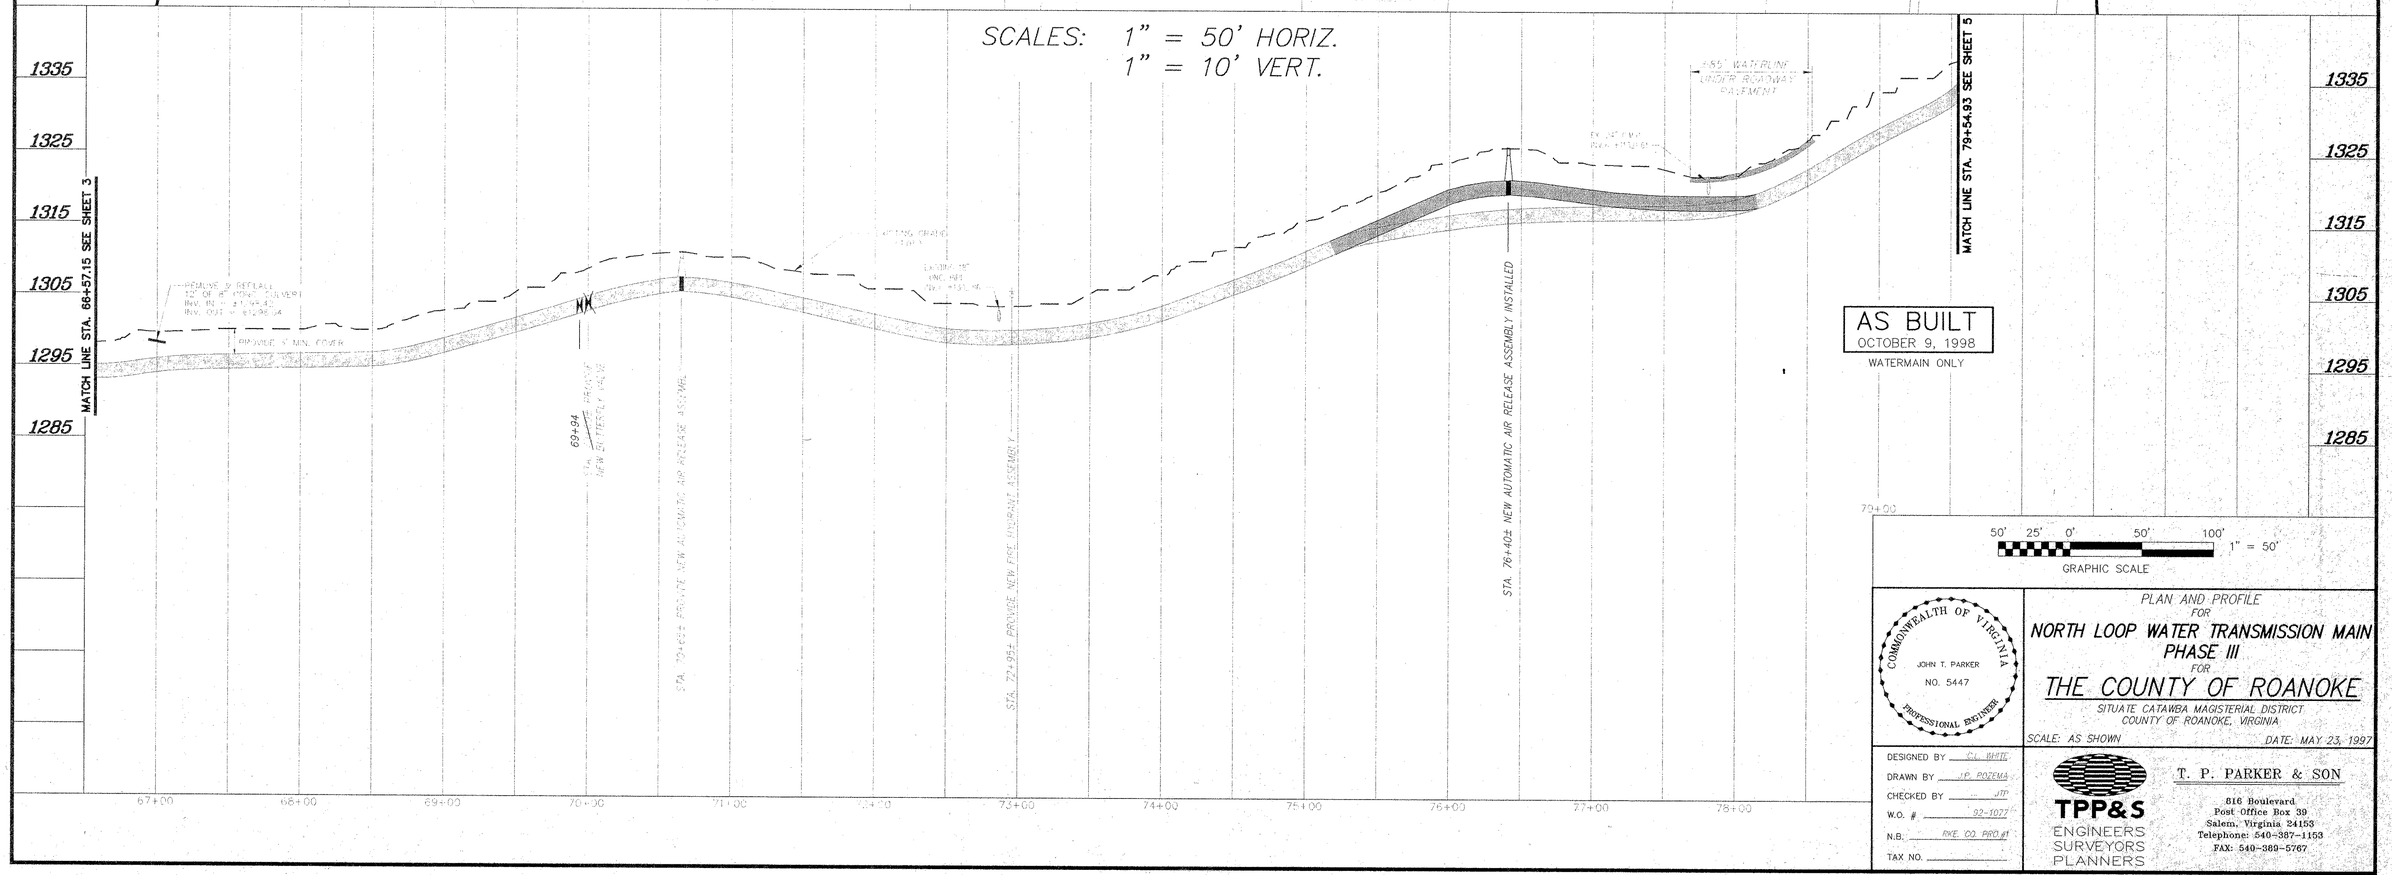

AS BUILT
OCTOBER 9, 1998
WATERMAIN ONLY

50' 25' 0' 50' 100' 1" = 50'
GRAPHIC SCALE

COMMONWEALTH OF VIRGINIA
JOHN T. PARKER
NO. 5447
PROFESSIONAL ENGINEER

PLAN AND PROFILE
FOR
NORTH LOOP WATER TRANSMISSION MAIN
PHASE III
FOR
THE COUNTY OF ROANOKE
SITUATE CATAWBA MAGISTERIAL DISTRICT
COUNTY OF ROANOKE, VIRGINIA

SCALE: AS SHOWN
DATE: MAY 23, 1997

DESIGNED BY CL. BHTE
DRAWN BY JP. POZEMA
CHECKED BY JTP
W.O. # 92-1077
N.B. RKE. CO. PRO.#1
TAX NO.

TPP&S
ENGINEERS
SURVEYORS
PLANNERS

T. P. PARKER & SON
816 Boulevard
Post Office Box 39
Salem, Virginia 24153
Telephone: 540-387-1153
FAX: 540-389-5767