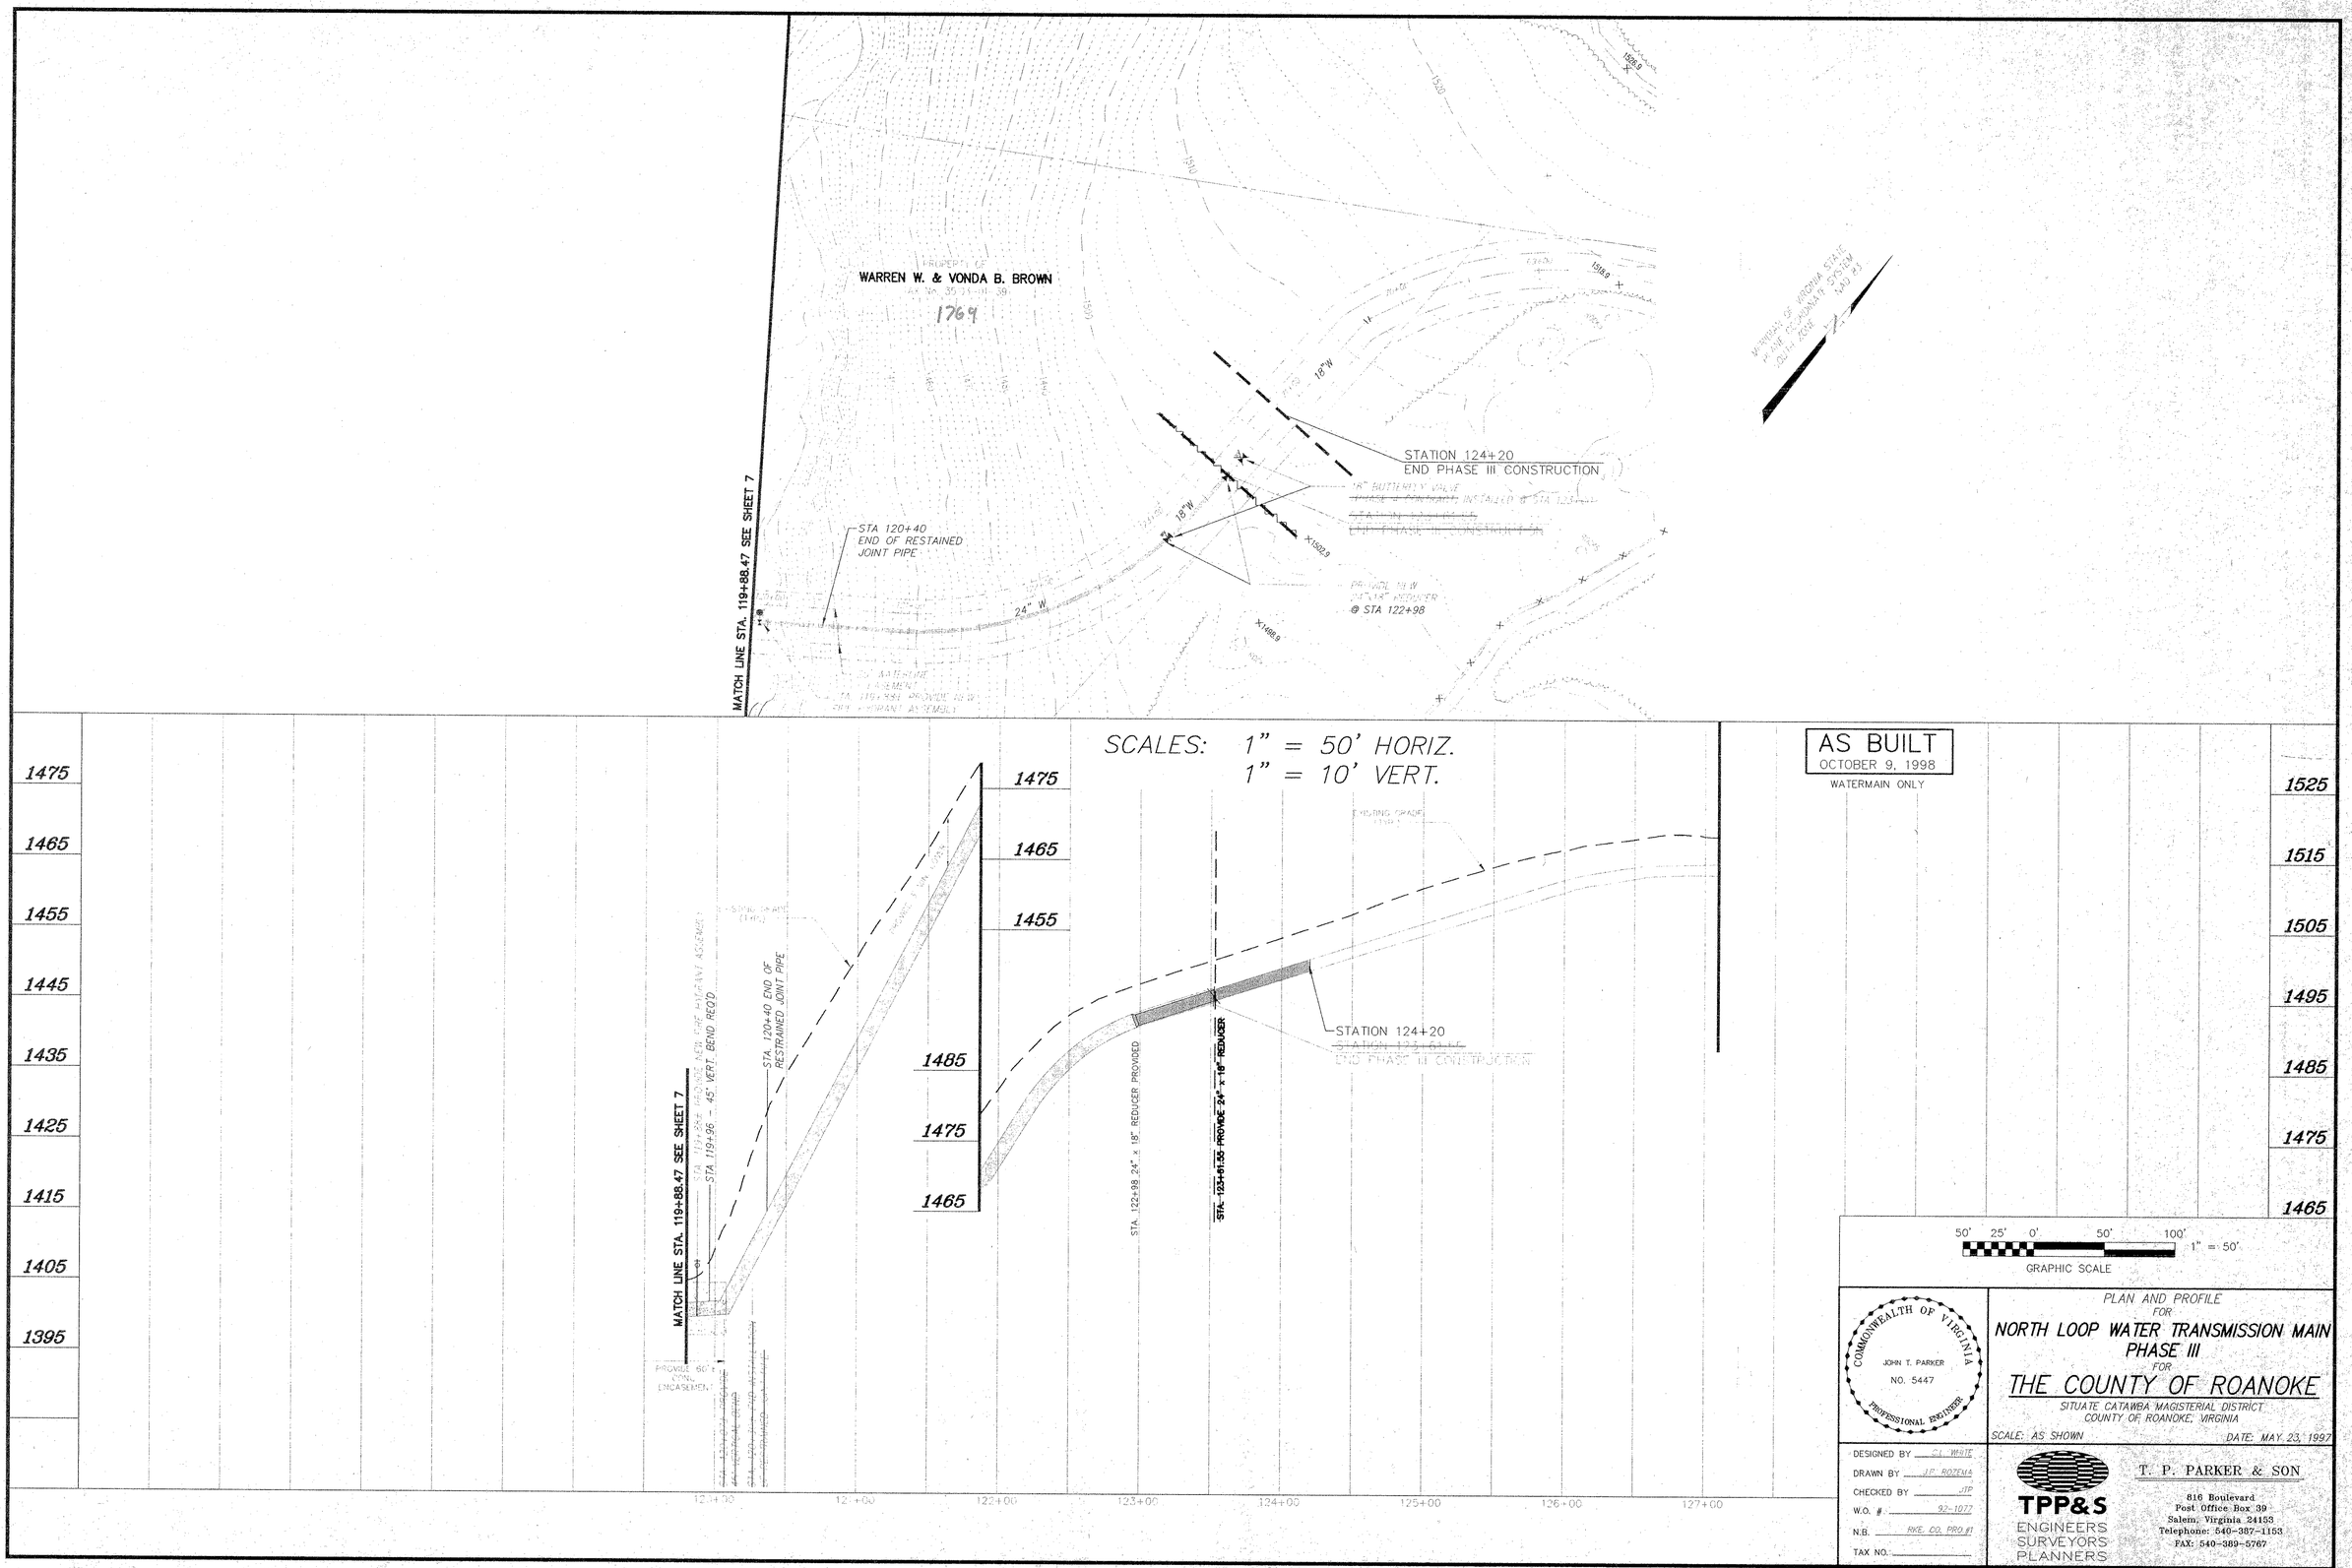
WARREN W. & VONDA B. BROWN
1769
MATCH LINE STA. 119+88.47 SEE SHEET 7
STA 120+40
END OF RESTAINED
JOINT PIPE
24" W
18"W
STATION 124+20
END PHASE III CONSTRUCTION
18" BUTTERFLY VALVE
@ STA 122+98
MERIDIAN OF VIRGINIA STATE
PLANE COORDINATE SYSTEM
SOUTH ZONE
NAD 83
SCALES: 1" = 50' HORIZ.
1" = 10' VERT.
AS BUILT
OCTOBER 9, 1998
WATERMAIN ONLY
1475
1465
1455
1445
1435
1425
1415
1405
1395
1485
1525
1515
1505
1495
STA. 120+40 END OF
RESTAINED JOINT PIPE
STA. 122+98 24" x 18" REDUCER PROVIDED
STA. 123+61.55 PROVIDE 24" x 18" REDUCER
STATION 124+20
END PHASE III CONSTRUCTION
50' 25' 0' 50' 100'
1" = 50'
GRAPHIC SCALE
COMMONWEALTH OF VIRGINIA
JOHN T. PARKER
NO. 5447
PROFESSIONAL ENGINEER
PLAN AND PROFILE
FOR
NORTH LOOP WATER TRANSMISSION MAIN
PHASE III
FOR
THE COUNTY OF ROANOKE
SITUATE CATAWBA MAGISTERIAL DISTRICT
COUNTY OF ROANOKE, VIRGINIA
SCALE: AS SHOWN
DATE: MAY 23, 1997
DESIGNED BY C.L. WHITE
DRAWN BY J.P. ROZEMA
CHECKED BY JTP
W.O. # 92-1077
N.B. RKE. CO. PROJ #1
TAX NO.
TPP&S
ENGINEERS
SURVEYORS
PLANNERS
T. P. PARKER & SON
816 Boulevard
Post Office Box 39
Salem, Virginia 24153
Telephone: 540-387-1153
FAX: 540-389-5767
SHEET 8 OF 9