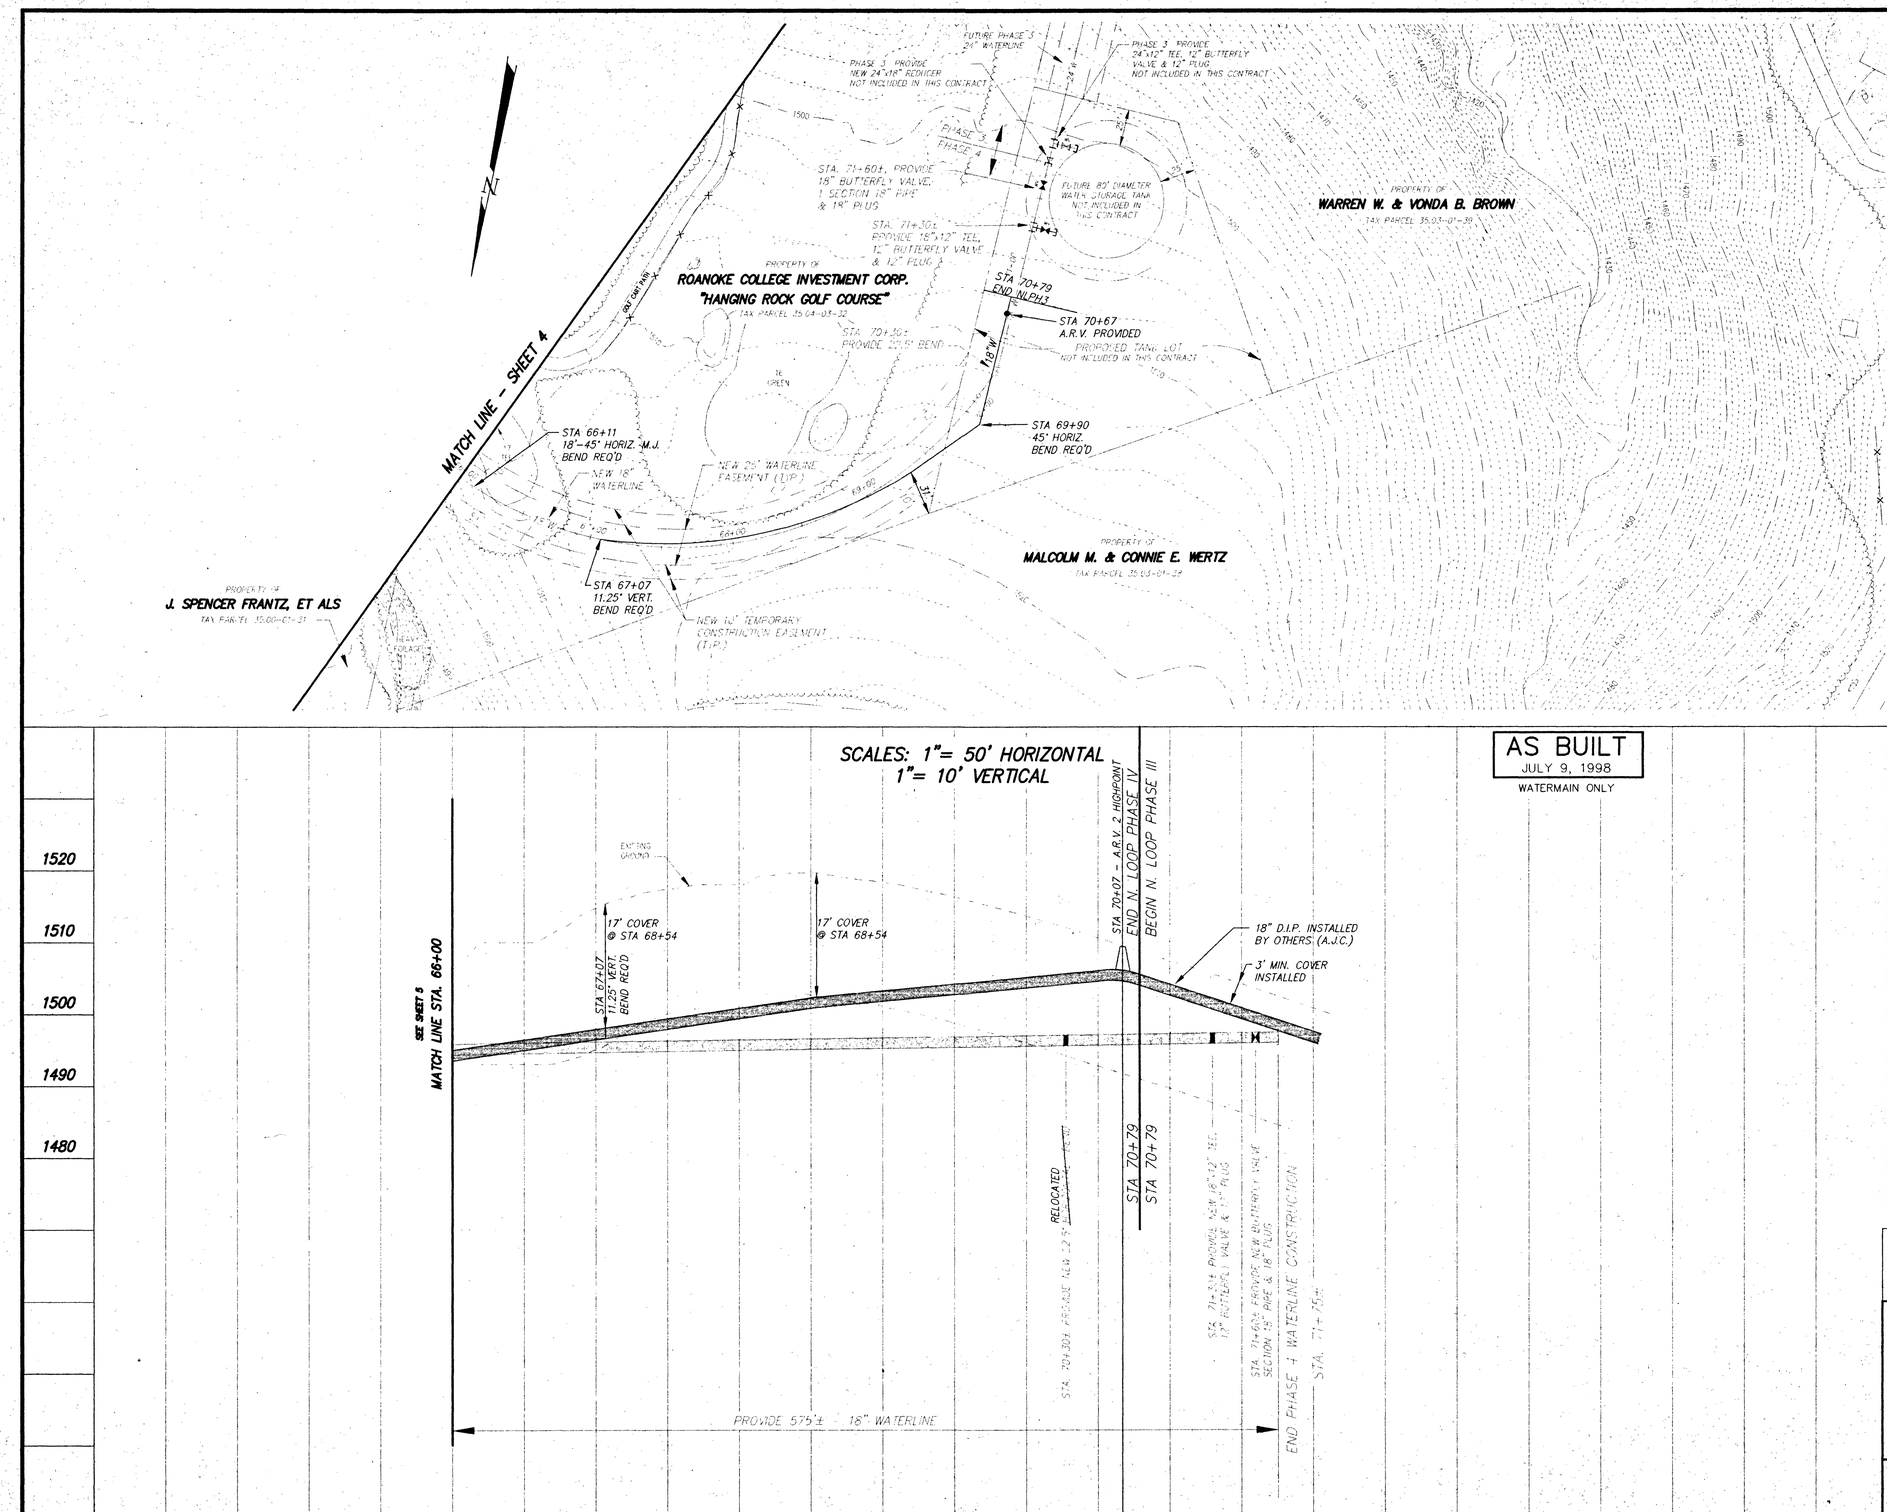

SCALES: 1"= 50' HORIZONTAL
1"= 10' VERTICAL

AS BUILT
JULY 9, 1998
WATERMAIN ONLY

50' 25' 0' 50' 100' 1" = 50'
GRAPHIC SCALE

COMMONWEALTH OF VIRGINIA
JOHN T. PARKER
NO. 5447
PROFESSIONAL ENGINEER

PLAN AND PROFILE
FOR
NORTH LOOP WATER TRANSMISSION MAIN PHASE 4
FOR
THE COUNTY OF ROANOKE
SITUATE CATAWBA MAGISTERIAL DISTRICT
COUNTY OF ROANOKE, VIRGINIA

SCALE: AS SHOWN DATE: DECEMBER 30, 1996

DESIGNED BY C.L. WHITE
DRAWN BY J.J. BERGLOFF
CHECKED BY F.B. CALDWELL
W.O. # 92-1077
N.B. RKE CO. PRO #1
TAX NO.

TPP&S
ENGINEERS
SURVEYORS
PLANNERS

T. P. PARKER & SON
816 Boulevard
Post Office Box 39
Salem, Virginia 24153
Telephone: 540-387-1153
FAX: 540-389-5767