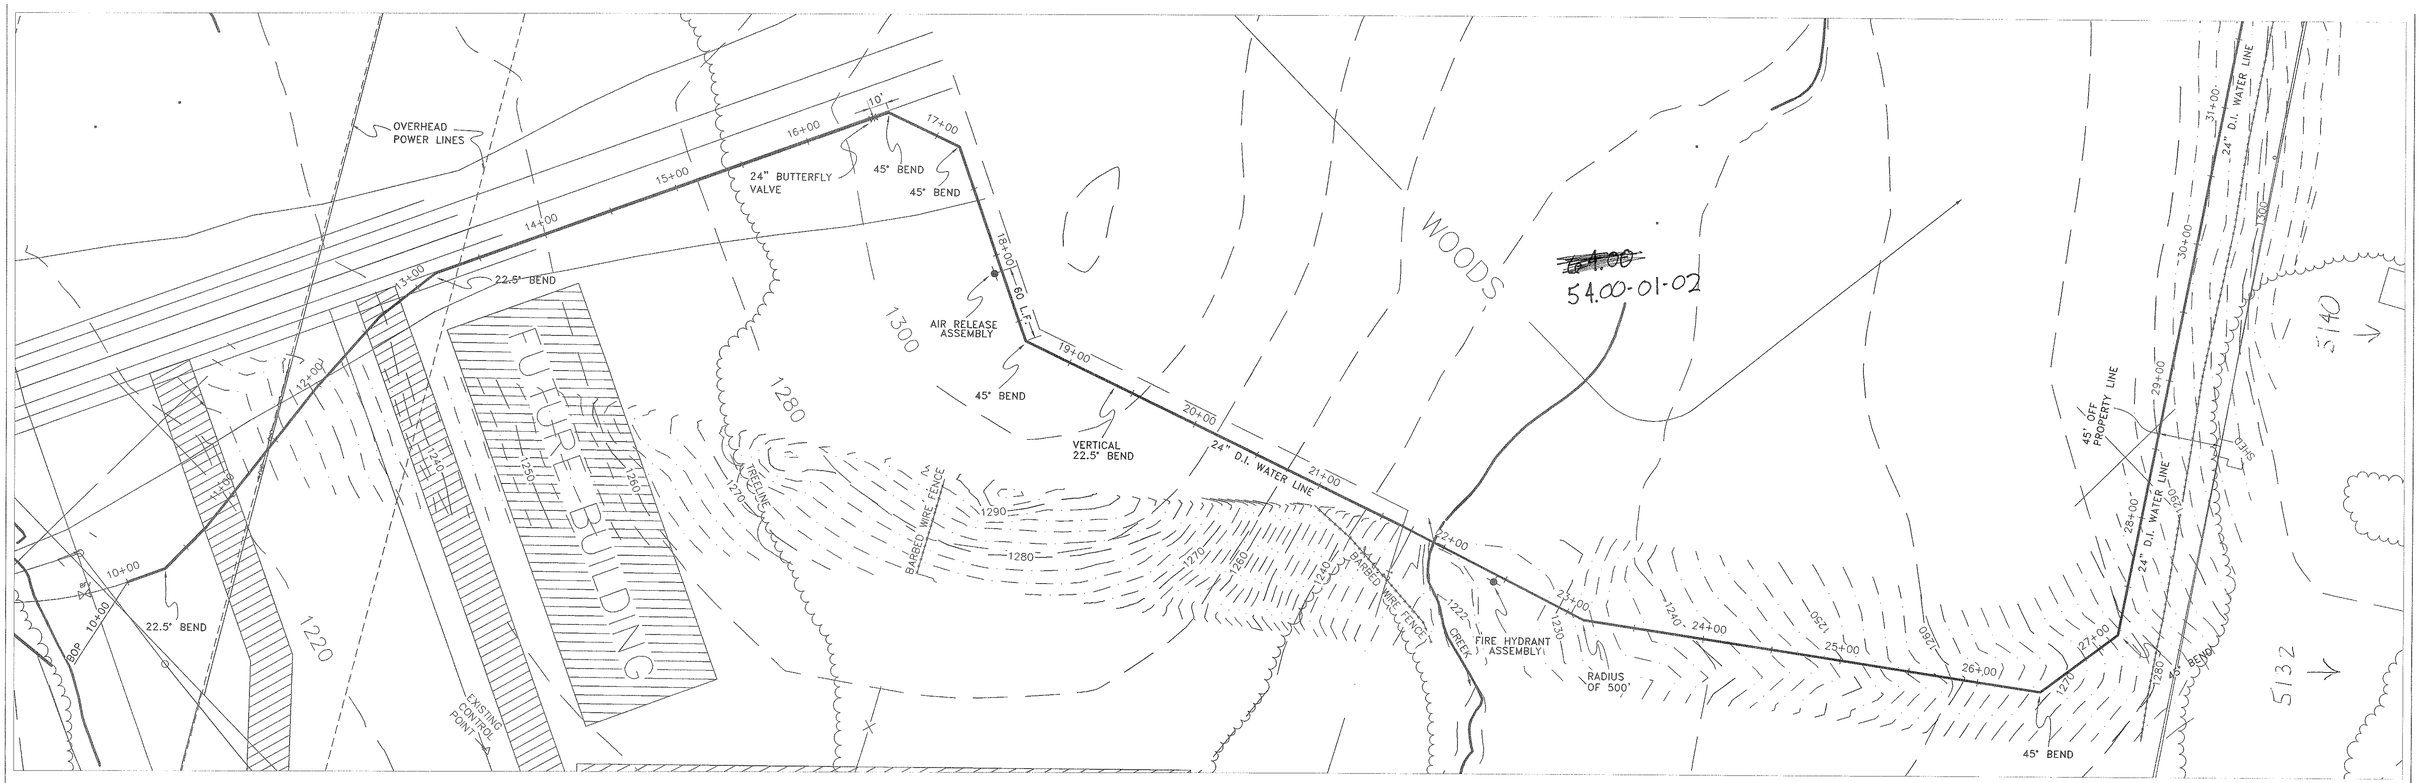

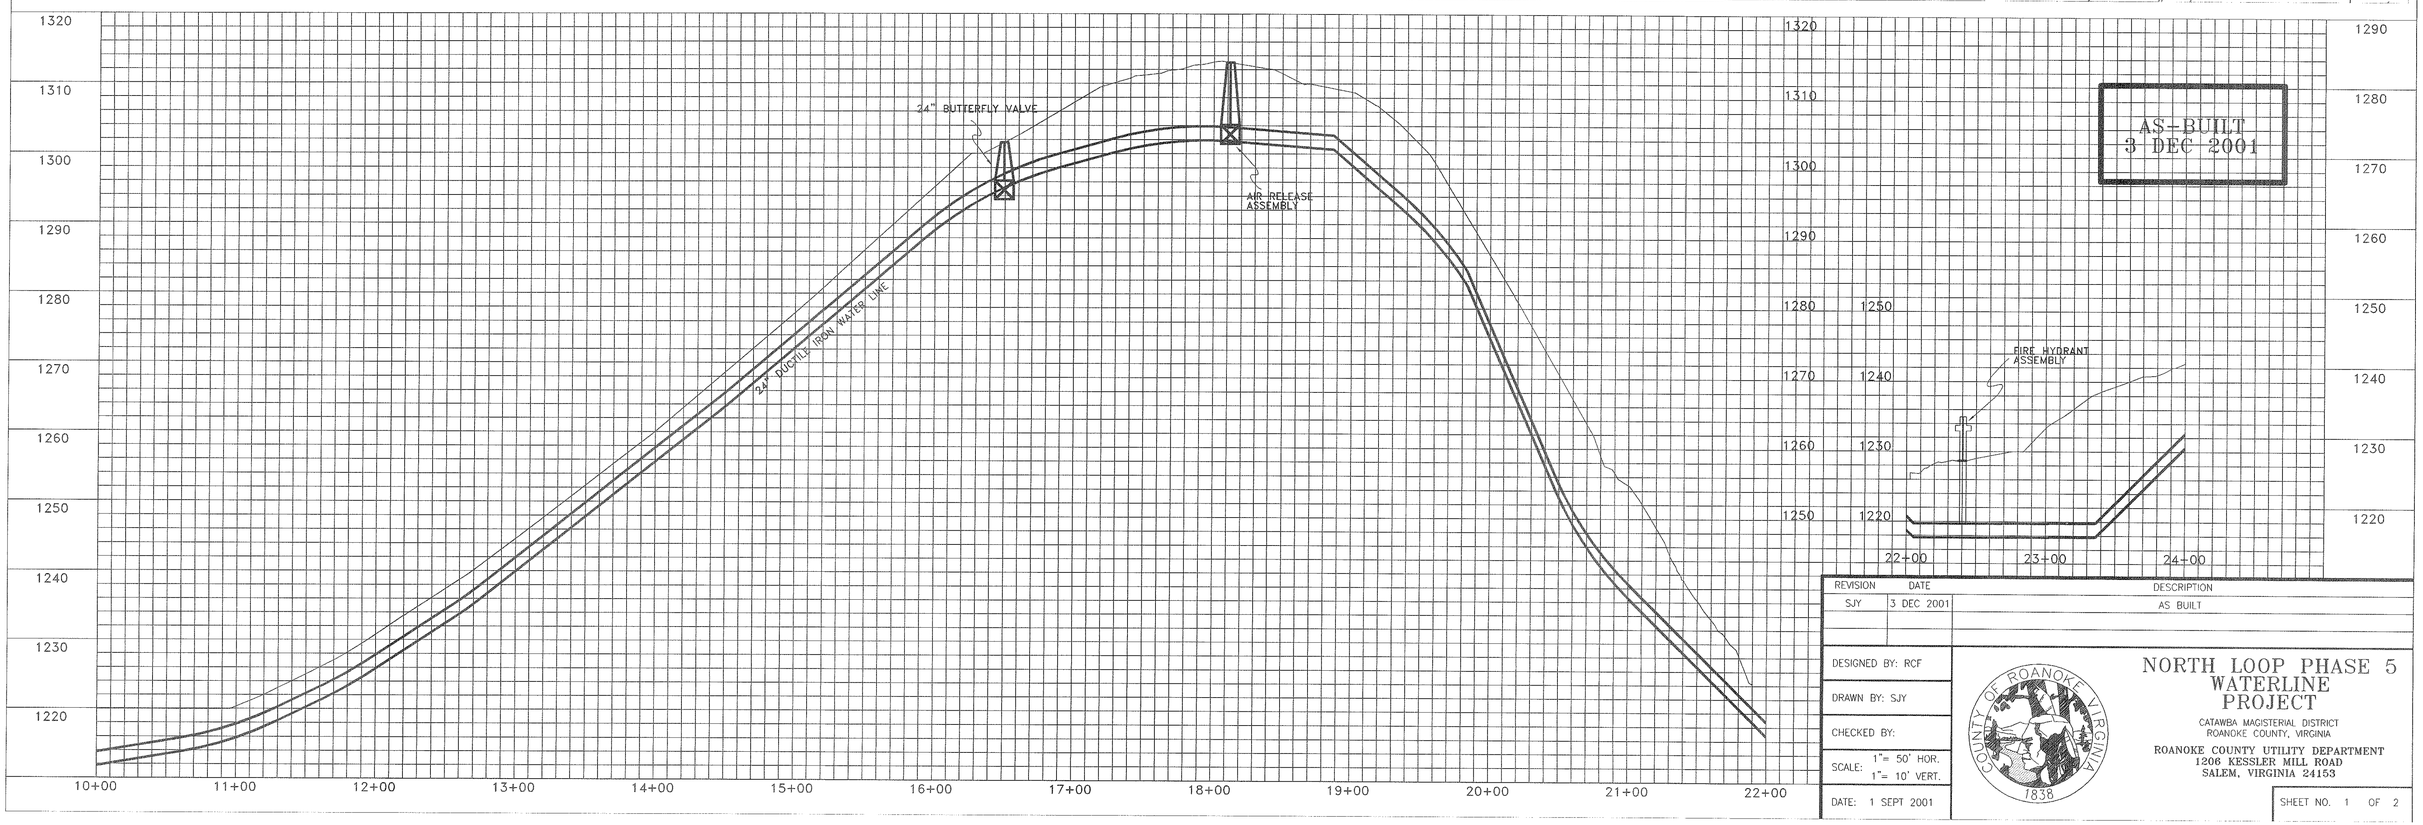

REVISION	DATE	DESCRIPTION
SJY	3 DEC 2001	AS BUILT

DESIGNED BY: RCF

DRAWN BY: SJY

CHECKED BY:

SCALE: 1"= 50' HOR. 1"= 10' VERT.

DATE: 1 SEPT 2001

COUNTY OF ROANOKE VIRGINIA 1838

NORTH LOOP PHASE 5 WATERLINE PROJECT

CATAWBA MAGISTERIAL DISTRICT
ROANOKE COUNTY, VIRGINIA

ROANOKE COUNTY UTILITY DEPARTMENT
1206 KESSLER MILL ROAD
SALEM, VIRGINIA 24153

SHEET NO. 1 OF 2