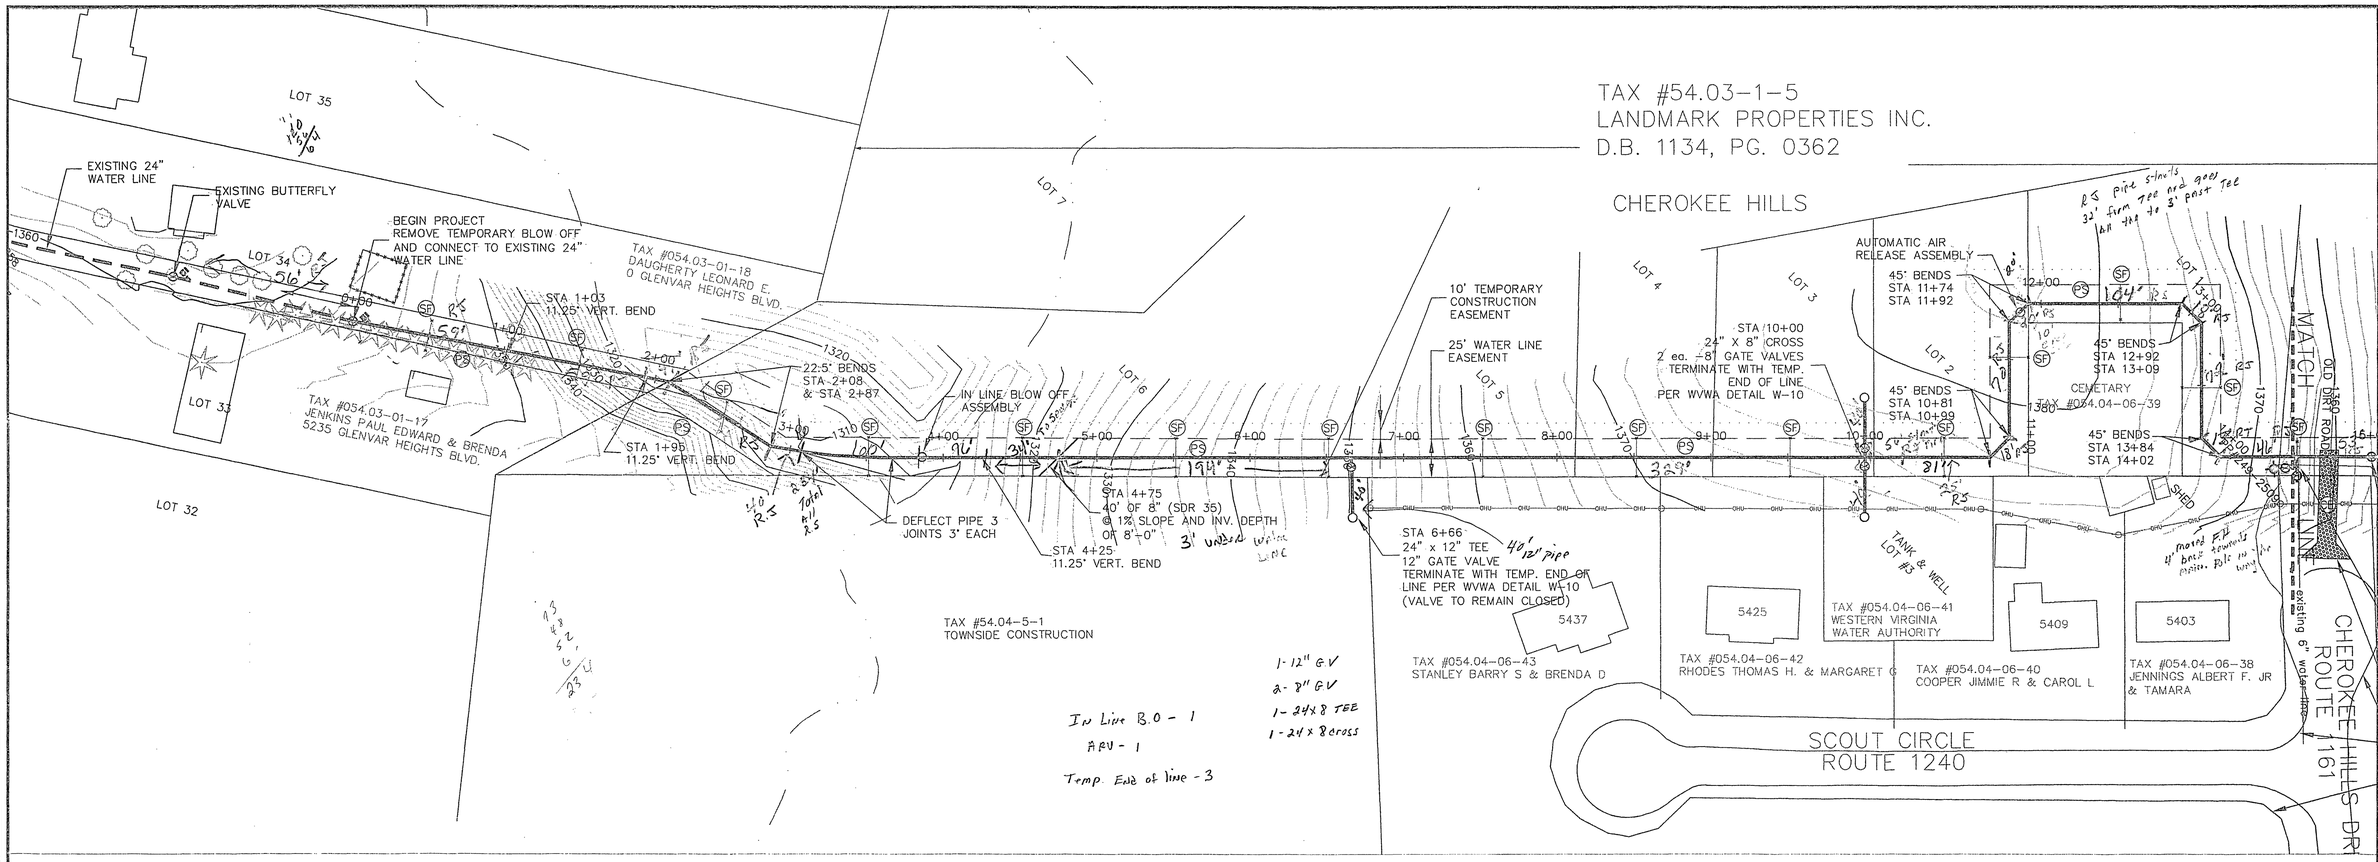

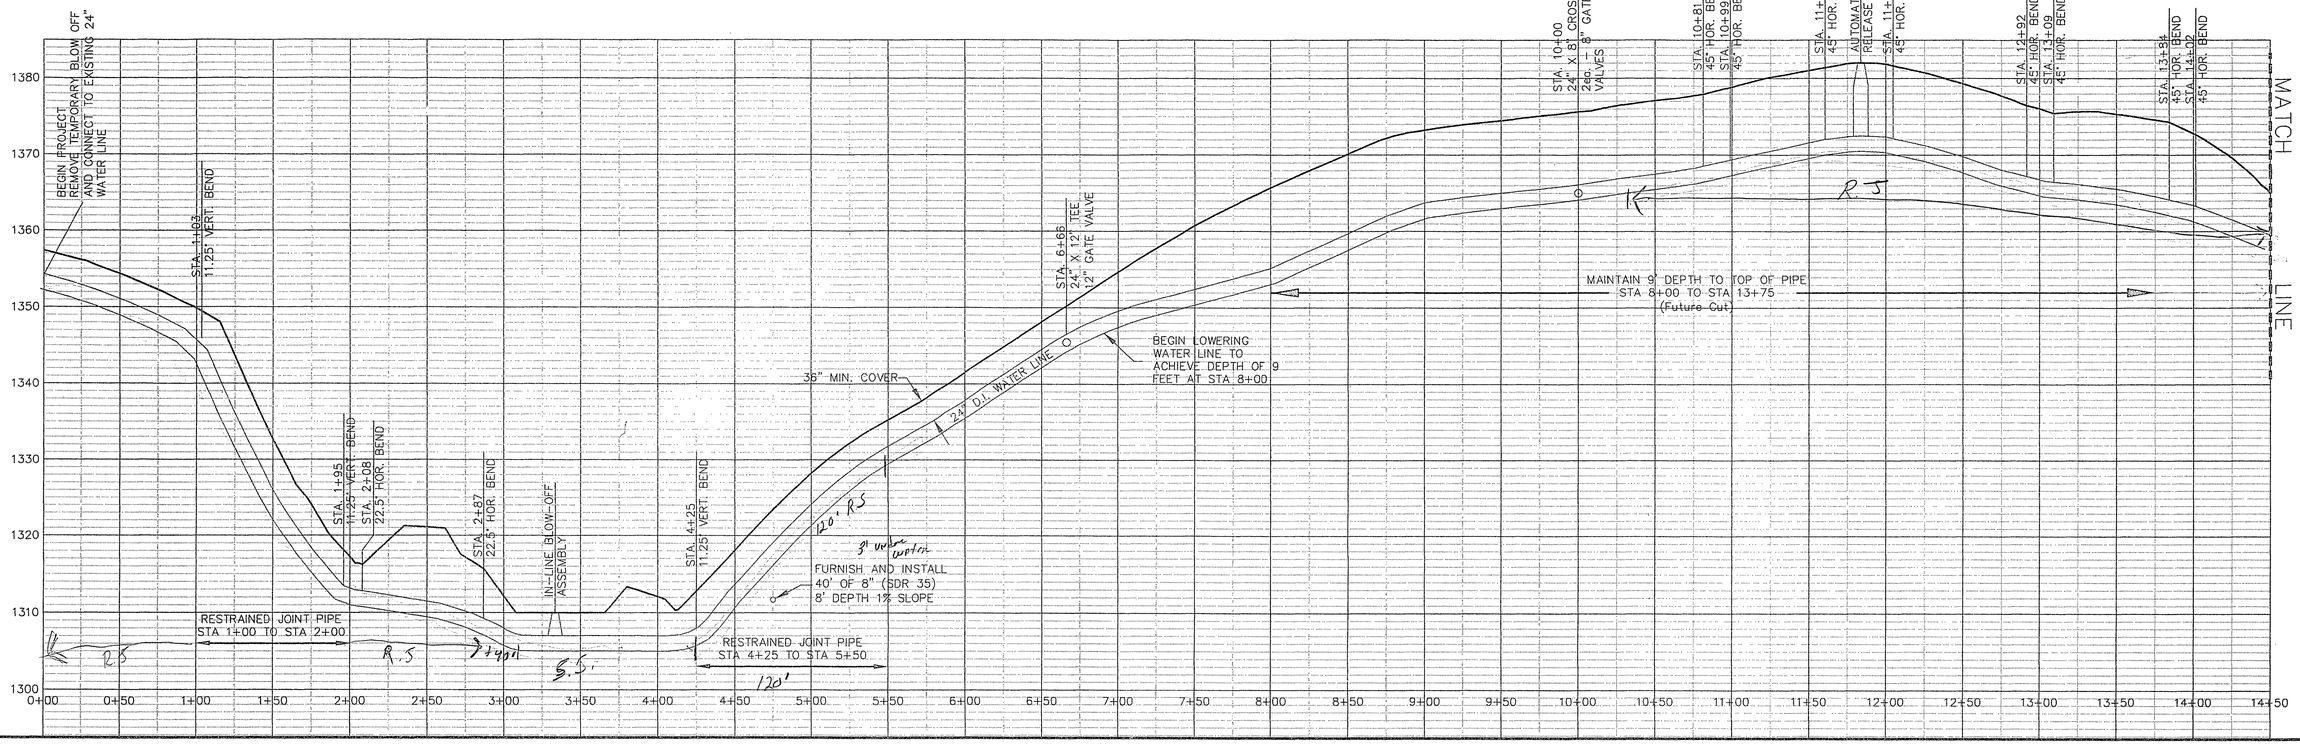

WESTERN VIRGINIA WATER AUTHORITY

ENGINEERING SERVICES
601 SOUTH JEFFERSON STREET
SUITE 300
ROANOKE, VIRGINIA 24011
PHONE: (540) 853-5641

COMMONWEALTH OF VIRGINIA
Roger R. Blankenship
040615
7-21-06
REGISTERED PROFESSIONAL ENGINEER

NORTH LOOP PHASE 5
PLAN & PROFILE

Designed By:	RRB
Drawn By:	RRB
Checked By:	JCR
Date:	06/02/06
Scale:	HOR. 1" = 50' VERT. 1" = 10'
Plan #:	00-00
Sheet:	4 OF 12

SER_CIP_NORTHLOOP_RRB NORTH PAGE 1 - 7/21/2006 8:55:21 AM