



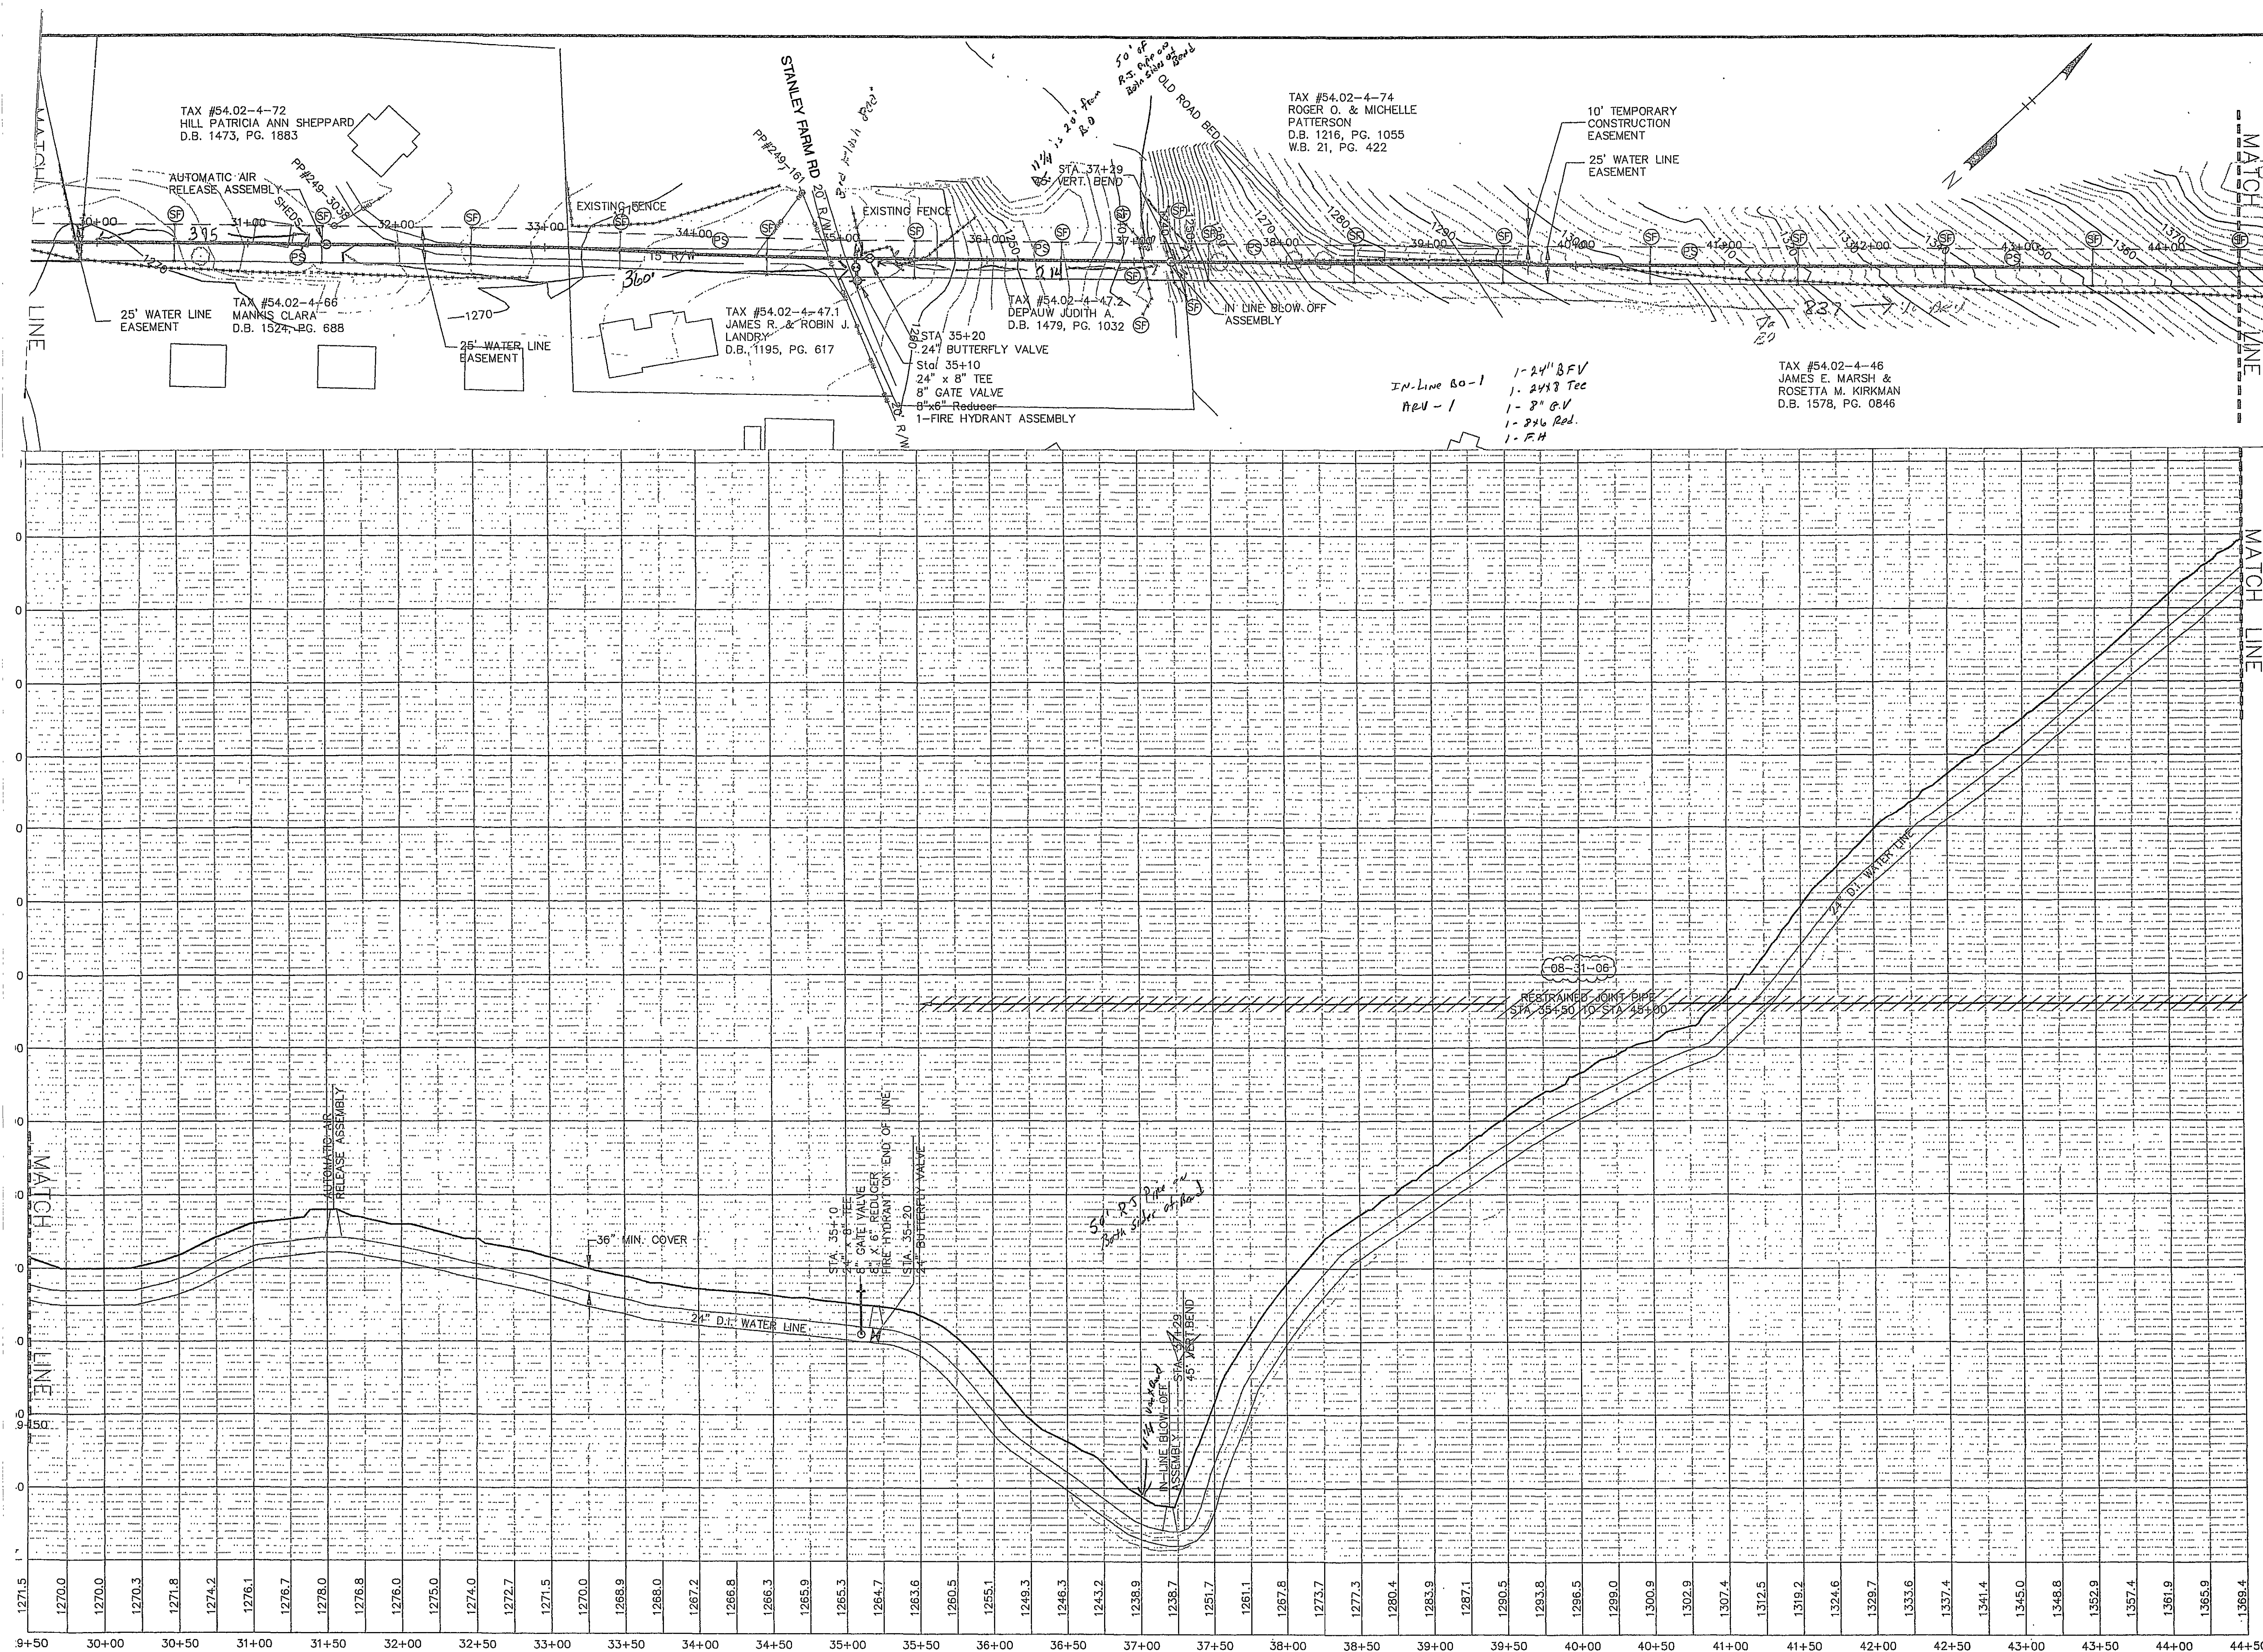

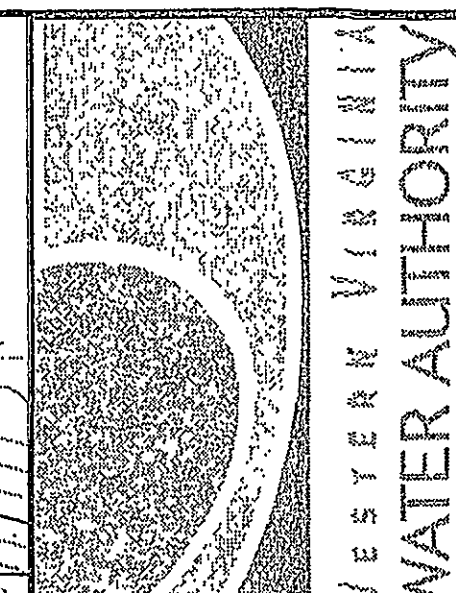

WESTERN VIRGINIA
WATER AUTHORITY

ENGINEERING SERVICES

601 SOUTH JEFFERSON STREET
SUITE 300
ROANOKE, VIRGINIA 24011
PHONE: (540) 853-5641

**NORTH LOOP PHASE 5
PLAN & PROFILE**

Designed By: RRB
Drawn By: RRB
Checked By: JGR
Date: 06/02/06
Scale: HOR. 1" = 50'
VERT. 1" = 10'
Plan #: 00-00
Sheet: 6 OF 12